



Design
Planning
Architecture

66 W. FLAGLER ST. #900
MIAMI, FL 33130
www.thefluxarchitects.com
P: 305.707.8288

Seal of Project Architect

Consultants:
CIVIL ENGINEER
CONENCO CONSULTANTS
782 NW 42ND AVE
MIAMI, FL 33126
T: (888) 536-1536
LANDSCAPE ARCHITECT
PARAMETRIKA LANDSCAPE ARCH.
T: (480) 732-5637

Project Owner:
LOGICA REAL ESTATE SERVICES
8180 NW 36th ST, STE 409
DORAL, FL 33166

Project:
324 HAUS

Project Address:
324 NW 6th ST.
POMPANO BEACH, FL 33060

Project Number:
24012

Sheet Name:
ELEVATIONS

Sheet Origin Date:
04/24/2024

Sheet Issue Date:
12/18/2024

Revisions:

No Description Date

01 COMMENTS/CHANGES 09/10/2024

02 COMMENTS 12/18/2024


Submittal Type:
SITE PLAN REVIEW

Drawn By:
ES

Checked By:
ES


Scale:
AS SHOWN

Sheet Number:
A302

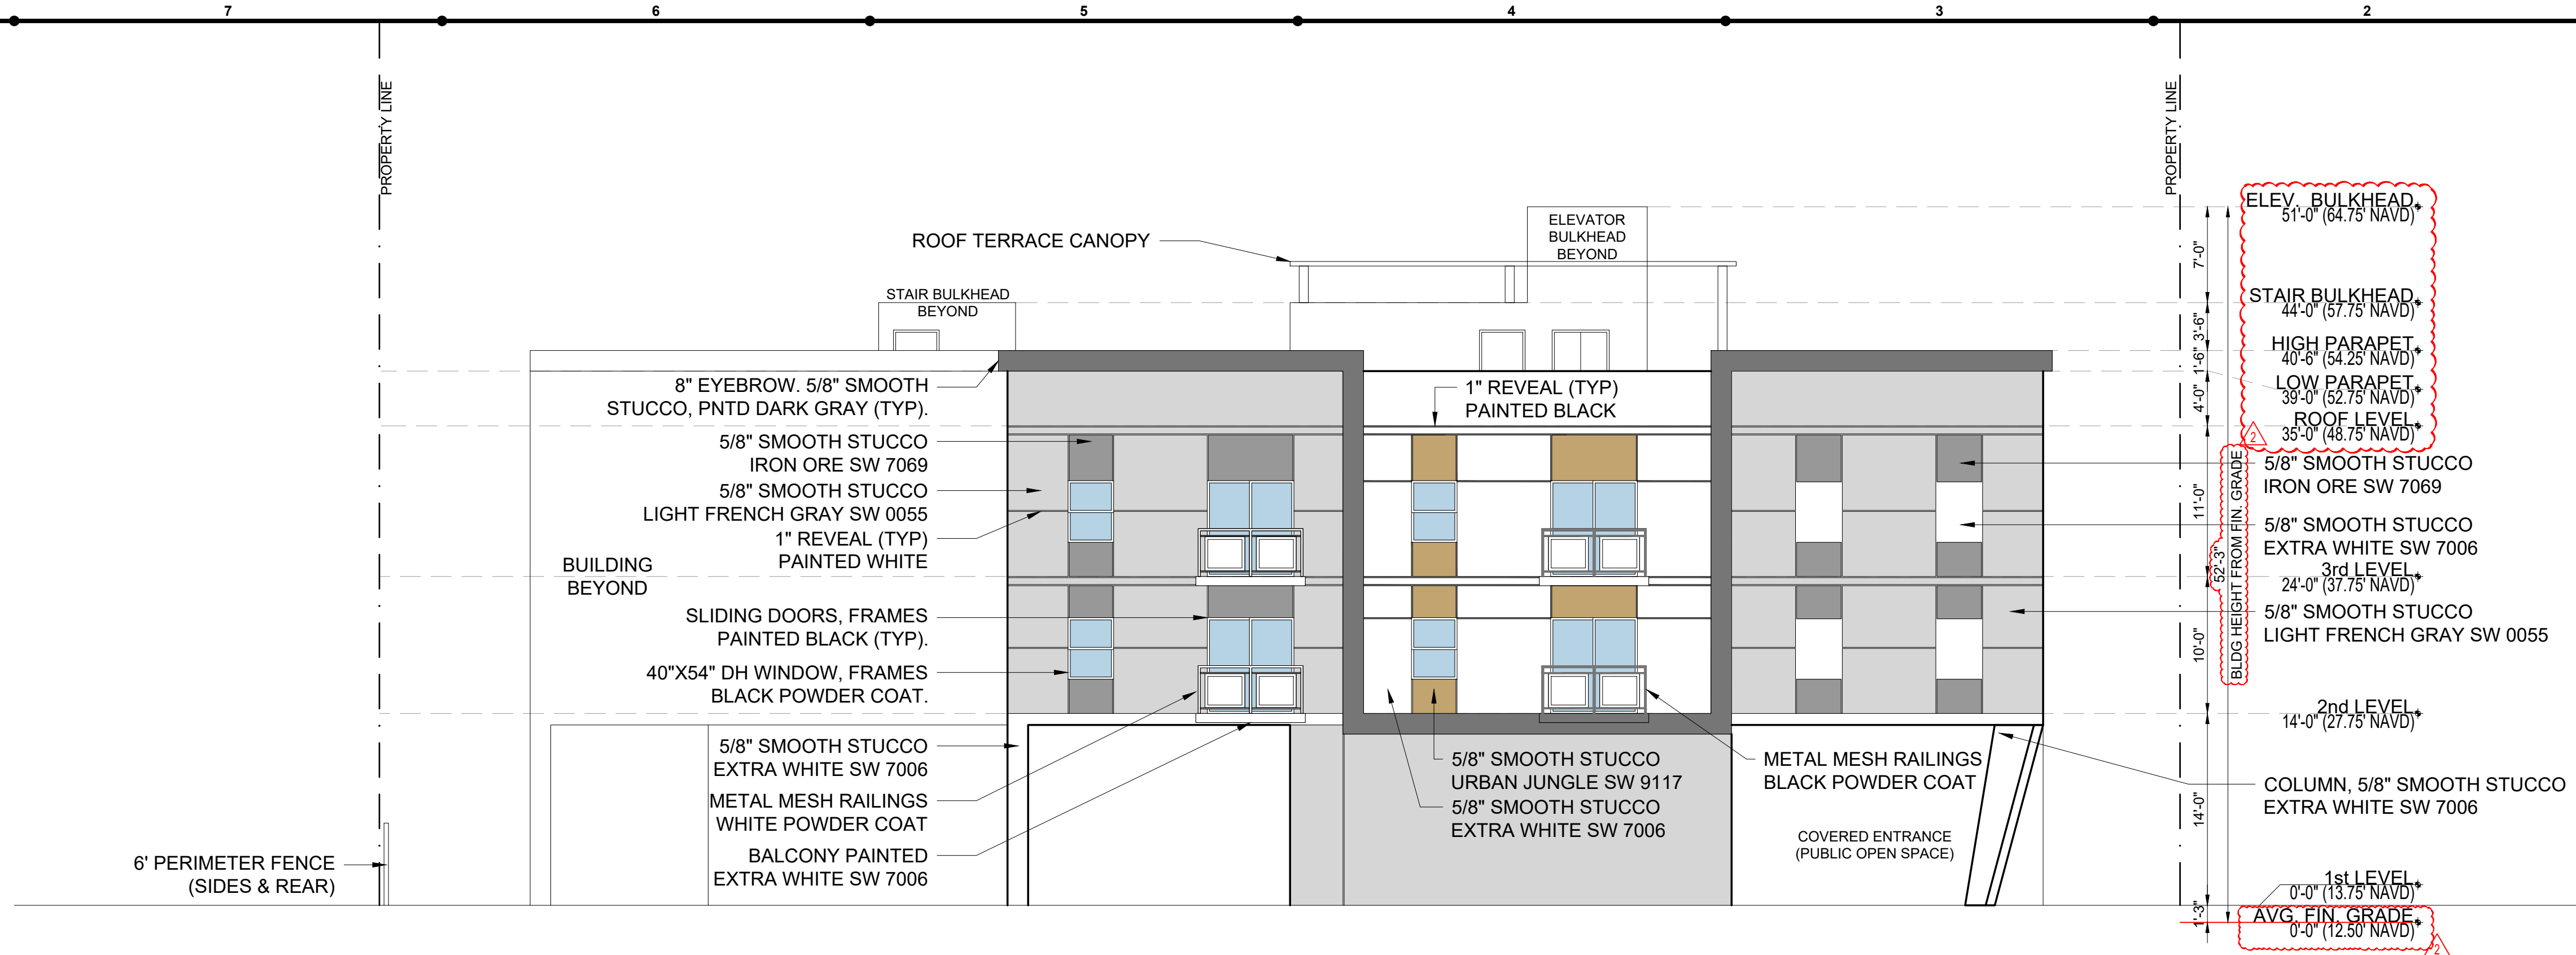

1 EAST ELEVATION

Scale: 1/8" = 1'-0"

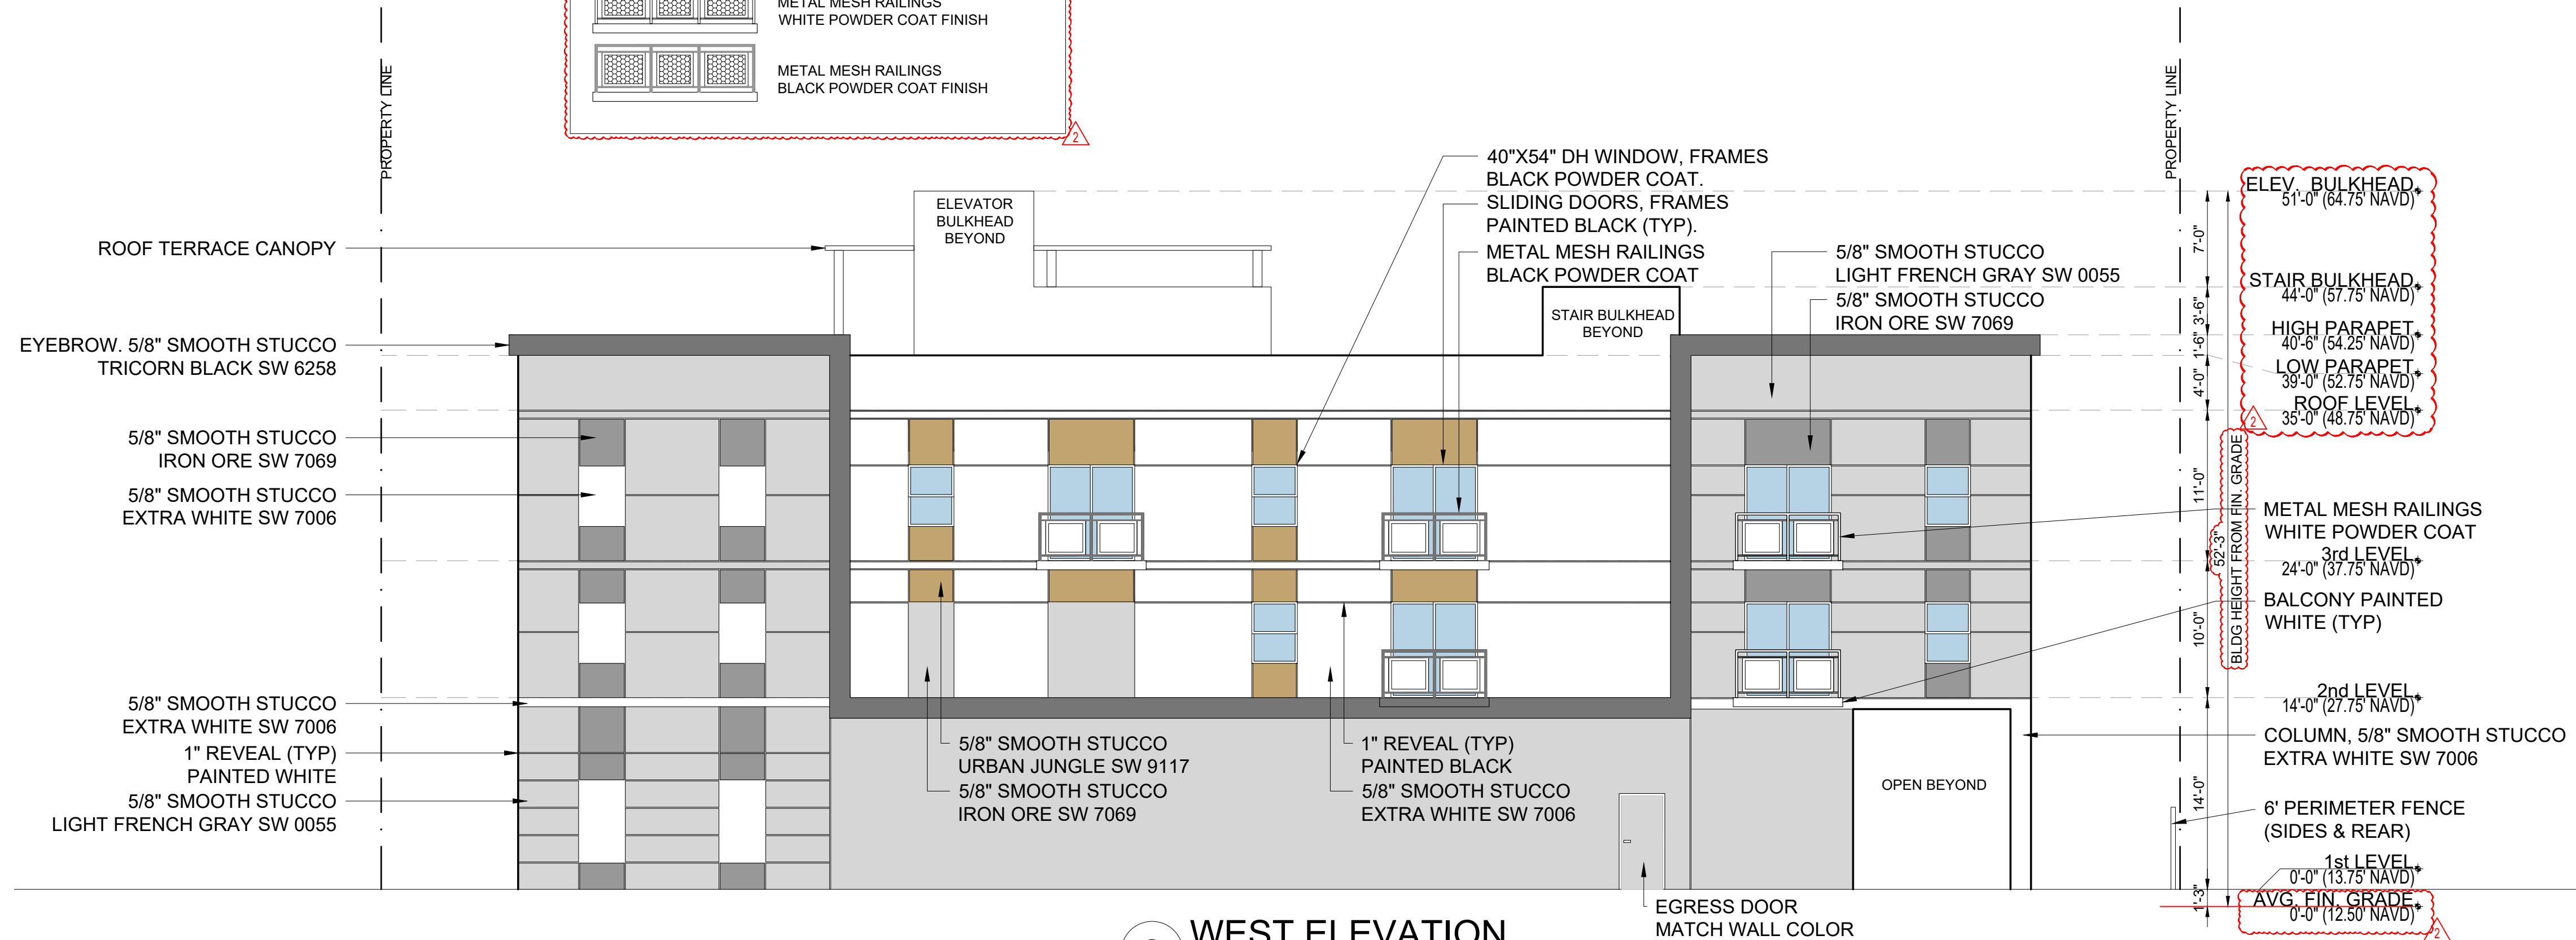

2 WEST ELEVATION

Scale: 1/8" = 1'-0"

DRC

PZ22-12000032

04/02/2025