


☐ INACCESSIBLE ☒ 13KV ☐ FUTURE 23KV ☐ 23KV ☒ SALT SPRAY ☐ NULL

CONSTRUCTION NOTES - WR# 7053905

REQUIRED DRAWINGS  
FOR DRAWINGS & CONSTRUCTION NOTES SEE 7A8G14  
UTILITY CONTACT LIST  
CALL SUNSHINE 1-800-432-4770

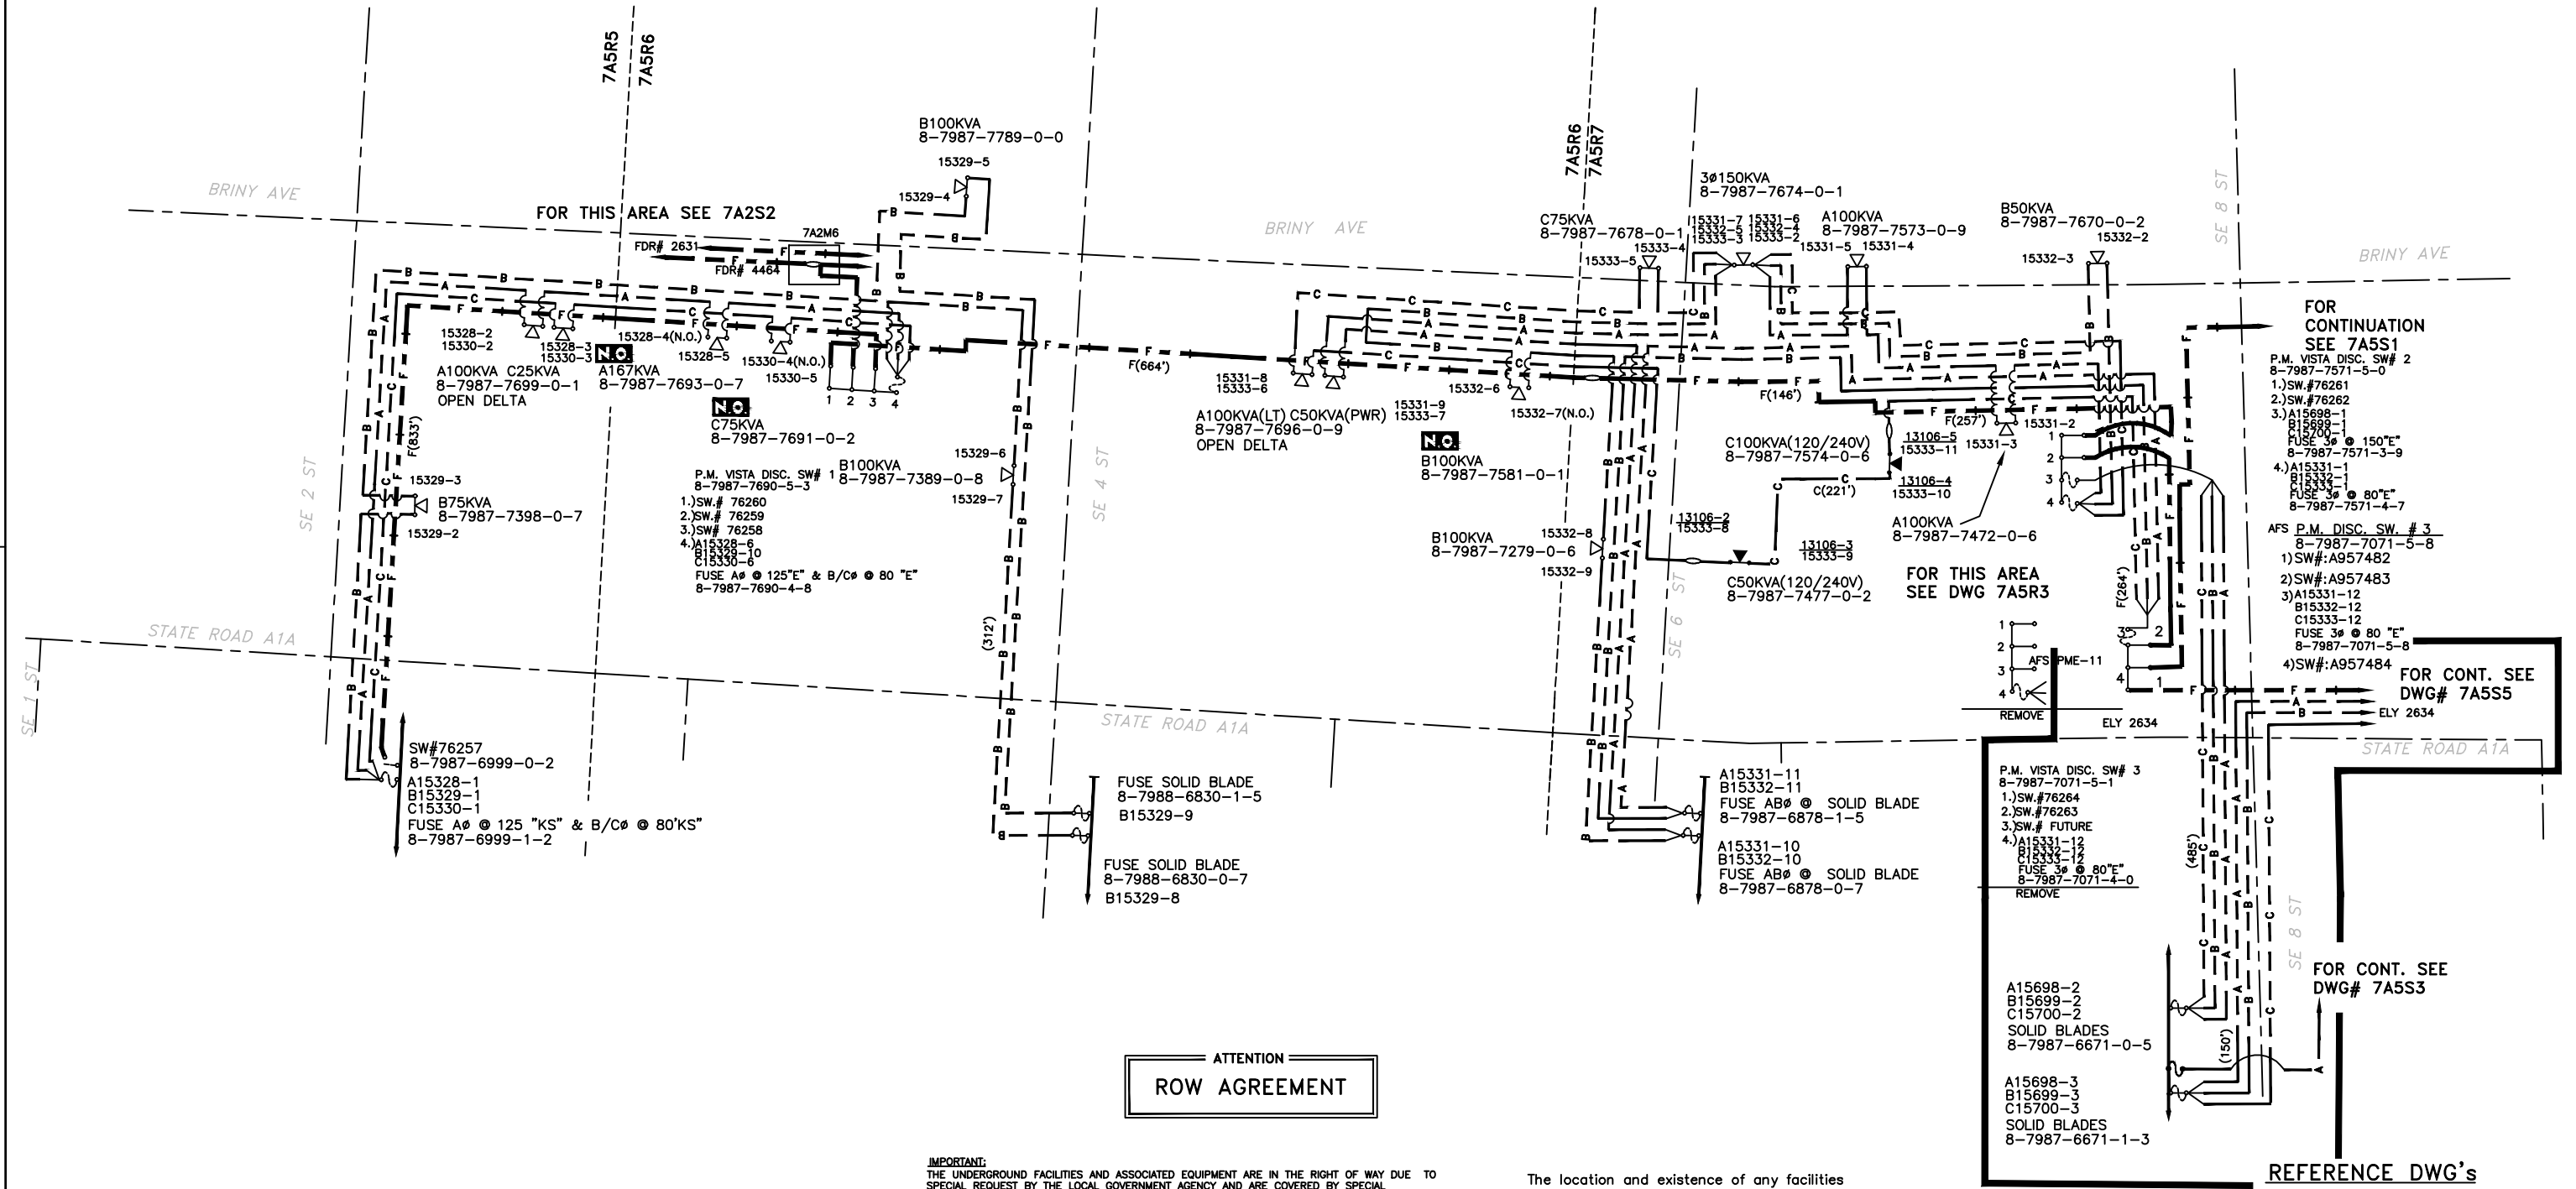

ATTENTION  
ROW AGREEMENT

**IMPORTANT:**  
THE UNDERGROUND FACILITIES AND ASSOCIATED EQUIPMENT ARE IN THE RIGHT OF WAY DUE TO SPECIAL REQUEST BY THE LOCAL GOVERNMENT AGENCY AND ARE COVERED BY SPECIAL AGREEMENT WITH THE LOCAL GOVERNMENT. SHOULD THE LOCAL GOVERNMENT OR OTHER RIGHT OF WAY REQUIRE FPL TO RELOCATE, ADJUST OR REARRANGE ANY OF THESE FACILITIES, AS THEY MAY EXIST INITIALLY OR LATER BE MODIFIED, UPGRADED, OR OTHERWISE ALTERED, THE LOCAL GOVERNMENT SHALL PROVIDE FPL WITH A SUBSTITUTE LOCATION, INCLUDING ANY EASEMENTS THAT MAY BE NECESSARY, AND PAY ANY COSTS FOR THE RELOCATION, ADJUSTMENT, OR REARRANGEMENT. THE LOCAL GOVERNMENT SHALL ALSO REIMBURSE FPL FOR ANY COSTS TO LOCATE, EXPOSE, PROTECT OR SUPPORT THE FACILITIES. IN THE EVENT OF FUTURE CONSTRUCTION OR EXCAVATION IN CLOSE PROXIMITY TO THE FACILITIES, REQUEST A COPY OF THE RIGHT OF WAY AGREEMENT FROM DOC FILES/GO FOR FURTHER DETAILS.

The location and existence of any facilities may not be relied upon by the supplier in responding to a bid or in complying with any contract. Supplier is responsible for evaluating site conditions both above and below ground including underground facility locations.

REFERENCE DWG's

7A5R5 7A5R3  
7A5R6 7A2S2  
7A5R7 7A5S5  
7A5R2 7A8G14

TWNP: 49 RING: 42 SEC: 09 QTR: Q

PLOT DATE: 2/22/2020 PLOT TIME: 3:11:27 PM CAD NAME: JGO

AS-BUILT	AUTH NO.	NO.	DATE	REVISION
	8157820	2	04/17/18	REPLACE SW CAB @LOC 1(8-7987-7071-5-8) WITH AFS SW CABINET
	7053905	1	12/21/16	OH/UG CONVERSION
	4860334	0	06/10/15	PULL PRI/FDR CBLs, INST VISTA CABINETS, INSTALL PMDS, & PMT'S

AS-BUILT COPY	AS-BUILT CREW PRINT
Initials	Foreman's Signature
Job CERTIFIED COMPLETED as shown on this AS-BUILT print. Material changes shown on ROS.	Date
Supervisor's Signature	Date
All required ground rods have been driven & verified to be within FPL standards. Values are shown at all locations.	Date
Foreman's Signature	Date

Easement?	YES <input type="checkbox"/> NO <input type="checkbox"/>	Survey/Stake?	YES <input type="checkbox"/> NO <input type="checkbox"/>	Work with SMO?	YES <input type="checkbox"/> NO <input type="checkbox"/>
Tree Work?	YES <input type="checkbox"/> NO <input type="checkbox"/>	Designer/Stake?	YES <input type="checkbox"/> NO <input type="checkbox"/>	CT/Special Mtr?	YES <input type="checkbox"/> NO <input type="checkbox"/>
Map Posting?	YES <input checked="" type="checkbox"/> NO <input type="checkbox"/>	Trench Feet		Duct Bank Feet	
Posted by		Telephone Request?	YES <input type="checkbox"/> NO <input type="checkbox"/>	CATV Request?	YES <input type="checkbox"/> NO <input type="checkbox"/>



DESIGNED BY	P.C. HARLACHER
DRAWN BY	T. COLLINS
DATE	12/21/16
MAP NO.	Q-0342

M/A: NB
BRINY AVE CONVERSION
BRINY AVE BTWN SE 2 ST & SE 8 ST
POMPANO BEACH/BROWARD COUNTY, FL
DWG NO. 7A5S4
WR: 7053905 IWR: D070-53-905