



# Fire Prevention Fire Hydrant Flow Test



**City of Pompano Beach • Bureau of Fire Prevention**  
**100 West Atlantic Boulevard, Room 220 Pompano Beach, FL 33060**  
 Phone: (954) 786-4695

City of Pompano Beach Fire Prevention will **WITNESS** all fire hydrant flow test that are required for fire flow purposes.

- City of Pompano Beach Code of Ordinances Title IX Chapter 95 Section 95.14(G). Fire hydrant flow tests.
  - The Fire Department shall witness all hydrant flow tests as required for fire protection systems.
  - All fire flow tests shall be in accordance with NFPA 291 and Broward County Amendments F-112.
  - Broward County Amendments F-112(e) - The static pressure at the water main shall be determined by a recorded method for a minimum twenty-four (24) hour period.
  - Morning of fire Hydrant static/residue connection contractor to provide documents of test equipment certification.

**Information:**

Date:	8/12/2024
Company Requesting Flow Test:	Polaris Fire Protection
Contact Name:	Kameron Woodall
Contact Phone Number:	(954)678-3934
Email Address:	kwoodall@poalrisfp.com
Associated Application Number:	N/A
Associated Project Name:	OceanSouth

**Proposed Date/Time for Fire Hydrant Flow Test: (8am – 9am)**

- Request Hydrant Flow Test minimum 72 hours in advance.
- Connection of Fire Hydrant for 24 hour static/residual must be between 0730hrs and 0830hrs.

Requested Date:	8/14/2024	Time:	8:00am
Alternate Date:	8/15/2024	Time:	8:00am

**Fire Hydrant Flow Test Location:**

Hydrant Location - Static/Residual:	1440 SW 31st Ave, Pompano Beach, FL 33069
Hydrant Location - Flow:	1440 SW 31st Ave, Pompano Beach, FL 33069

**Fire Hydrant Flow Test Witness Fee:**

There is a \$150.00 fee for performing each flow test. All tests will be completed within 5 business days. Please include map/sketch showing streets/cross streets & locations of flow and residual fire hydrants. Return flow test application to the Bureau of Fire Prevention with form of payment for \$150.00.

Make check and money orders payable to "CITY OF POMPANO BEACH"  
 If mailing in application with payment send to the address listed below.

**Pompano Beach Fire Prevention**  
**100 W. Atlantic Blvd. – Room 220**  
**Pompano Beach, FL 33060**

NOTE TO TREASURY: Post to 001-0000-367.30-00

<b>Flow Test Equipment Certification:</b>	Yes	No	Date:
---	-----	----	-------

Fire Hydrant Id	Flow Pitot PSI	Flow GPM	Static Pressure 24 hr. Low PSI	Static Pressure Before Flow	Residual PSI During Flow	Tip Size
10102701	85 ps	80 ps				2"
10130605	37	949				
<b>Total Hydrant Flow:</b>						

- Fire Flow Data to be completed and entered on site.
- Fire flow data provided to Fire Prevention at a later date, must be signed/sealed by the Engineer of Record.

Person Conducting Flow Test: \_\_\_\_\_

Fire Inspector Witnessing Flow Test: \_\_\_\_\_

DRC

10002701

85 static rel 90

100 BPC

101 30605-37 Flow @ 949 gpm

**DRC**

PZ24-12000016  
10/16/2024



**Legend**

- |                   |                       |
|-------------------|-----------------------|
| Isolation Valve   | Pump Station          |
| Air Release Valve | Water Storage Tank    |
| Blow Off Valve    | Water Treatment Plant |
| Control Valve     | Casing                |
| Service Meter     | Abandoned Main        |
| Master Meter      | Private Main          |
| Hydrant           | Water Main            |
| Interconnect      |                       |

**Potable Water**

 


Water and Wastewater Services




**Records/Map Request**

Map Date: April 2024



BCWWS Facilities GIS information comes from a combination of field observations, record drawings and inherited maps from private utilities. Mission critical data should be field verified. Broward County assumes no liability for damages arising from errors or omissions.

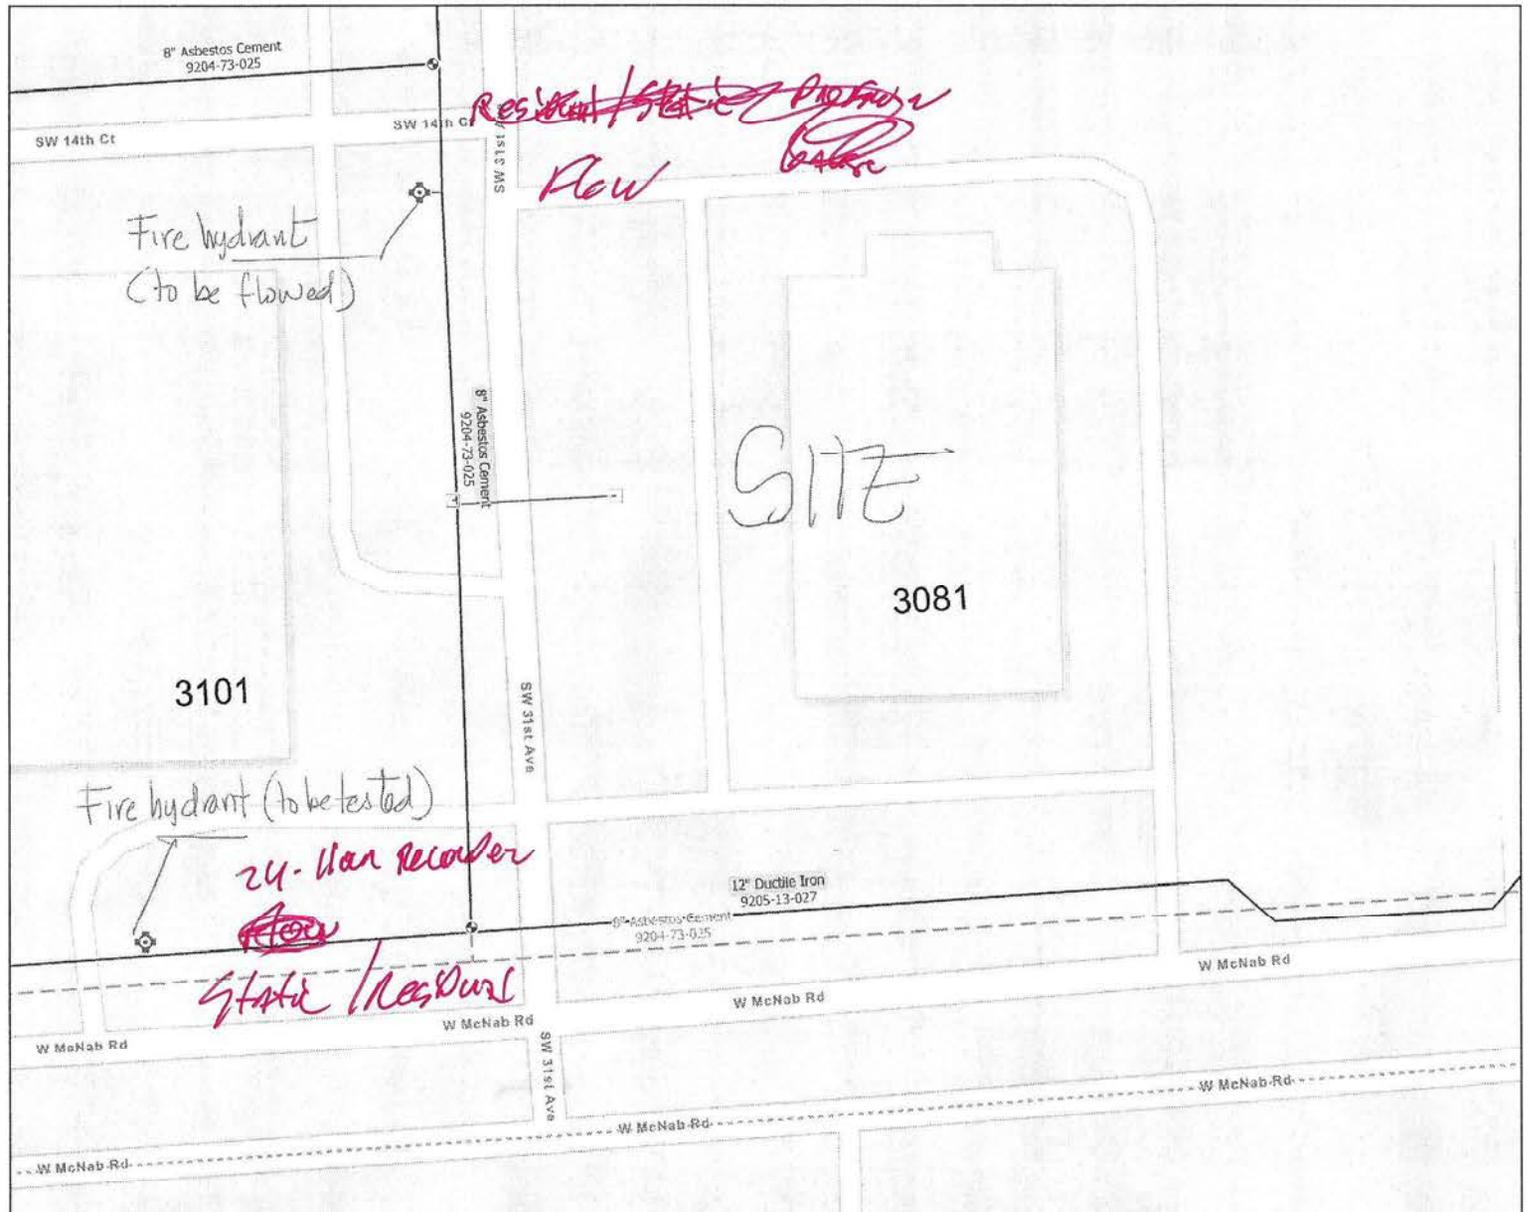


**DRC**

PZ24-1200016

/ SN 19107080

8/14/2024 15 7 : 32 : 23 - 8/15/2024 15 8 : 38 : 23

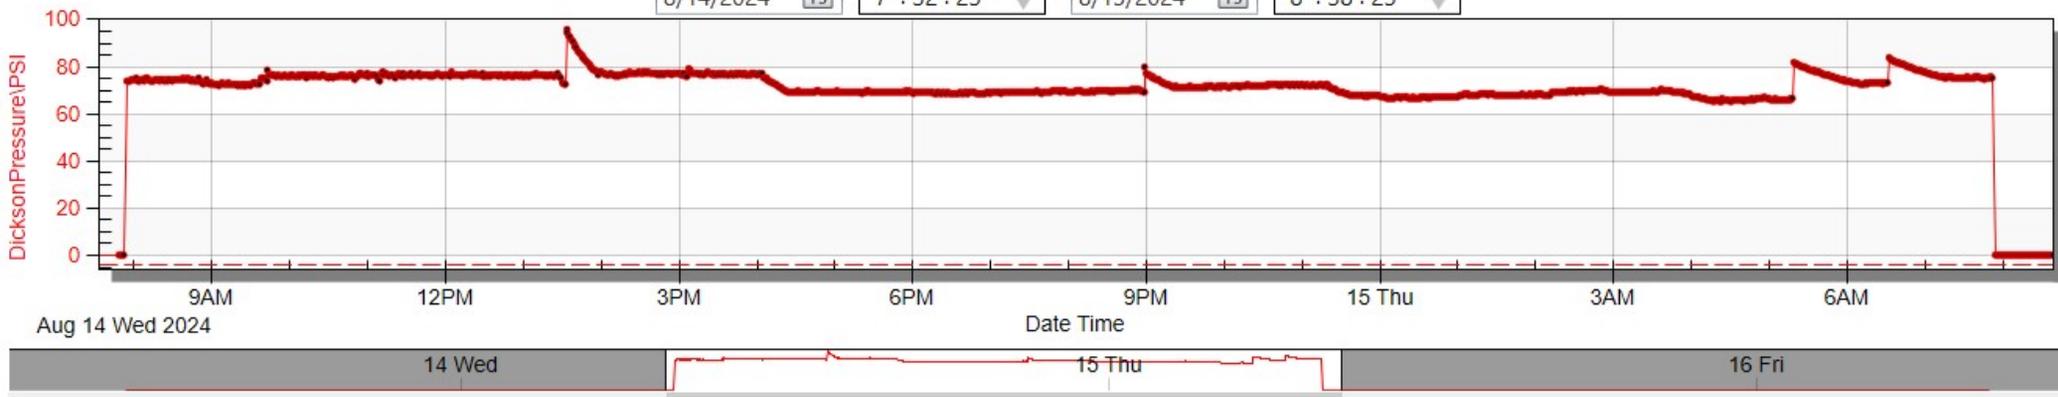

**DRC**

PZ24-12000016