


AS BUILT FLOOR PLAN

SCALE: 3/16" = 1'-0"

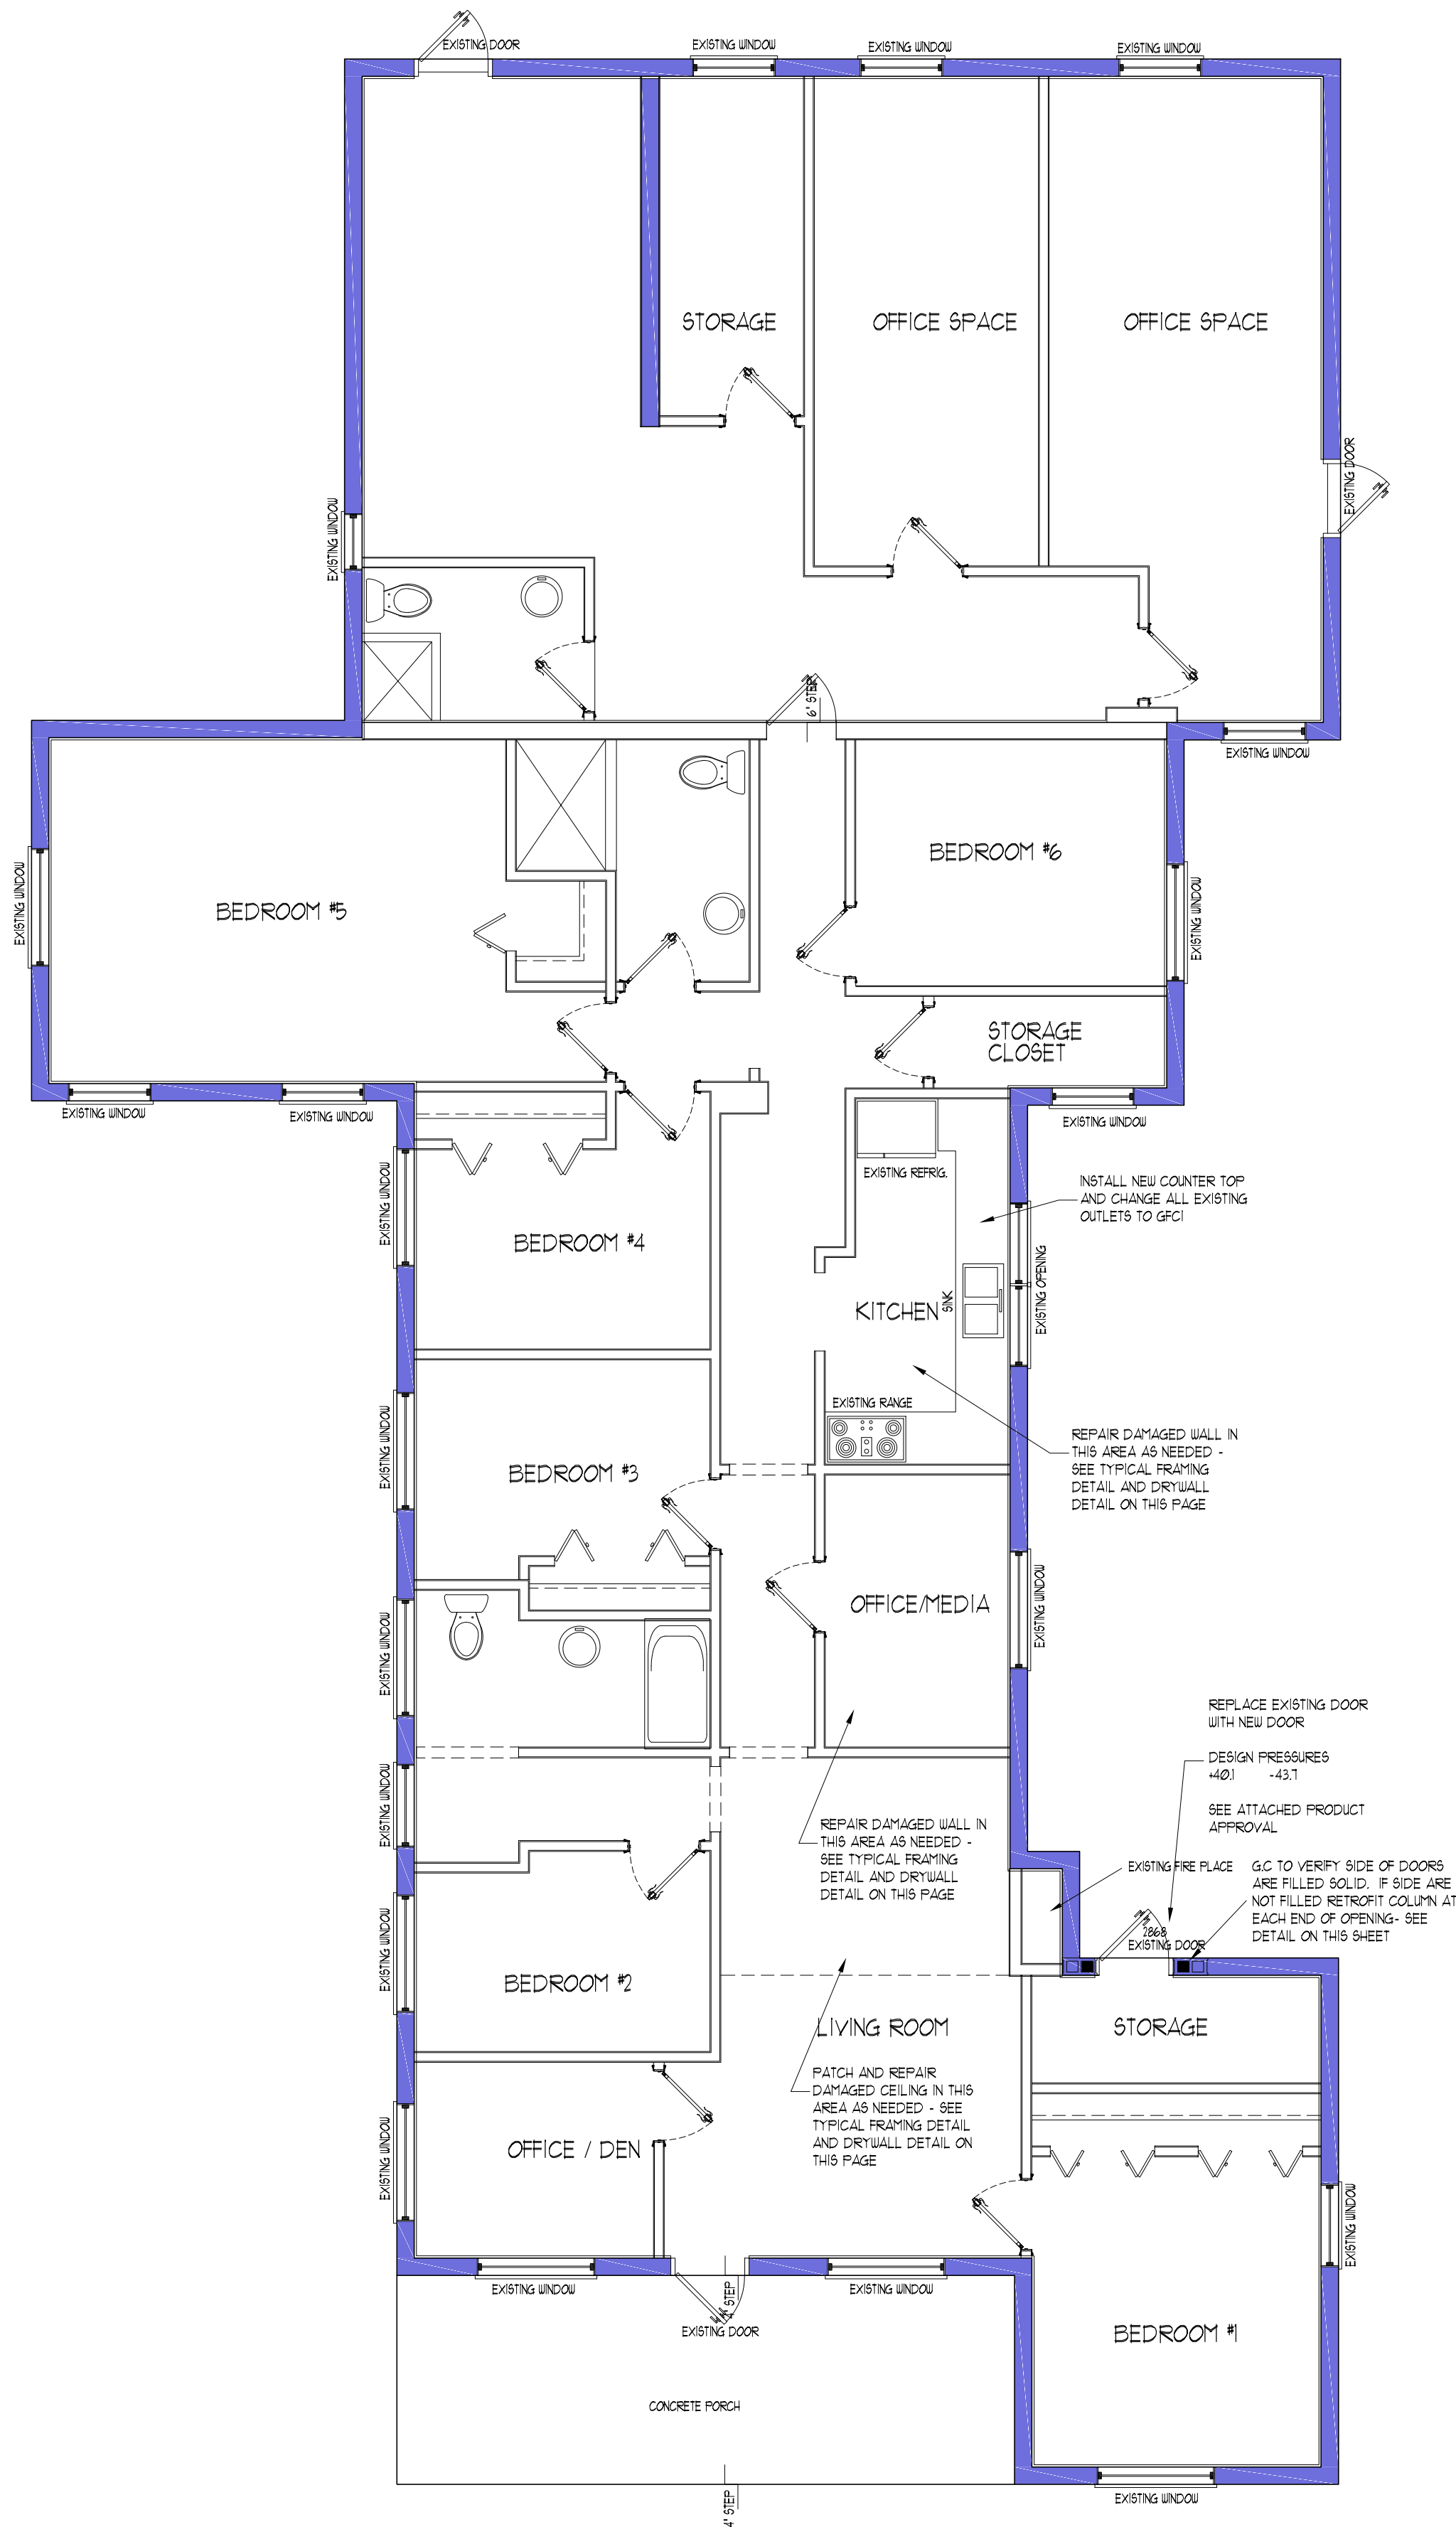


AREA BREAKDOWN

SCALE: NTS

AREA BREAKDOWN	
RESIDENTIAL AREA	2,170 sq. ft.
COMMERCIAL / OFFICE AREA	786 sq. ft.
TOTAL AREA	2,956 SQ. FT.


DRYWALL INSTALLATION DETAIL

SCALE: NTS

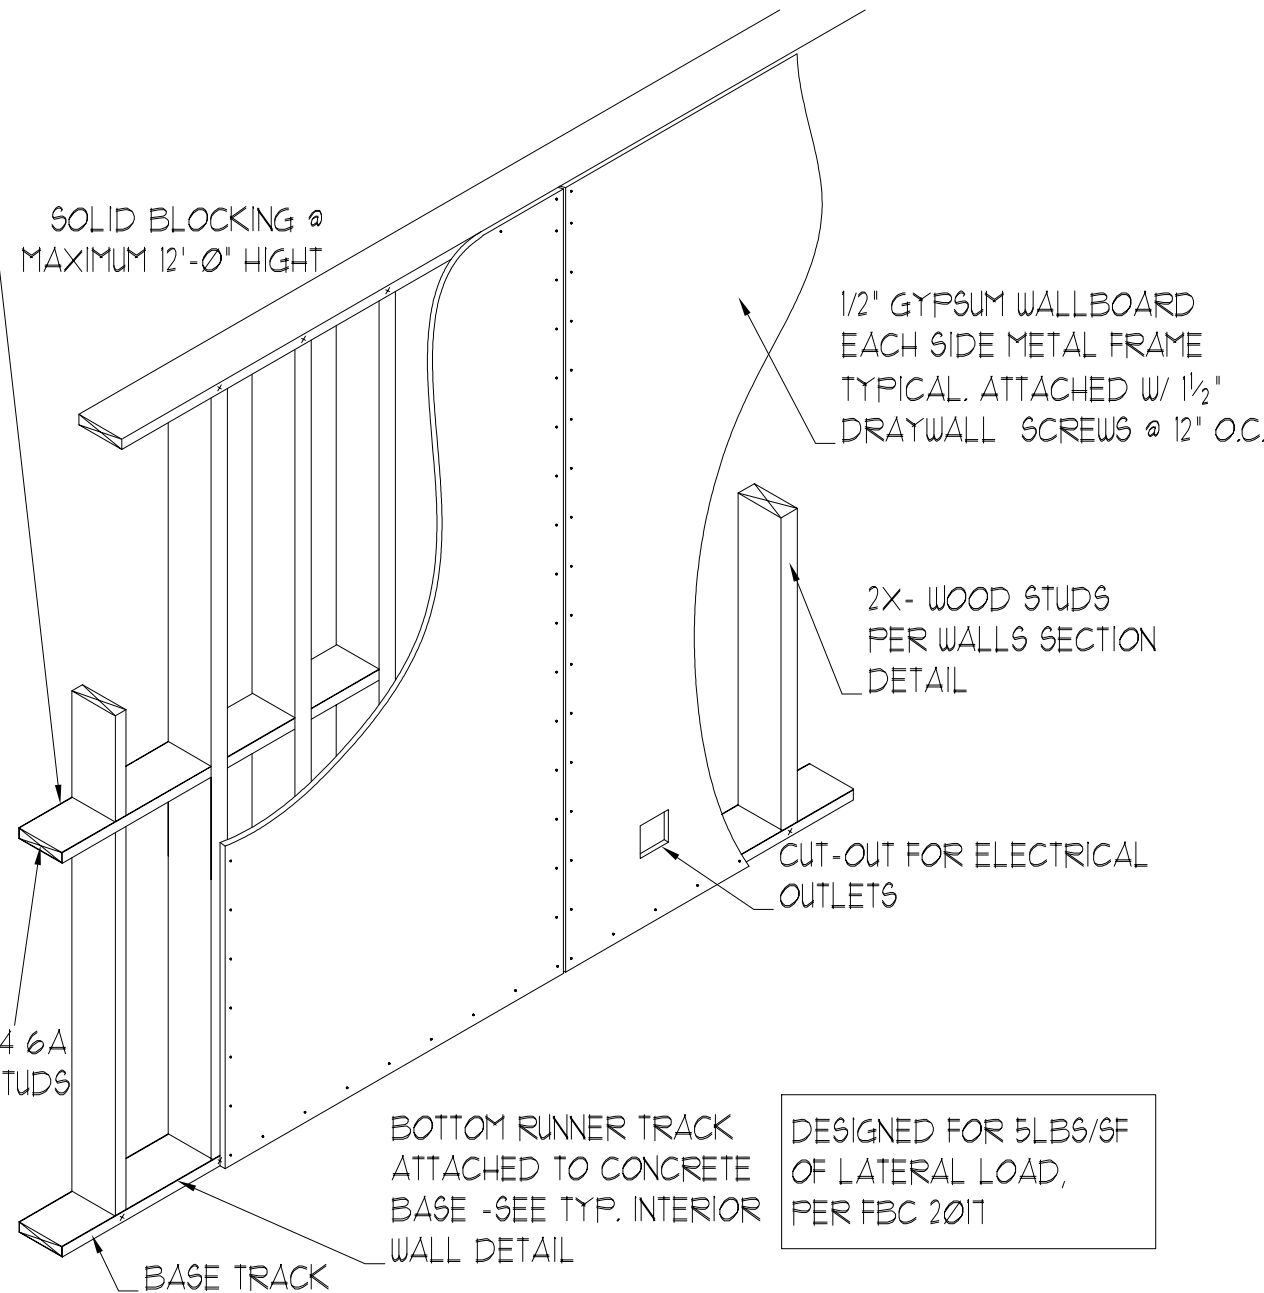

RETROFIT COLUMN DETAIL

SCALE: NTS

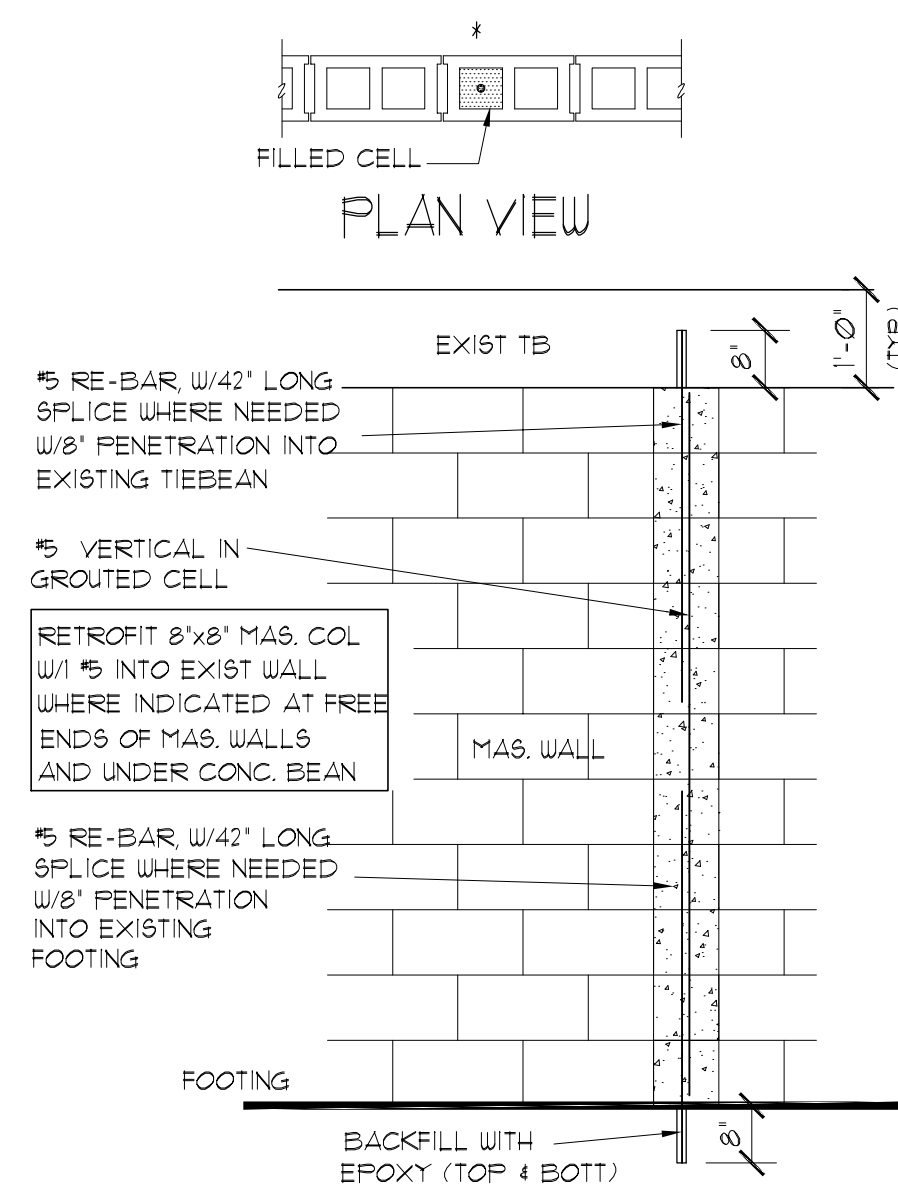


RETROFIT 8"x8" MASONRY COLUMN

\* = REPLACEMENT AS INDICATED ON FOUNDATION PLAN

DOOR BUCK DETAIL

SCALE: NTS

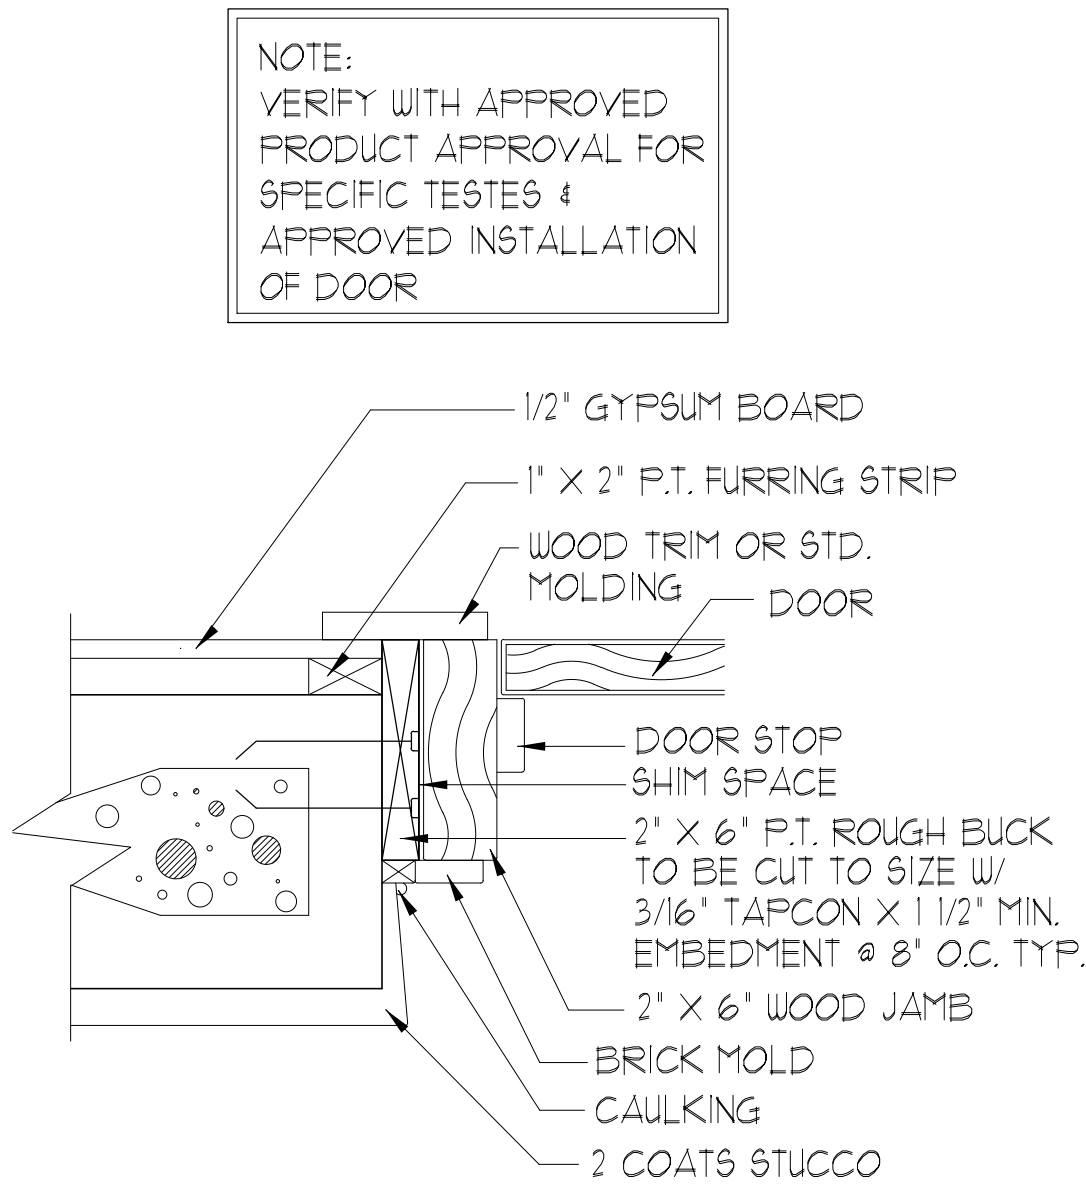


DOOR BUCK DETAIL

N.T.S.

TYPICAL FRAMING DETAILS

SCALE: NTS

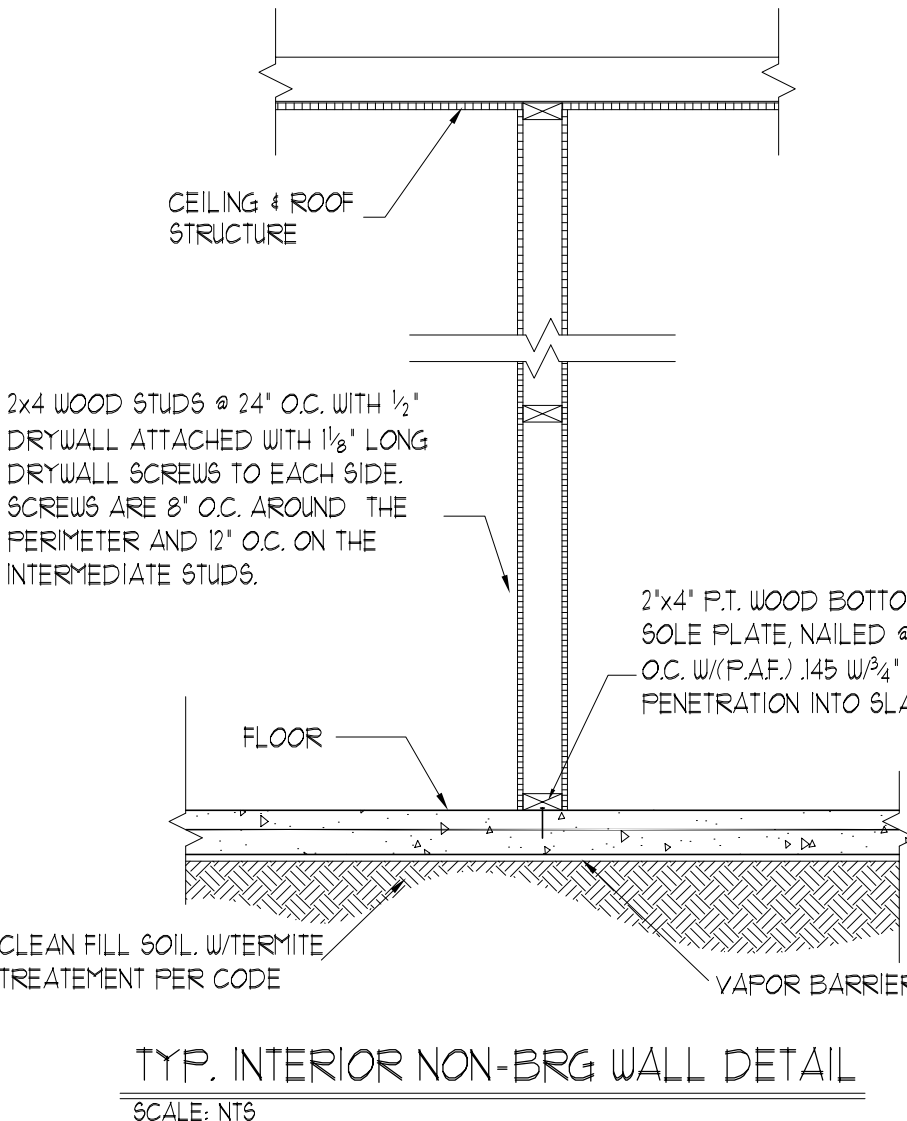

REVISIONS	BY

DANIEL F BRABLEC, ARCHITECT

9045 LaFONTANA BLVD.  
BOCA RATON, FLA. 33434  
(561) 479 - 2388 (561) 451 8589 fax.  
AR 0012526

AS BUILT AND PROPOSED REPAIR FOR

124 NW 12 STREET

124 NW 12th STREET

POMPANO BEACH, FLORIDA 33060

DRAWN FDS, INC. CHECKED	DATE 3-3-2021
SCALE AS NOTED	SHEET 001-21
SHEETS	

**DRC**  
PZ21-05000010  
5/5/2021