


ELECTRICAL POWER PLAN

SCALE: 1/4" = 1'-0"

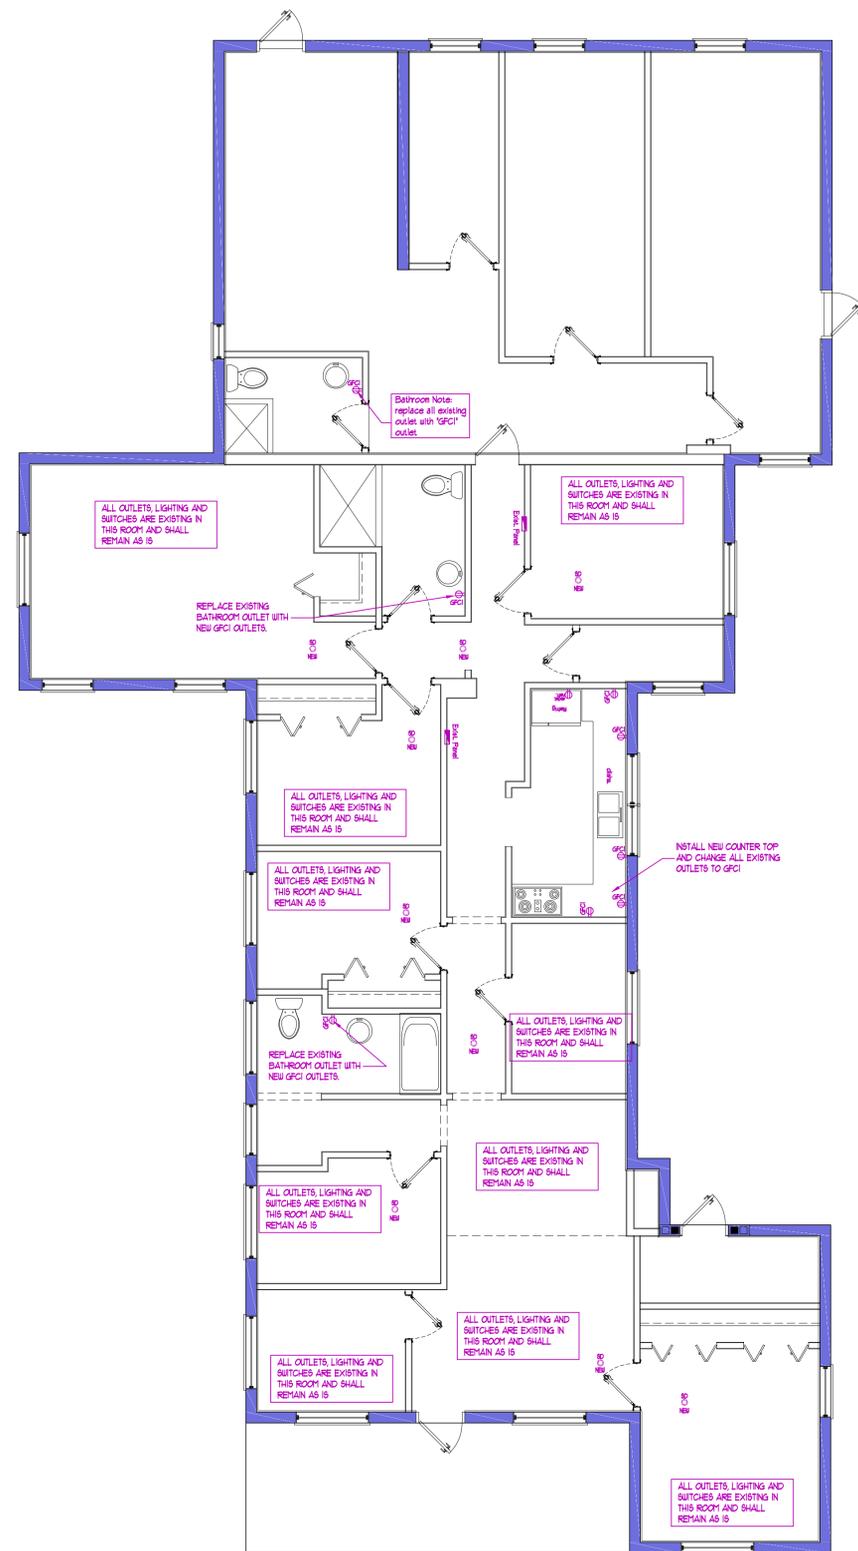

ELECTRICAL NOTES

SCALE: NT5

SMOKE DETECTOR NOTES:
 HARD WIRED SMOKE DETECTORS ARE REQUIRED OUTSIDE OF ALL SLEEPING AREAS, INSTALLED IN THE VICINITY OF THE BEDROOMS.
 MIN. 10 YEAR SEALED BATTERY TYPE SMOKE DETECTOR CAN BE USED FOR RENOVATION
 This residence is not equipped with smoke detectors in accordance to code standards.
 Contractor shall install new battery operated smoke detector (min. 10 yrs sealed battery) at each bedroom and outside bedroom as shown

ELECTRICAL LEGEND

SCALE: NT5

ELECTRICAL LEGEND			
	SINGLE RECEPTACLE OUTLET		INTERCOM SPEAKER
	DUPLEX RECEPTACLE OUTLET		STEREO CONTROL
	WEATHERPROOF DUPLEX OUTLET		TELEPHONE OUTLET
	WEATHERPROOF GFI DUPLEX OUTLET		CEILING EXHAUST FAN W/LIGHT
	RECESS LIGHT (HI-HAT)		SINGLE POLE SWITCH
	SPEAKER DROP (SEE PL. FOR LOCATION)		THREE-WAY SWITCH
	230 VOLT OUTLET		FOUR-WAY SWITCH
	GFI DUPLEX RECEPTACLE OUTLET		DIMMER SWITCH
	SPLIT-WIRED DUPLEX RECEPTACLE OUTLET		CEILING LIGHT FIXTURE
	DISCONNECT		WALL MOUNTED LAMP
	ELECTRICAL METER		WATERPROOF WALL LAMP
	MAIN DISCONNECT		DOOR BELL BUTTON
	FLOOR OUTLET		DOOR BELL CHIME
	COMBO CARBON MONOXIDE & SMOKE DETECTOR WITH BATTERY BACKUP		ELECTRICAL PANEL
			CEILING FAN (J BOX ONLY)
			SECURITY SPOT LAMPS

REVISIONS	BY

DANIEL F BRABLEC, ARCHITECT
 9045 LaFONTANA BLVD.
 BOCA RATON, FLA. 33434
 (561) 479 - 2388 (561) 451 8589 fax.
 AR 0012526

DANIEL F BRABLEC
 ARCHITECT
 AR 0012526

ELECTRICAL SCOPE AND DETAILS

ISOLATED GROUND RECEPTACLE DETAIL

HOT CONDUCTOR

PROVIDE SEPARATE NEUTRAL CONDUCTOR FOR EACH CIRCUIT WHERE NOTED

CONDUIT

20 AMP, 125 VOLT DUPLEX ISOLATED GROUND RECEPTACLE

ISOLATED GROUND CONDUCTOR - CONTINUOUS TO PANEL

1'-6" MIN

4'-0"

3'-8"

4'-2"

6'-8"

1'-6" MIN

4'-0"

6'-0"

ELECTRICAL SCOPE AND NOTE

- 1- INSTALL GFCI OUTLETS AT KITCHEN AND BATHROOMS
- 2- INSTALL RETROFIT SMOKE DETECTORS AT BEDROOMS AND OUTSIDE OF BEDROOMS - USE MIN. 10 YRS SEALED BATTERY TYPE SMOKE DETECTOR
- 3- REPLACE FIXTURES AS NEEDED
- 4- ELECTRICAL SERVICE IS EXISTING AND WILL REMAIN AS IS
- 5- ELECTRICAL CONTRACTOR SHALL VERIFY THAT 'OCP' ARE INSTALLED

TOTAL LOAD CALCULATION = UNCHANGED

Exist. AMPS

DEVICES SCHEDULE

- (A) RECEPTACLE OUTLET (DUPLEX OR QUAD)
- (B) LIGHT SWITCH
- (C) THERMOSTAT (WHERE APPLICABLE)
- (D) EMERGENCY FLASHING STATION (STROBE LIGHT)
- (E) PHONE/DATA COMBINATION
- (F) WALL PHONE OUTLET
- (G) MICROWAVE OUTLET (WHERE APPLICABLE)
- (H) MANUAL PULL STATION (FIRE ALARM)

AS BUILT AND PROPOSED REPAIR FOR
 124 NW 12 STREET
 124 NW 12th STREET
 POMPANO BEACH, FLORIDA 33060

DRAWN FDS, INC. CHECKED
DATE 3-3-2021
SCALE AS SHOWN
SHEET NO. 002-21
SHEET

DRC

PZ21-0500010

5/5/2021

SHEET 6