


EXISTING BUILDING FLOOR AREA SUMMARY		
	OFFICE USE (SF)	STORAGE USE (SF)
FIRST FLOOR	0	7370
SECOND FLOOR	4077	0
BUILDING TOTAL	4077	7370

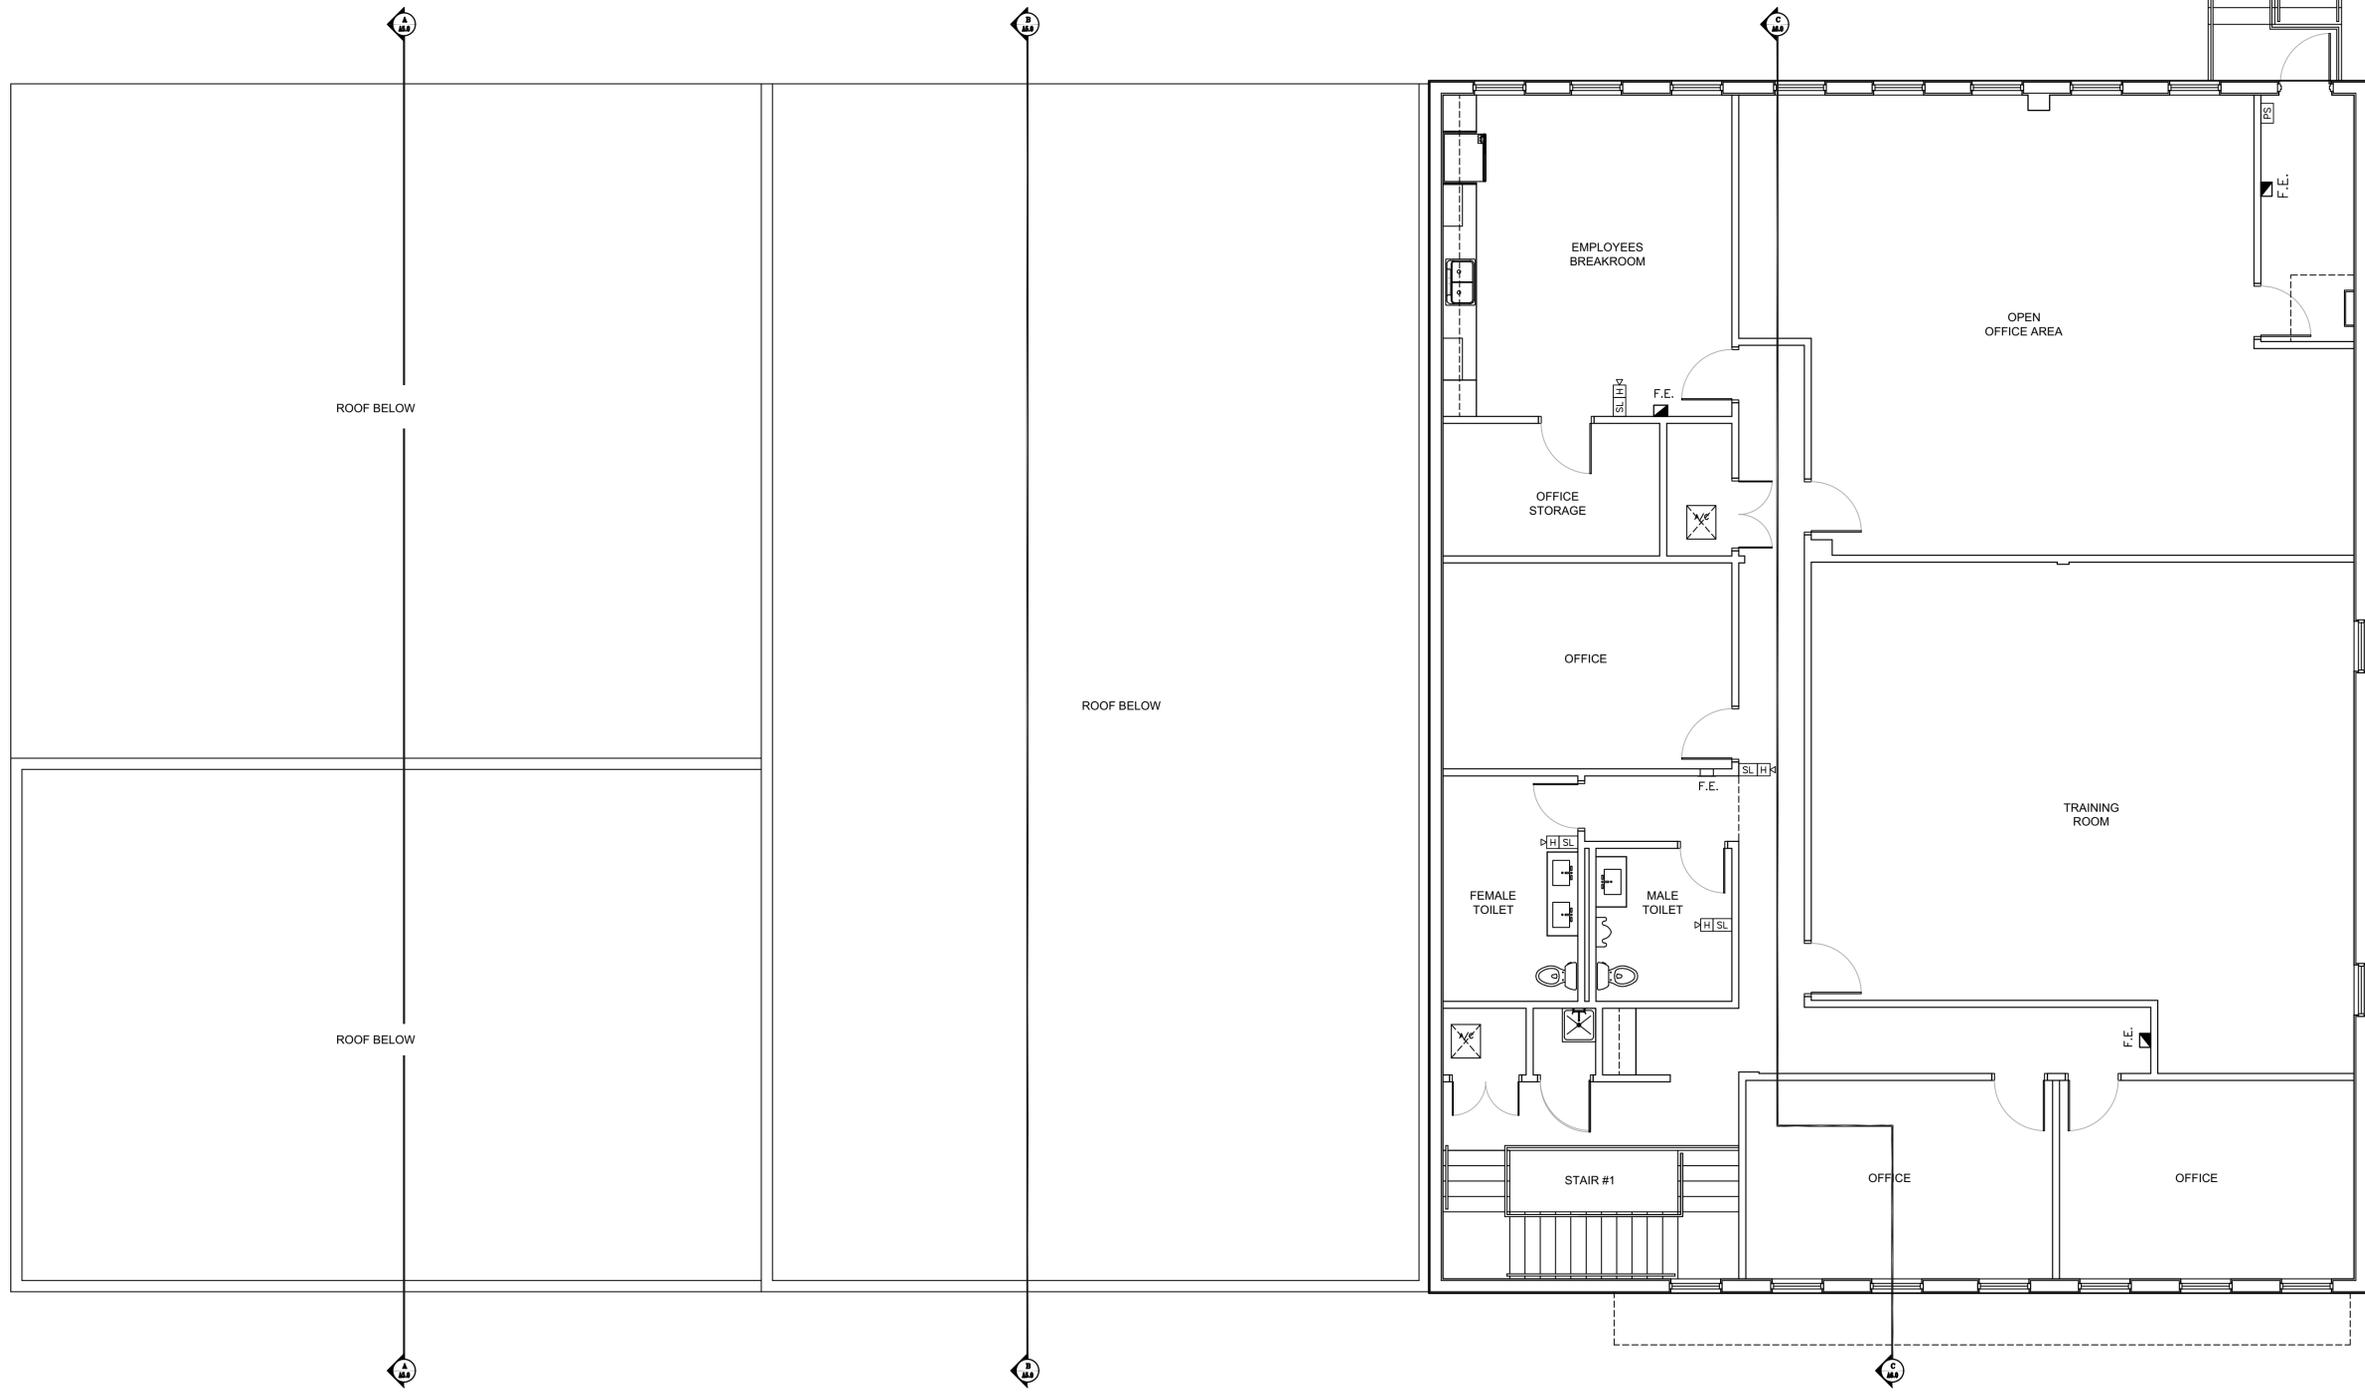

**EXISTING SECOND FLOOR PLAN**

SCALE: 1/4" = 1'-0"



**EXISTING U-HAUL FACILITY # 788000  
AS-BUILT PLANS  
OWNER: UHAUL CO  
790 SW 12th Ave, Pompano Beach, FL 33069**

JORGE FIALLO  
FLORIDA P.E. #65527  
Drawings not valid unless Signed, Sealed  
and Dated by a Registered Professional

NO.	REVISIONS	DATE

JOB NUMBER:  
**21-400-00614**

ISSUE DATE: January, 2021  
DRAWN BY: T.M.  
CHECKED BY: J. FIALLO  
ISSUE:  

SECOND FLOOR PLAN

**A-2.0**

SHEET NUMBER