


[illegible]

PALM AIRE TOWNHOMES  
ALTA/NSPS LAND TITLE SURVEY

The image shows a circular surveyor's seal for David P. Lindley, State of Florida, License No. 5005. To the right of the seal is a digital signature block with the following text: "Digitally signed by David Lindley", "Date: 2023.11.27", "17:29:18 -05'00'", "Adobe Acrobat", "version: 2017.011.30142". Below the seal and signature block, the text "DAVID P. LINDLEY", "REGISTERED LAND", "SURVEYOR NO. 5005", "STATE OF FLORIDA", and "L.B. 3591" is displayed.

OB # 10564  
T.NO. 3  
OF 4 SHEETS

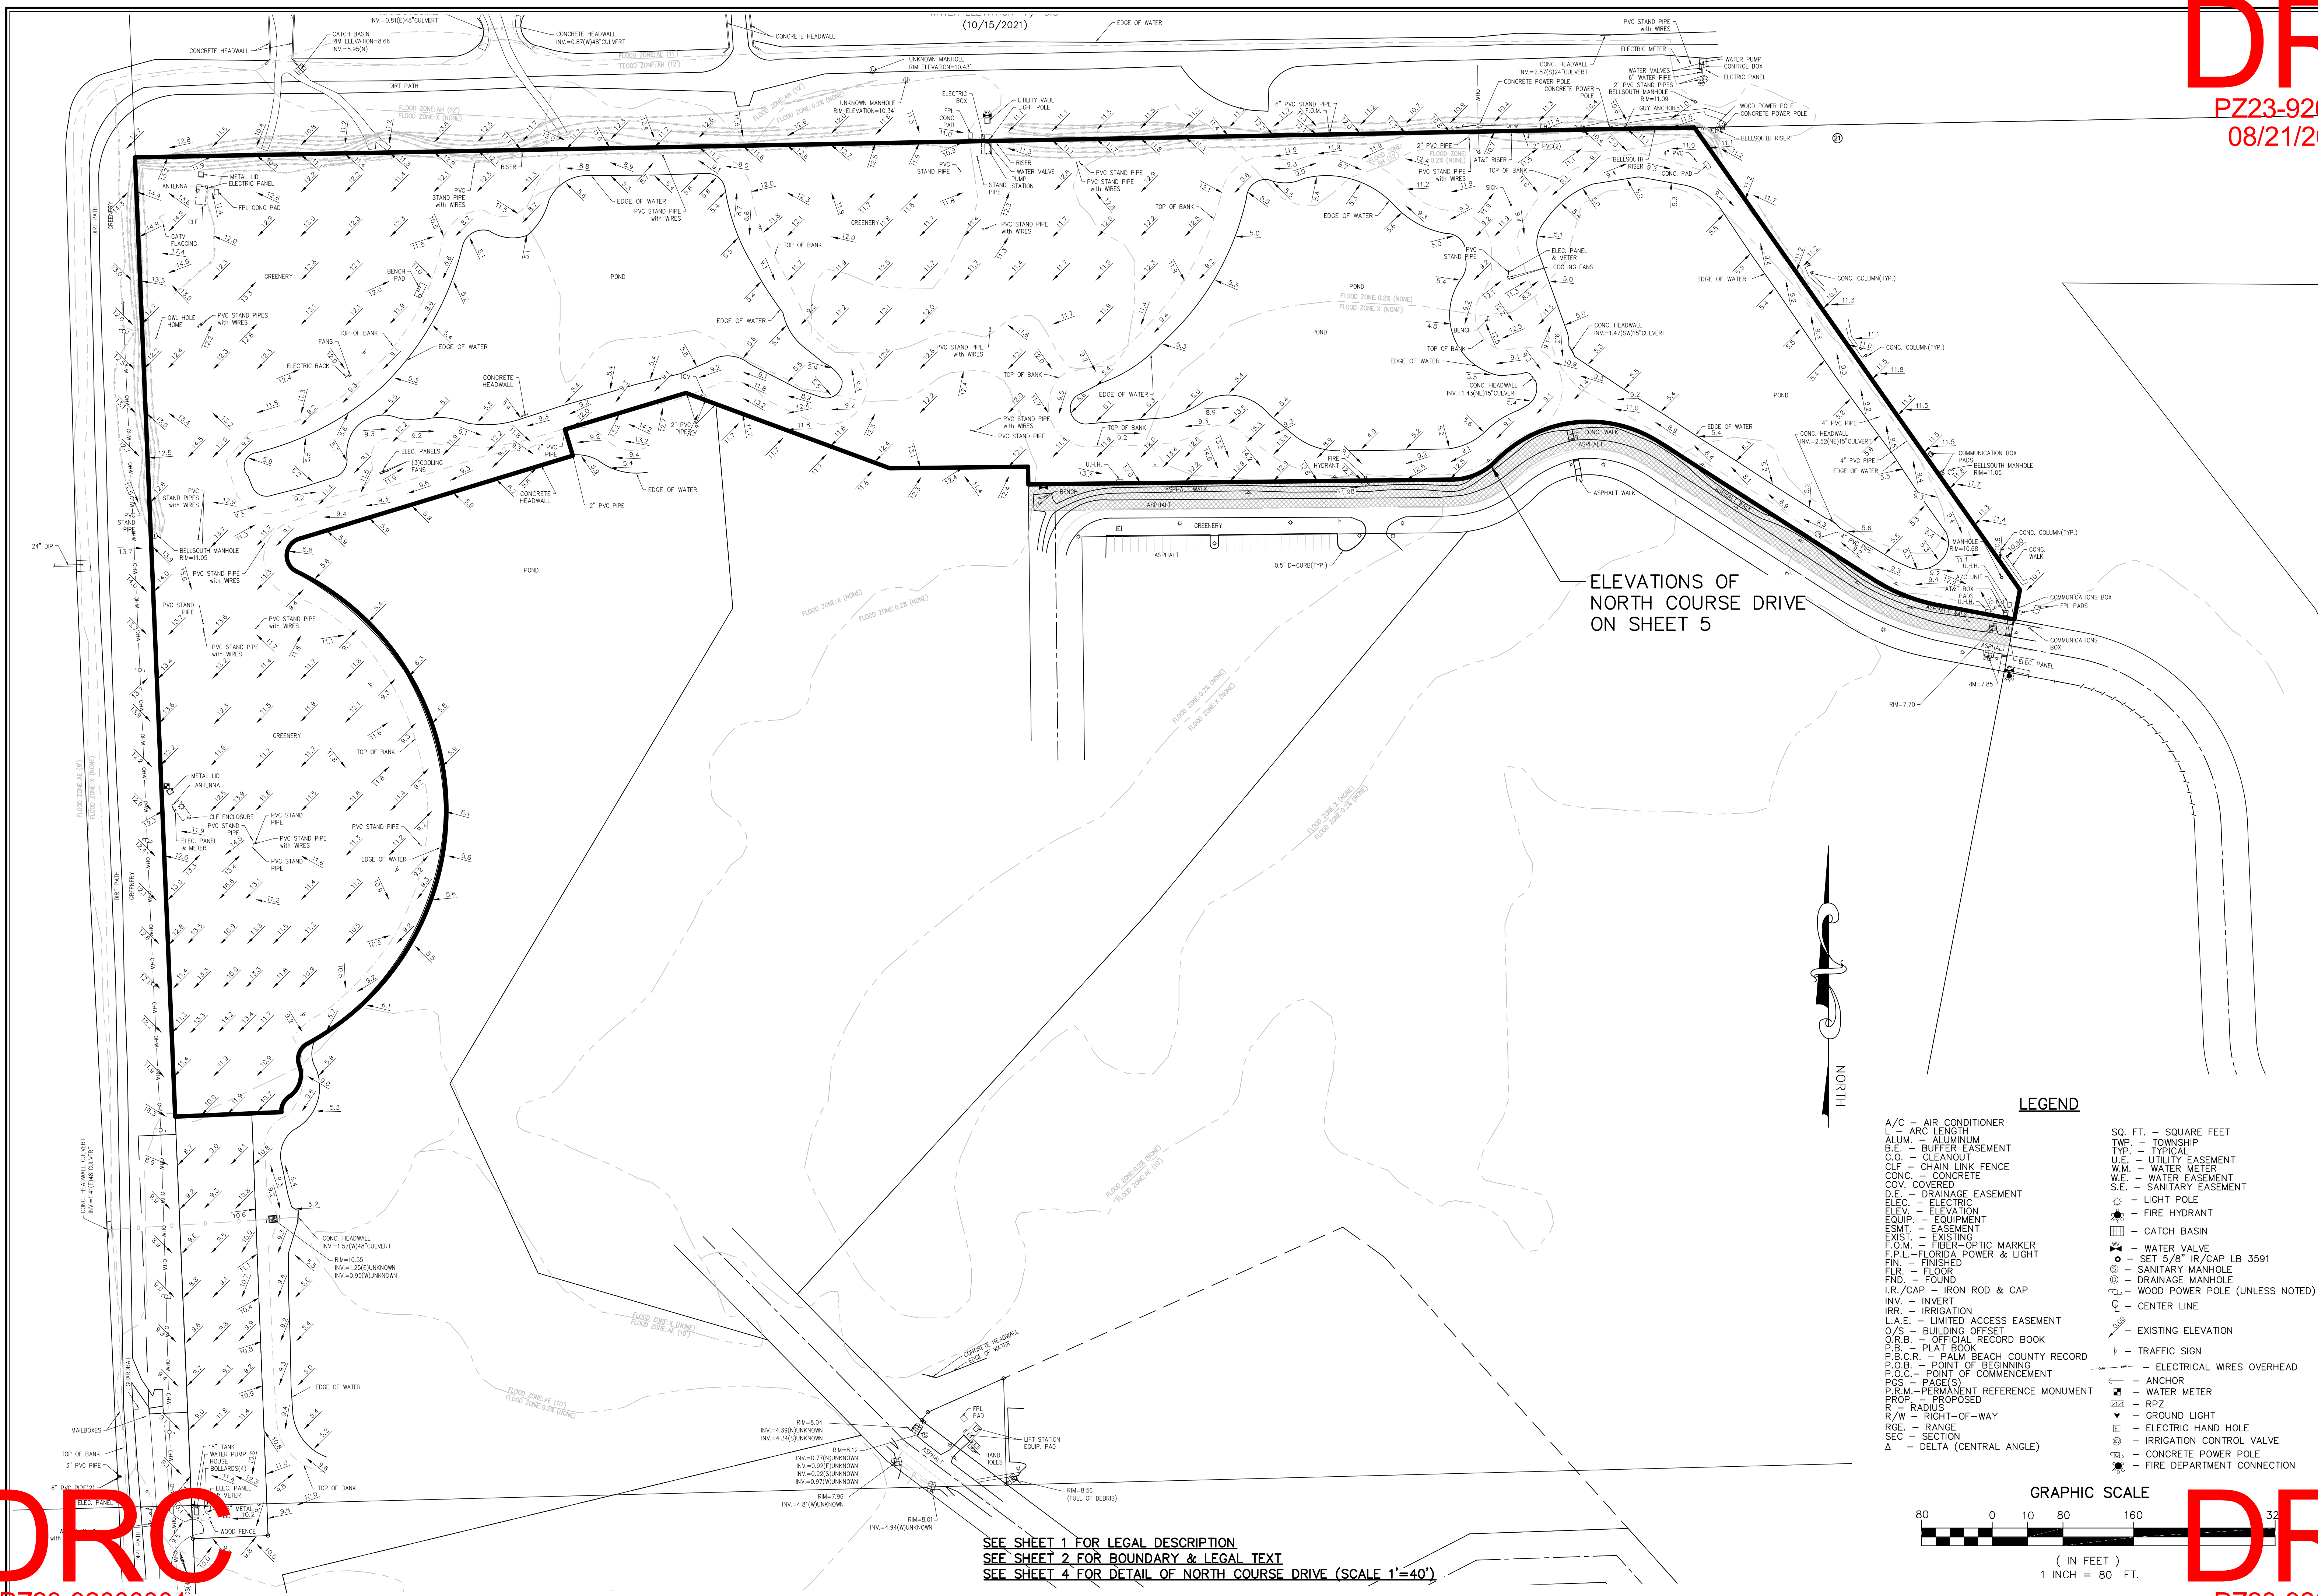

~~SEE SHEET 1 FOR LEGAL DESCRIPTION~~  
~~SEE SHEET 2 FOR BOUNDARY & LEGAL TEXT~~  
~~SEE SHEET 4 FOR DETAIL OF NORTH COURSE DRIVE (SCALE 1"=40')~~

**GRAPHIC SCALE**

( IN FEET )  
1 INCH = 80 FT.

PZ23-92000001  
02/07/2024