



TOP VIEW

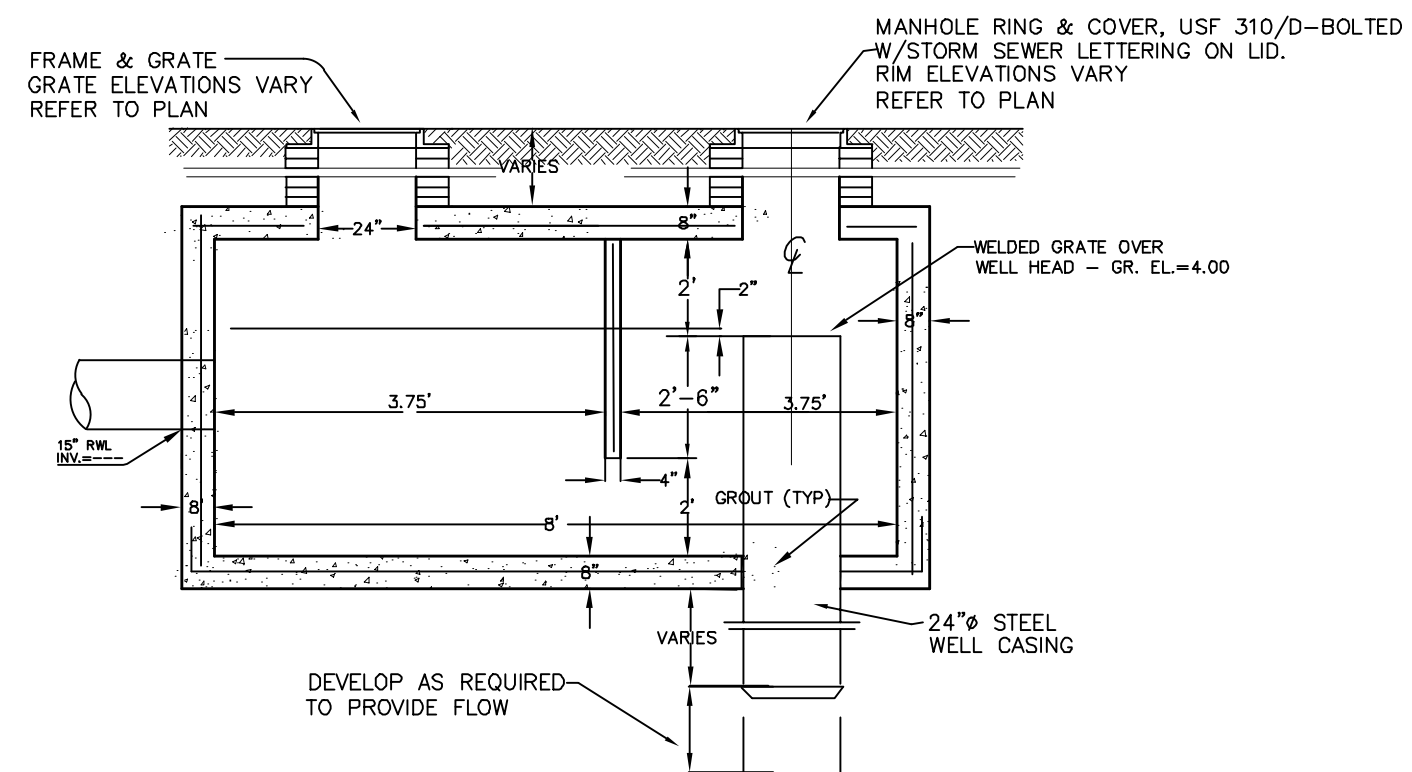


SECTION


TYPICAL RETENTION TANK AND DISPOSAL WELL
N.T.S.

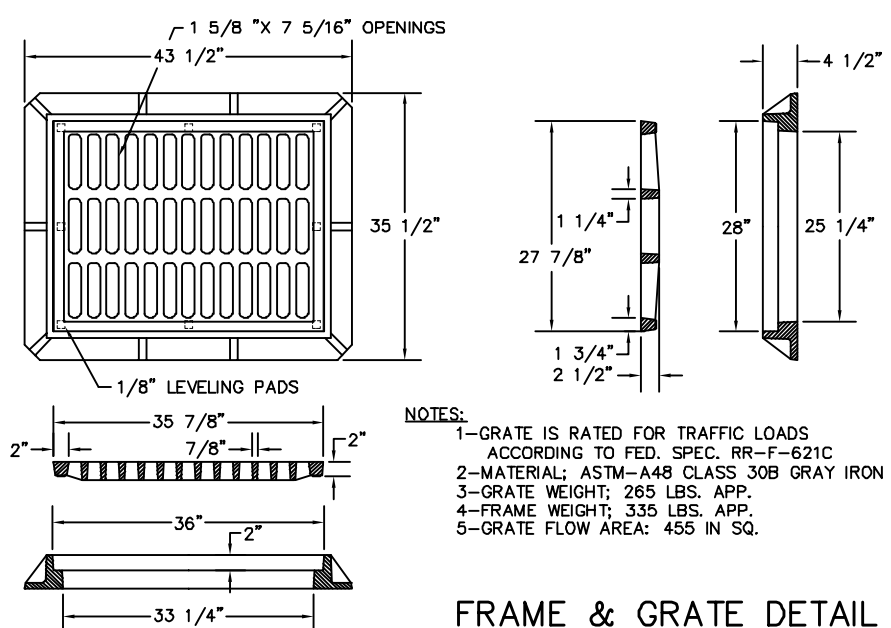


FRAME & GRATE DETAIL
N.T.S.

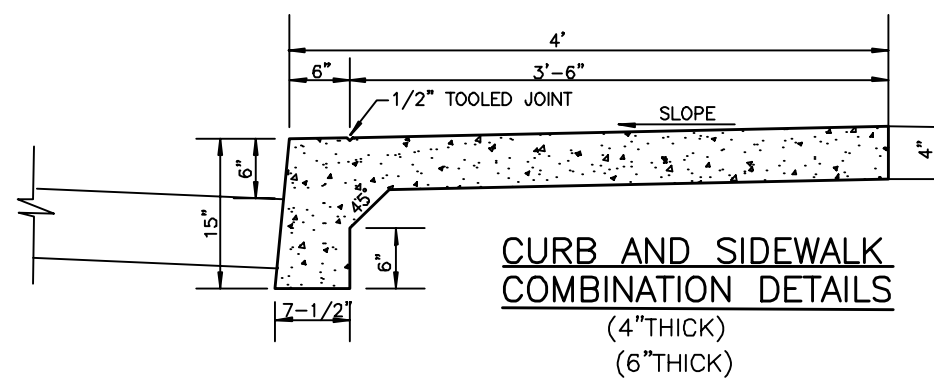


CURB AND SIDEWALK COMBINATION DETAILS
(4" THICK)
(6" THICK)

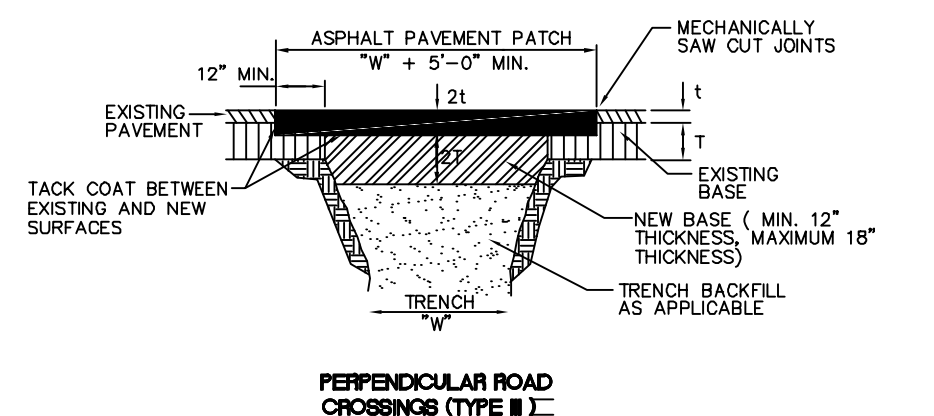

PERPENDICULAR ROAD CROSSING (TYPE I)

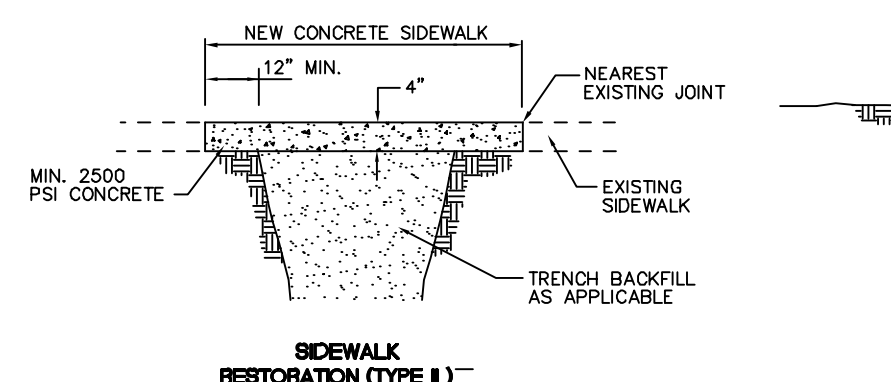


SIDEWALK RESTORATION (TYPE I)

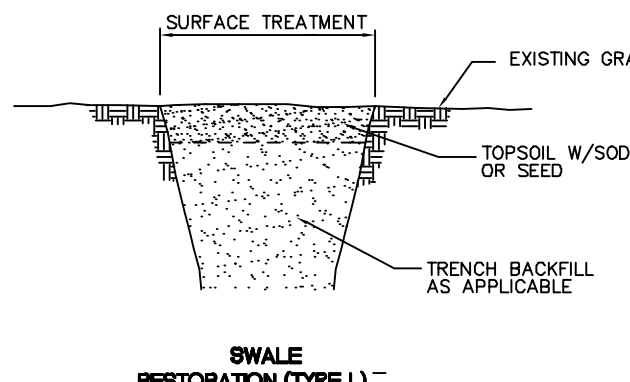


SWALE RESTORATION (TYPE I)

SURFACE RESTORATION

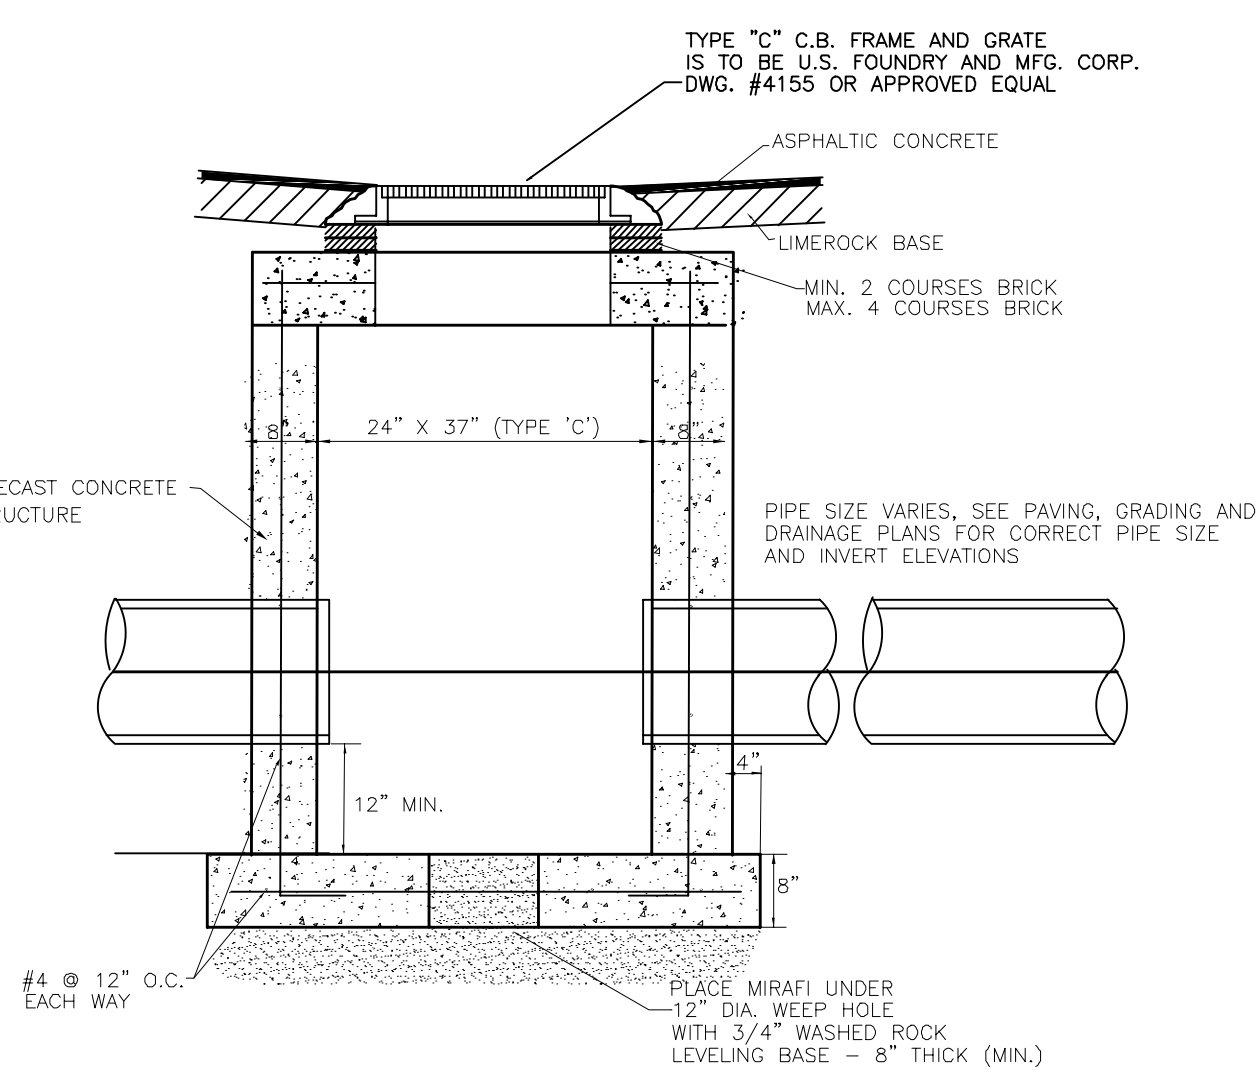

CATCH BASIN DETAIL


- NOTES:
- CATCH BASIN TO BE CONSTRUCTED PER D.O.T. SPECIFICATIONS
 - CONCRETE SHALL BE 4,000 P.S.I. MINIMUM
 - CONTRACTOR SHALL SUBMIT SHOP DRAWINGS INDICATING TYPE OF BASIN TO BE USED AT EACH LOCATION.

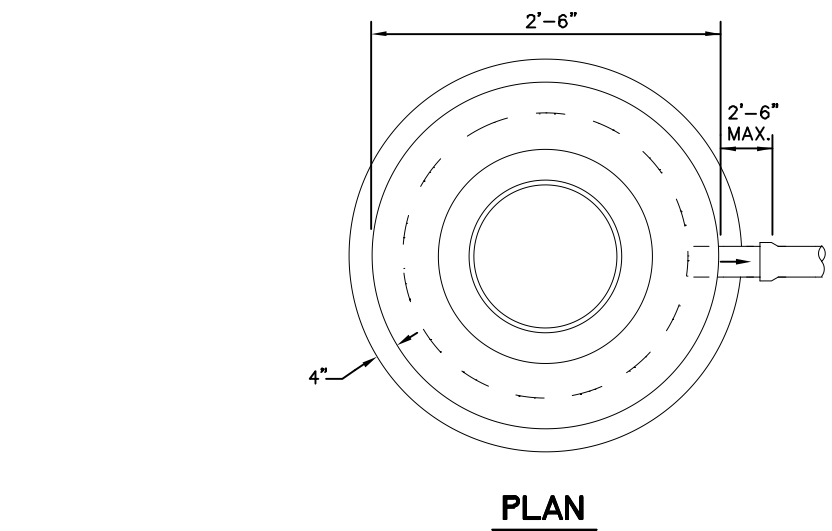

PLAN

NOTE: WHEN USED ON HIGH SIDE OF ROADWAYS, THE CROSS SLOPE OF THE GUTTER SHALL MATCH THE CROSS SLOPE OF THE ADJACENT PAVEMENT AND THE THICKNESS OF THE U.P. SHALL BE 6", UNLESS OTHERWISE SHOWN ON PLANS.


TYPE "F" CURB AND GUTTER
N.T.S.

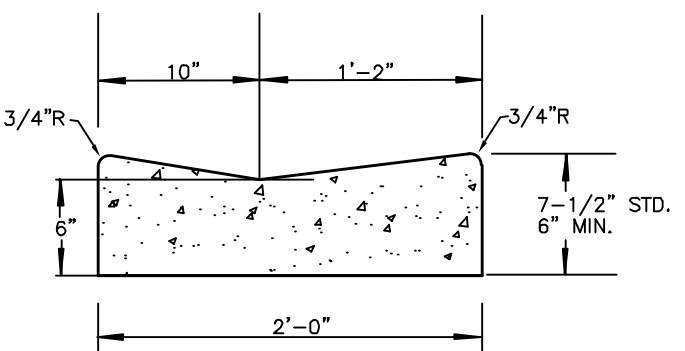


2' VALLEY GUTTER DETAIL
N.T.S.

NOTE: WHEN USED ON HIGH SIDE OF ROADWAYS, THE CROSS SLOPE OF THE GUTTER SHALL MATCH THE CROSS SLOPE OF THE ADJACENT PAVEMENT AND THE THICKNESS OF THE U.P. SHALL BE 6", UNLESS OTHERWISE SHOWN ON PLANS.

2' VALLEY GUTTER DETAIL
N.T.S.

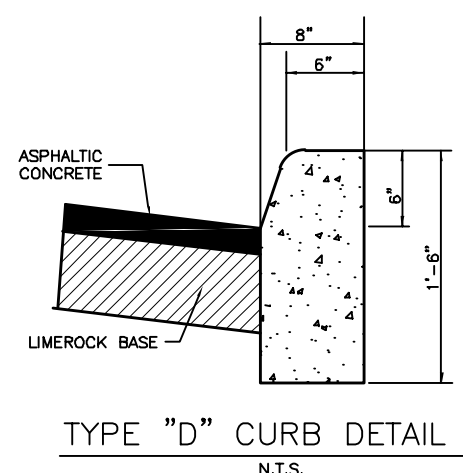


TYPE "D" CURB DETAIL
N.T.S.

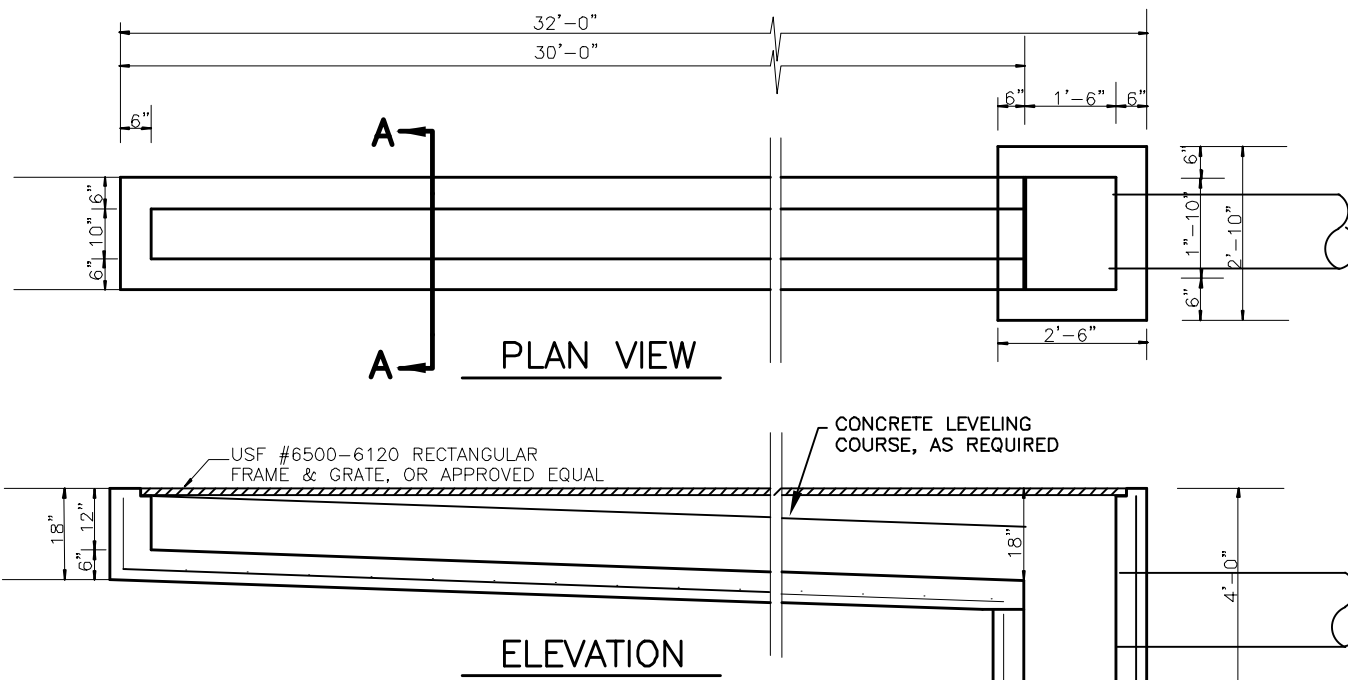


SECTION A-A

4000 PSI CONCRETE @ 28 DAYS
TYPE II CONCRETE

TRENCH DRAIN W/ CATCH BASIN DETAIL
N.T.S.

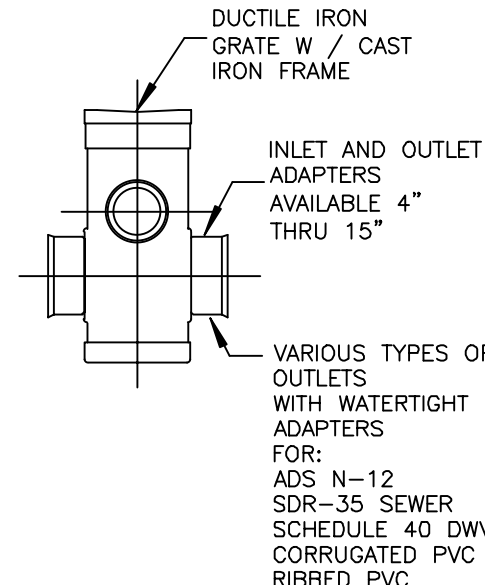


15" DRAIN BASIN DETAIL
NYLOPLAST-ADS DRAIN BASIN OR EQUAL

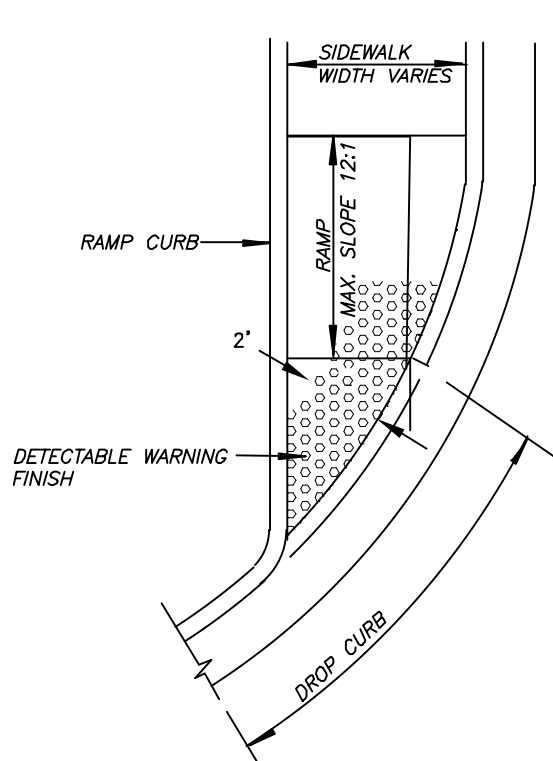


TYPICAL PLACEMENT OF DETECTABLE WARNING AT CURB RAMPS
REFER TO FDOT INDEX 304 FOR ADDITIONAL DETAIL & SPECIFICATIONS
N.T.S.


TYPE	LOCATION
"A"	JOINT SHALL BE PLACED AT P.C. AND P.T. OF CURVES, JUNCTION OF EXISTING SIDEWALKS, EVERY 60' ON NEW SIDEWALKS AND WHERE SIDEWALKS ABUT CONCRETE CURBS, DRIVEWAYS AND SIMILAR STRUCTURES.
"B"	JOINT SHALL BE PLACED 5'-0" CENTER
"C"	JOINT SHALL BE PLACED AT 20' INTERVALS

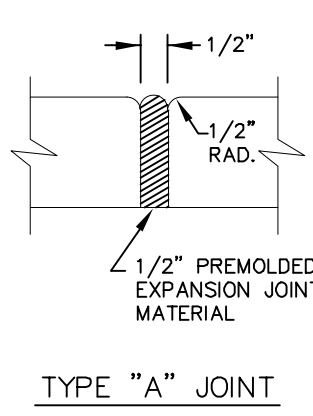

TYPE "A" JOINT

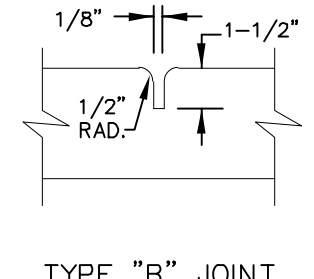

TYPE "B" JOINT

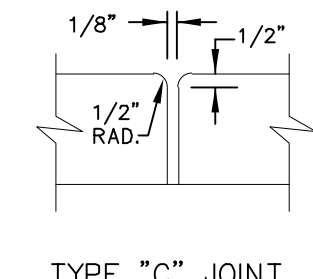


TYPE "C" JOINT

NOTE: SIDEWALK SHALL BE 4" THICK EXCEPT IN DRIVEWAYS WHERE THE THICKNESS SHALL BE 6".


SIDEWALK DETAILS

GENERAL NOTES:

- ALL MUCK UNDER THE PROPOSED DRIVEWAY AND PARKING AREAS SHALL BE REMOVED AND REPLACED WITH COMPACTED ACCEPTABLE FILL IN ONE FOOT LIFTS TO 98 PERCENT DENSITY.
- ALL MATERIAL, INSTALLATION, TESTING AND SPECIFICATIONS SHALL BE IN ACCORDANCE WITH THE REQUIREMENTS OF THE CITY OF POMPANO BEACH STANDARDS AND THE GOVERNING, PERMITTING AND LICENSING AGENCIES WHERE APPLICABLE.
- ALL UNDERGROUND UTILITIES AND DRAINAGE IS TO BE INSTALLED BEFORE SUBGRADE IS CONSTRUCTION.
- ALL DRAINAGE PIPE SHALL BE CORRUGATED POLYETHYLENE, UNLESS OTHERWISE NOTED.
- ALL ELEVATIONS REFER TO N.G.V.D., NATIONAL GEODETIC VERTICAL DATUM.
- CONTRACTOR SHALL TAKE ALL NECESSARY PRECAUTIONS TO SAFEGUARD ALL EXISTING STRUCTURES AND UTILITIES. ANY DAMAGE DONE TO EXISTING UTILITIES SHALL BE REPAIRED BY THE CONTRACTOR AT NO EXPENSE TO THE SUBJECT UTILITY. CALL "SUNSHINE" (1-800-432-4770) 48 HOURS BEFORE DIGGING.
- CONTRACTOR SHALL VERIFY LOCATION OF ALL UNDERGROUND UTILITIES PRIOR TO CONSTRUCTION. ALL INSTALLATIONS SHALL BE MADE IN SUCH A MANNER AS NOT TO INTERFERE WITH EXISTING OR NEW UTILITIES, DRAINAGE, OR ROADWAY CONSTRUCTION.
- BENCHMARK ELEVATION TO BE ESTABLISHED PRIOR TO FINAL INSPECTION OF THE DRAINAGE SYSTEM.
- LOCATION OF EXISTING UNDERGROUND UTILITIES HAS BEEN PREPARED FROM THE MOST RELIABLE INFORMATION AVAILABLE TO THE ENGINEER. THE CONTRACTOR SHALL BE RESPONSIBLE TO VERIFY LOCATION AND DEPTH OF ALL PERTINENT UTILITIES PRIOR TO COMMENCEMENT OF CONSTRUCTION.
- EXCAVATION SHALL BE SLOPED OR OTHERWISE SUPPORTED IN A SAFE MANNER IN ACCORDANCE WITH APPLICABLE STATE SAFETY REQUIREMENTS AND REQUIREMENTS OF OSHA SAFETY AND HEALTH STANDARD FOR CONSTRUCTION (29 CFR 1926).
- PRIOR TO THEIR CONSTRUCTION OR INSTALLATION, SHOP DRAWINGS SHALL BE SUBMITTED TO AND APPROVED BY THE ENGINEER OF RECORD FOR THE FOLLOWING: STORM MANHOLES, CATCHBASINS, FIRE HYDRANTS, VALVES, PIPE MATERIAL AND ALL REQUIRED ACCESSORIES. IT IS THE RESPONSIBILITY OF THE CONTRACTOR TO OBTAIN ALL OTHER AGENCY APPROVALS, IF REQUIRED.
- UPON COMPLETION OF EACH SECTION OF DRAINAGE SYSTEM, THE SECTION IS TO BE CLEANED AND INSPECTED. INSPECTION SHALL BE PERFORMED BY LAMPING EACH SECTION BETWEEN STRUCTURES. EXAMINATION FROM EITHER END, SHALL SHOW A FULL CIRCLE OF LIGHT. ALL REPAIRS SHOWN NECESSARY BY THE INSPECTION ARE TO BE MADE: COLLAPSED PIPE REPLACED, REMOVED AND THE DRAIN LINE LEFT TRUE TO LINE AND GRADE, ENTIRELY CLEAN AND READY TO USE.
- RECORD INFORMATION (AS-BUILTS) CERTIFIED BY A PROFESSIONAL LAND SURVEYOR REGISTERED IN THE STATE OF FLORIDA SHALL BE SUBMITTED TO THE ENGINEER OF RECORD PRIOR TO FINAL ACCEPTANCE OF THE SYSTEM. RECORD INFORMATION TO BE PAID FOR BY THE CONTRACTOR.

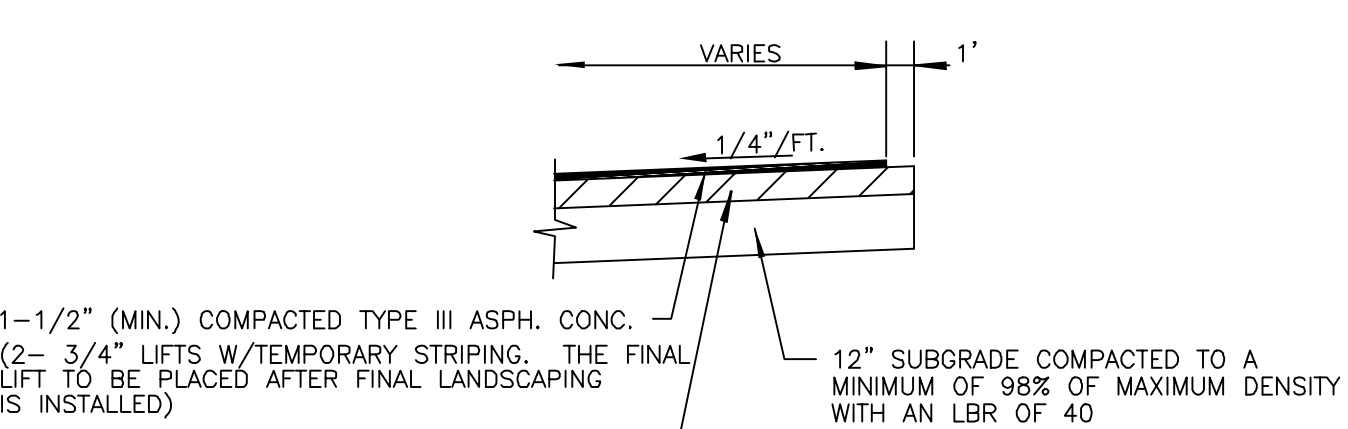


PROPOSED PAVEMENT SECTION
N.T.S.

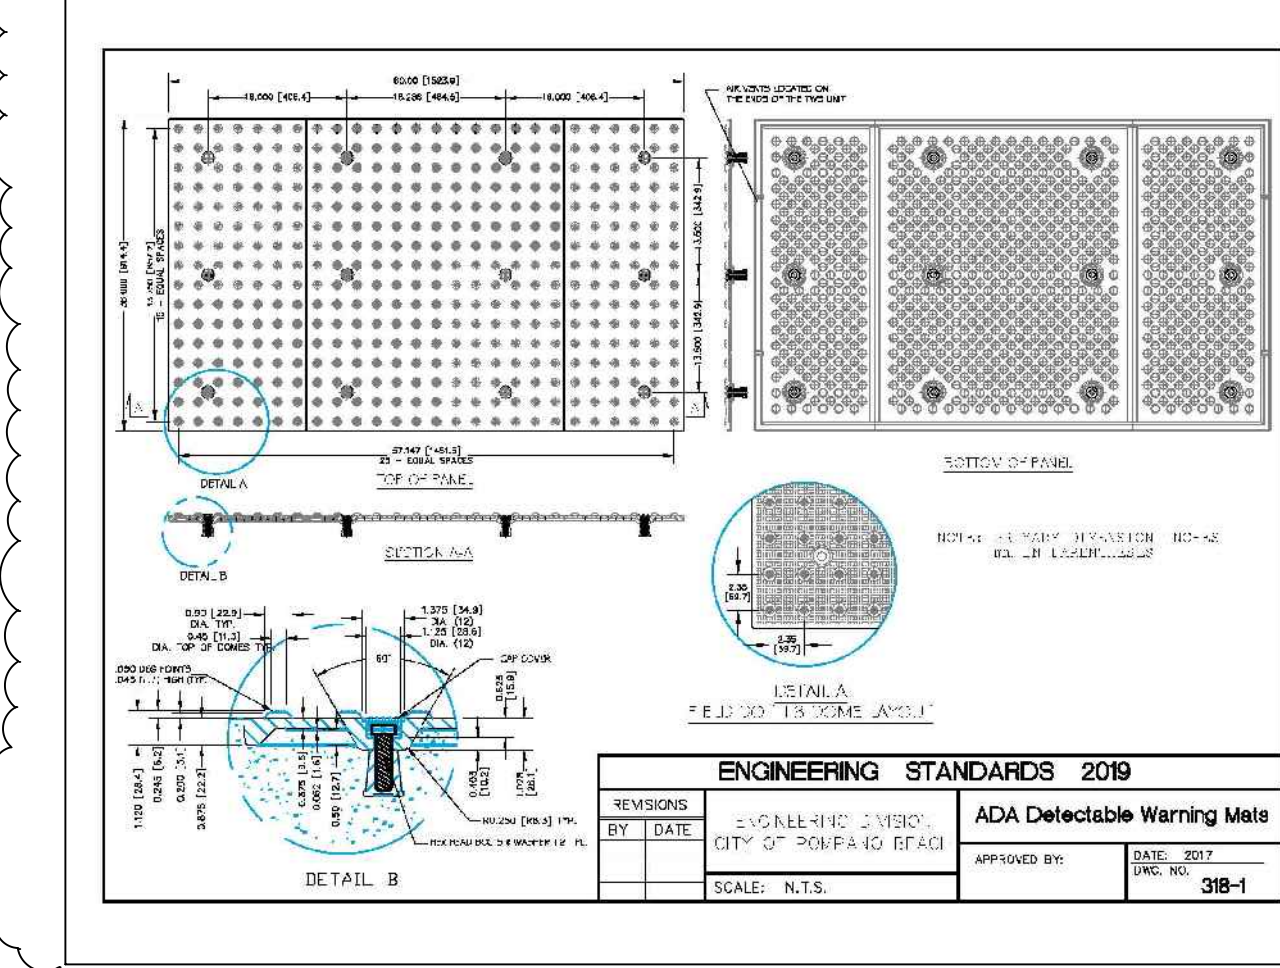

ENGINEERING STANDARD 2019			
REVISIONS	BY	DATE	APPROVED BY
1	NEAL B. JANOV	07/17/2020	NEAL B. JANOV

SCALE: N.T.S.

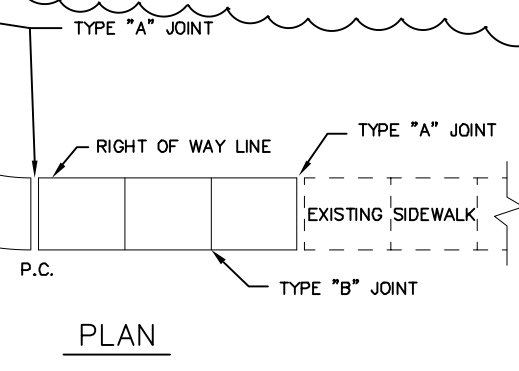

PLAN

CONCRETE STRENGTH SHALL BE A MINIMUM OF 2500 P.S.I.

Neal B. Janov, State of Florida, Professional Engineer, License No. 21998. This item has been digitally signed and sealed by Neal B. Janov, P.E. on July 17, 2020 using a Digital Signature. Printed copies of this document are not considered signed and sealed and the signature must be verified on any electronic copies.

Neal B. Janov
Digitally signed by Neal B. Janov
Date: 2020.07.17 12:01:00 -0400

NEAL B. JANOV #21998

PZ20-12000005
1/5/2021

DIVERSIFIED CONSTRUCTION
DCES
& ENGINEERING SERVICES
2295 N.W. CORPORATE BLVD., #125 BOCA RATON, FL 33431
561-750-3717 FAX 561-750-3686
EB #6459

REVISIONS	DATE	CHK.	DWN.
1. REVISED PER DRC COMMENTS	06-25-20	M.A.	
2.			
3.			
4.			
5.			
6.			
7.			
8.			

ATLANTIC 3350 LLC
3350 ATLANTIC BOULEVARD
POMPANO BEACH, FLORIDA
PAVING, GRADING & DRAINAGE DETAILS

DCES	
SCALE: NONE	DATE: 10-22-14
DWN. BY: M.K.	CHK. BY: N.B.J.
F.B. PG.	NO.:
1000	08
SHEET C-2	