
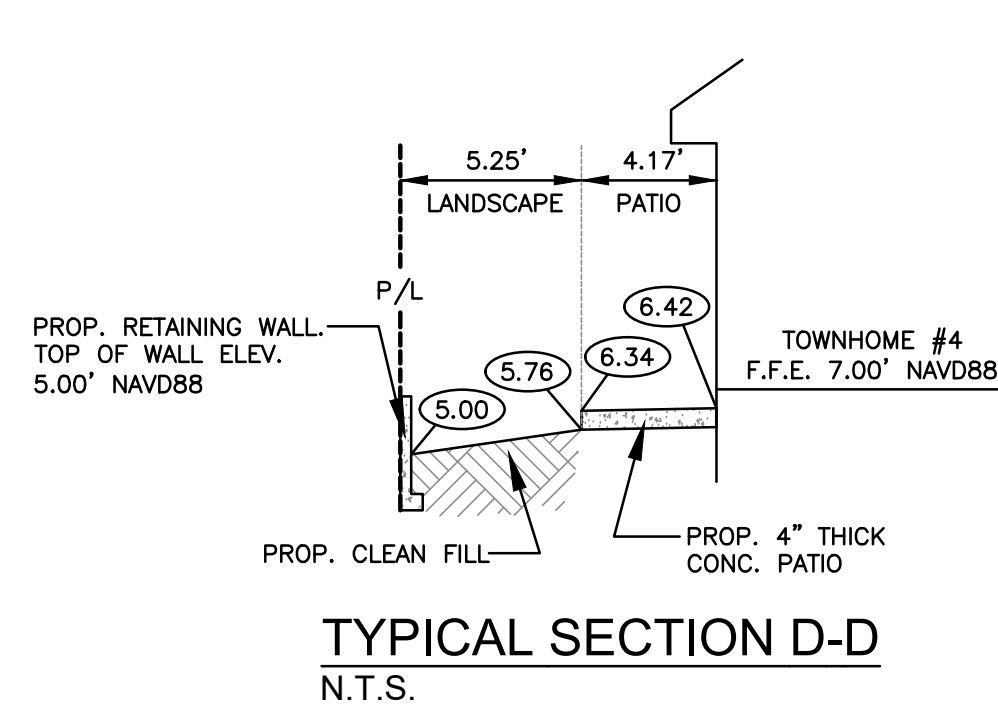
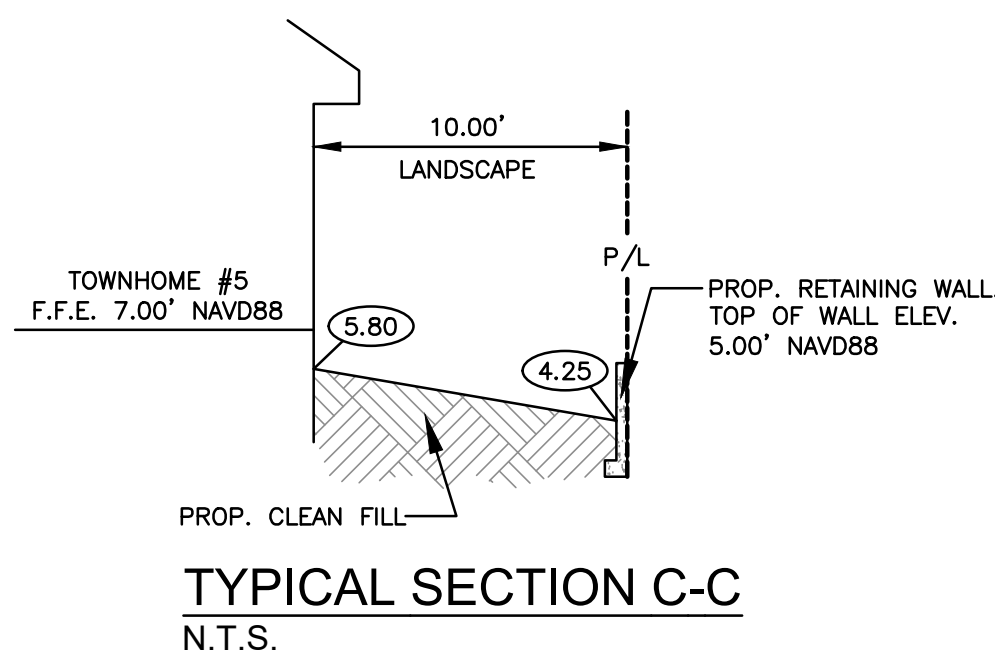
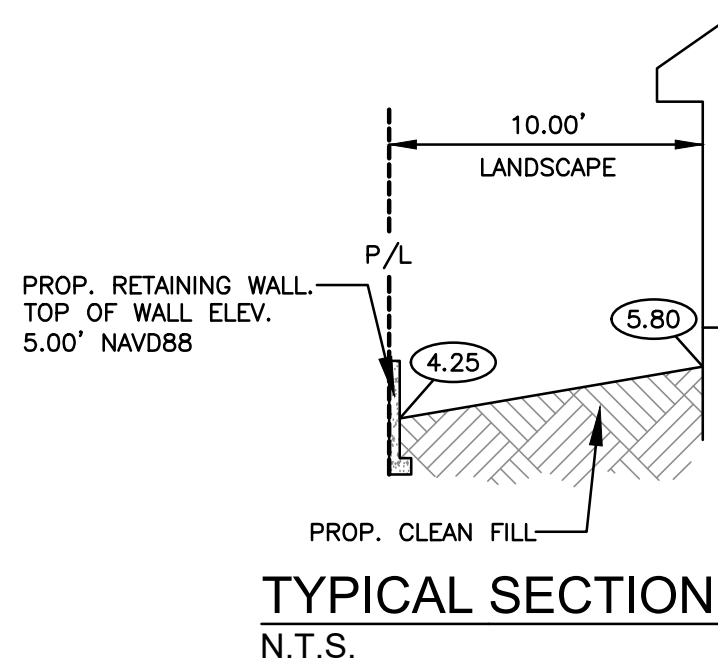
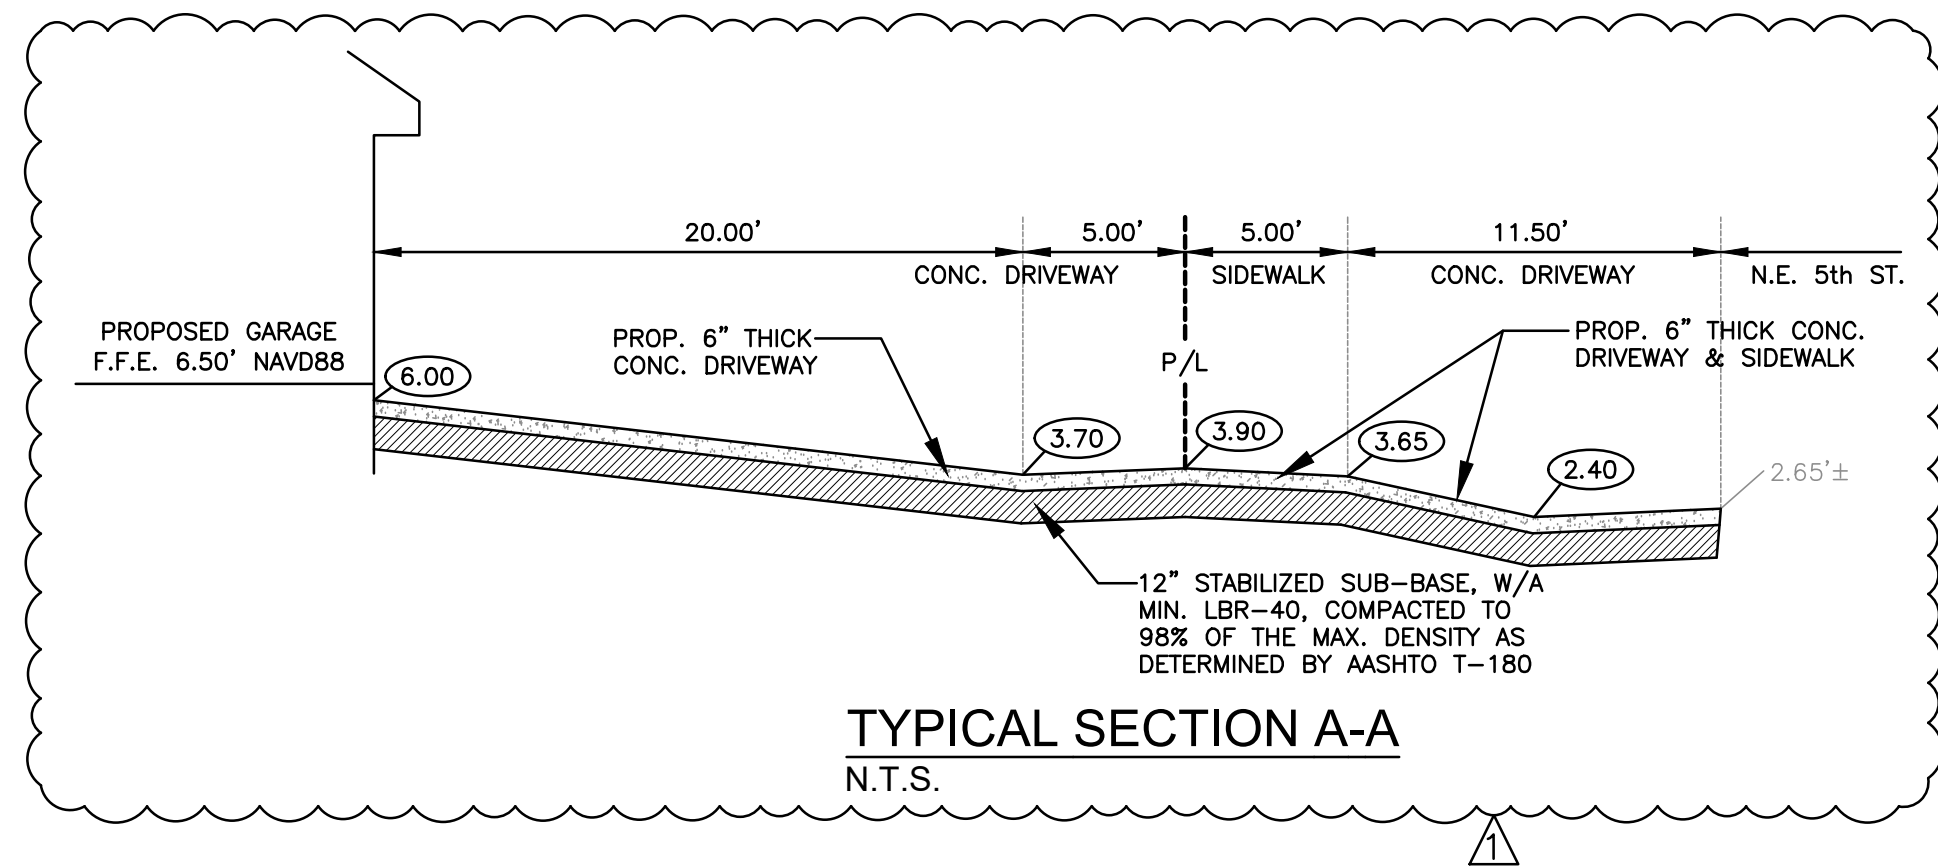


ALL ELEVATIONS ARE REFERENCED
TO NAVD88 VERTICAL DATUM

09/03/2025

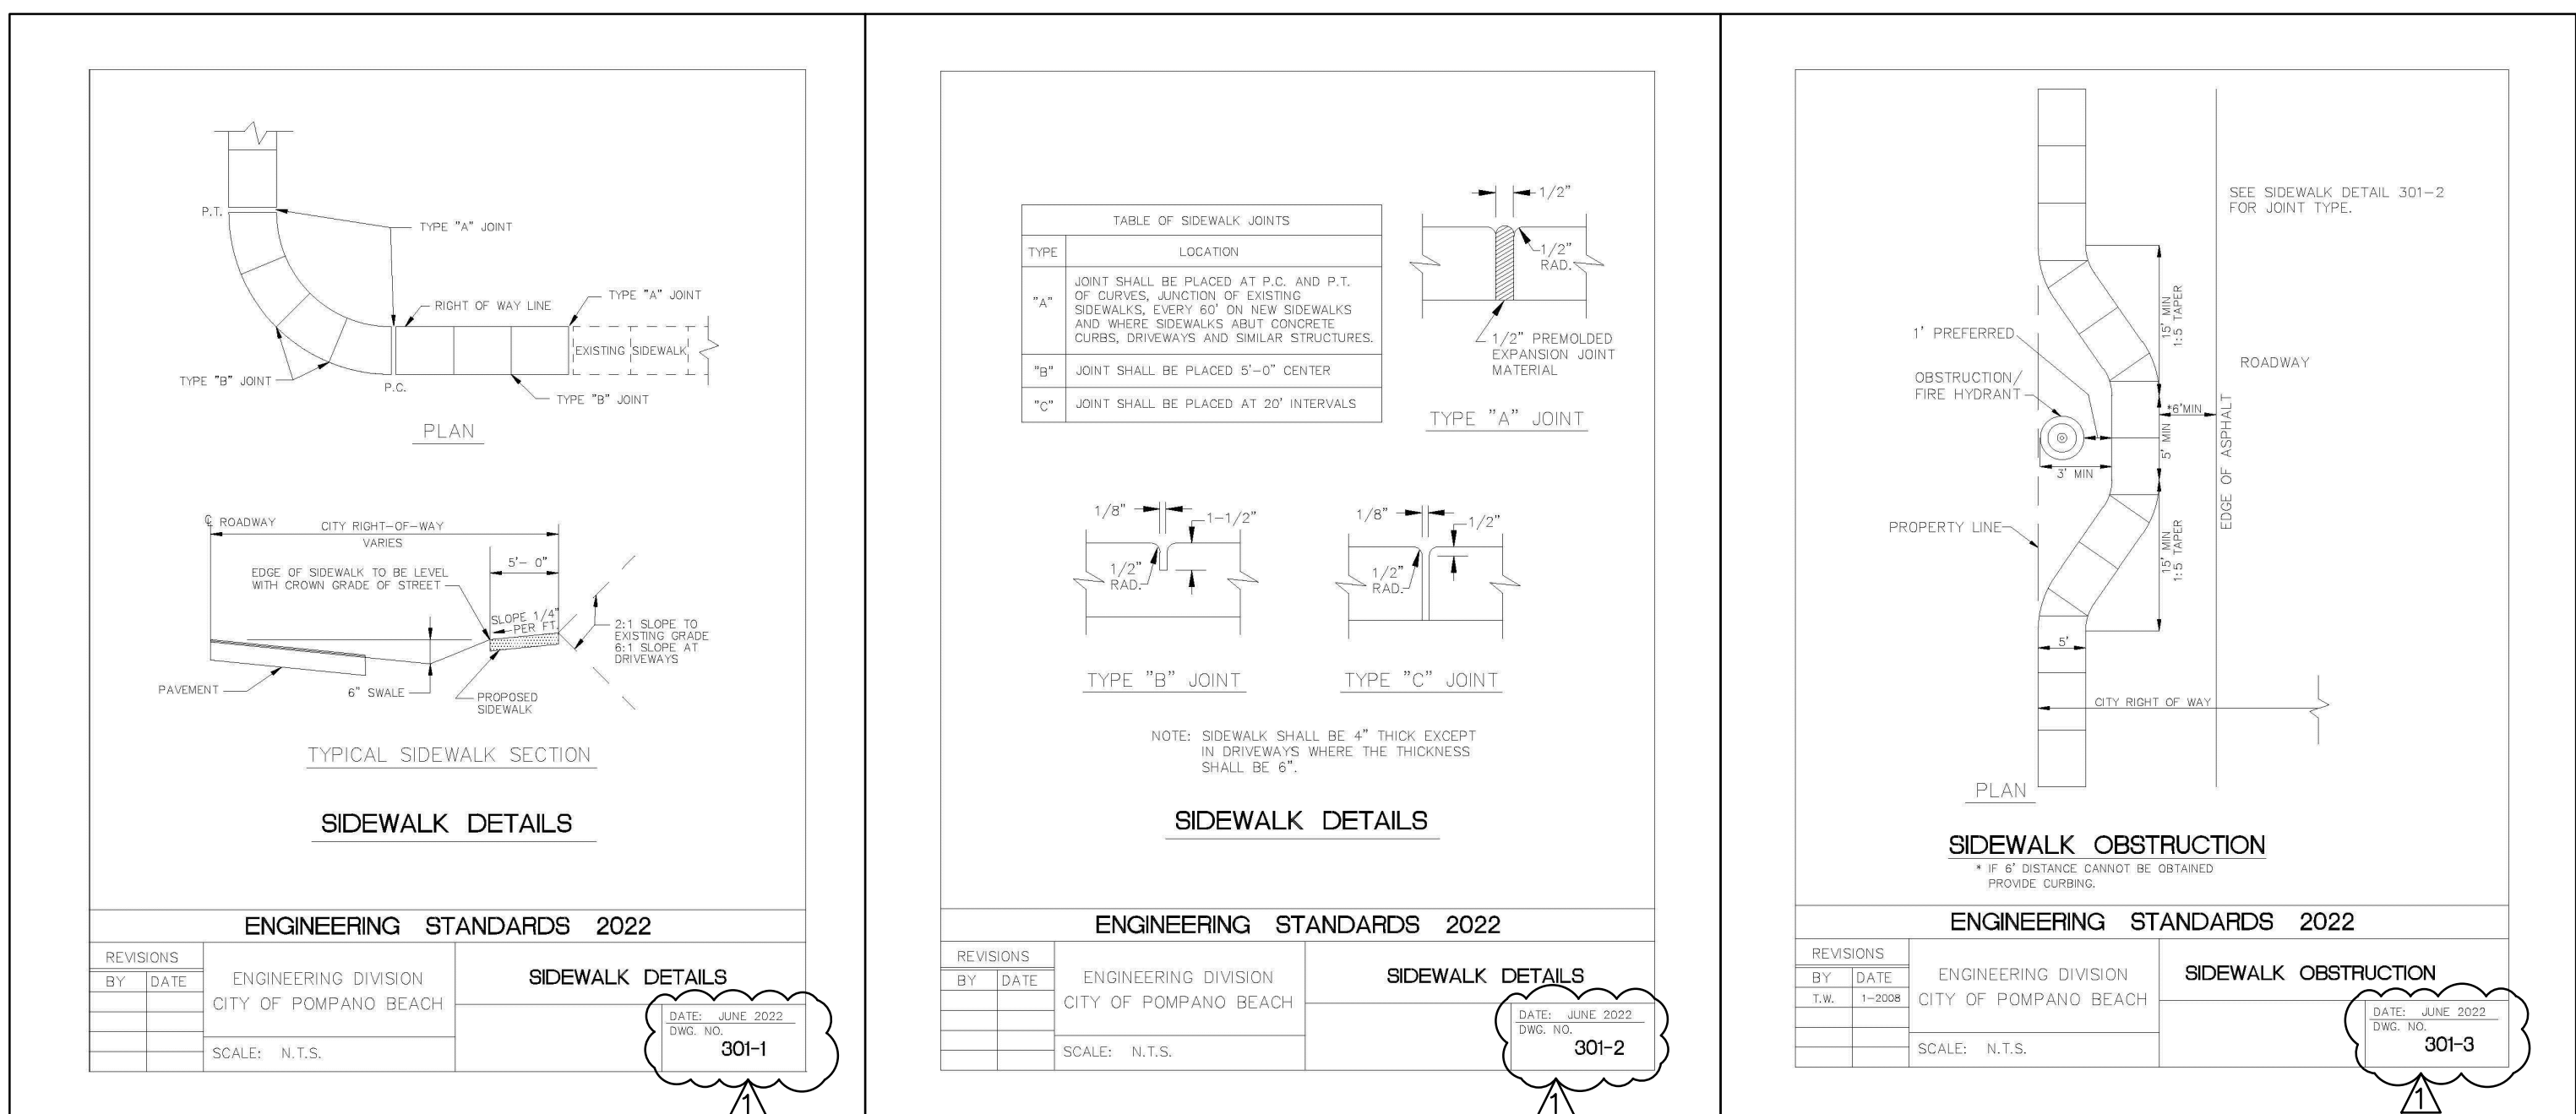 


- IF THE EXISTING MAINS IS CLAY PIPE AND HAS A CIPP LINDER CURRENTLY INSTALLED, INSTALL A SECTIONAL LINER IN THE MAIN OVER THE OLD LATERAL, THUS ELIMINATING THE LATERAL.
- IF THE EXISTING MAIN IS CLAY PIPE, DIG DOWN, CUT OLD CLAY PIPE, AND SLEEVE BACK IN WITH PVC PIPE.
- IF THE EXISTING MAIN IS CLAY PIPE, AND THE PROJECT IS REQUIRED TO RETIRE MULTIPLE LATERALS, IT MAY BE CHEAPER FOR THE CONTRACTOR TO INSTALL A CITY APPROVED CIPP LINER FROM MANHOLE TO MANHOLE, AND NOT CUT OUT THE LATERALS BEING RETIRED.
- IF THE EXISTING MAIN IS PVC PIPE, REMOVE THE LATERAL PIPE FROM THE PVC WYE FITTING TO THE MAIN, AND PLUG INTO THE MAIN WITH A GRATE. LOCATING MARKING BALL AT THE LATERAL LOCATION, NO DEEPER THAN 4 FT. BELOW GRADE.

SCALE: 1"=10'

PRINTED COPIES OF THIS DOCUMENT ARE NOT CONSIDERED
SIGNED AND SEALED AND THE SIGNATURE MUST BE VERIFIED
ON ANY ELECTRONIC COPIES.

NO.	DATE	DESCRIPTION
1	10-30-24	DRC REVIEW COMMENTS



POMPANO BEACH, FL 33062

2 OF 5

PROJECT NO.: 23-22