


ACCESSIBLE PARKING SPACE SIGN
N.T.S.

SIGN NOTE

ACCESSIBLE PARKING SPACES SHALL BE POSTED WITH A FIXED PARKING SIGN NO LESS THAN 60" MIN. TO THE BOTTOM OF THE SIGN AND WHICH BEARS THE INTERNATIONAL SYMBOL OF ACCESSIBILITY MEETING THE REQUIREMENTS OF THE STANDARDS AND THE CAPTION "PARKING BY DISABLED PERMIT ONLY." AND MUST INDICATE THE PENALTY FOR ILLEGAL USE OF THE SPACE.

ENGINEERING STANDARDS 2025			
REVISIONS		ENGINEERING DIVISION	ACCESSIBLE SPACE SIGN
BY	DATE		
		CITY OF POMPANO BEACH	
		SCALE: N.T.S.	DATE: MAY 2022 DWG. NO. 300-5

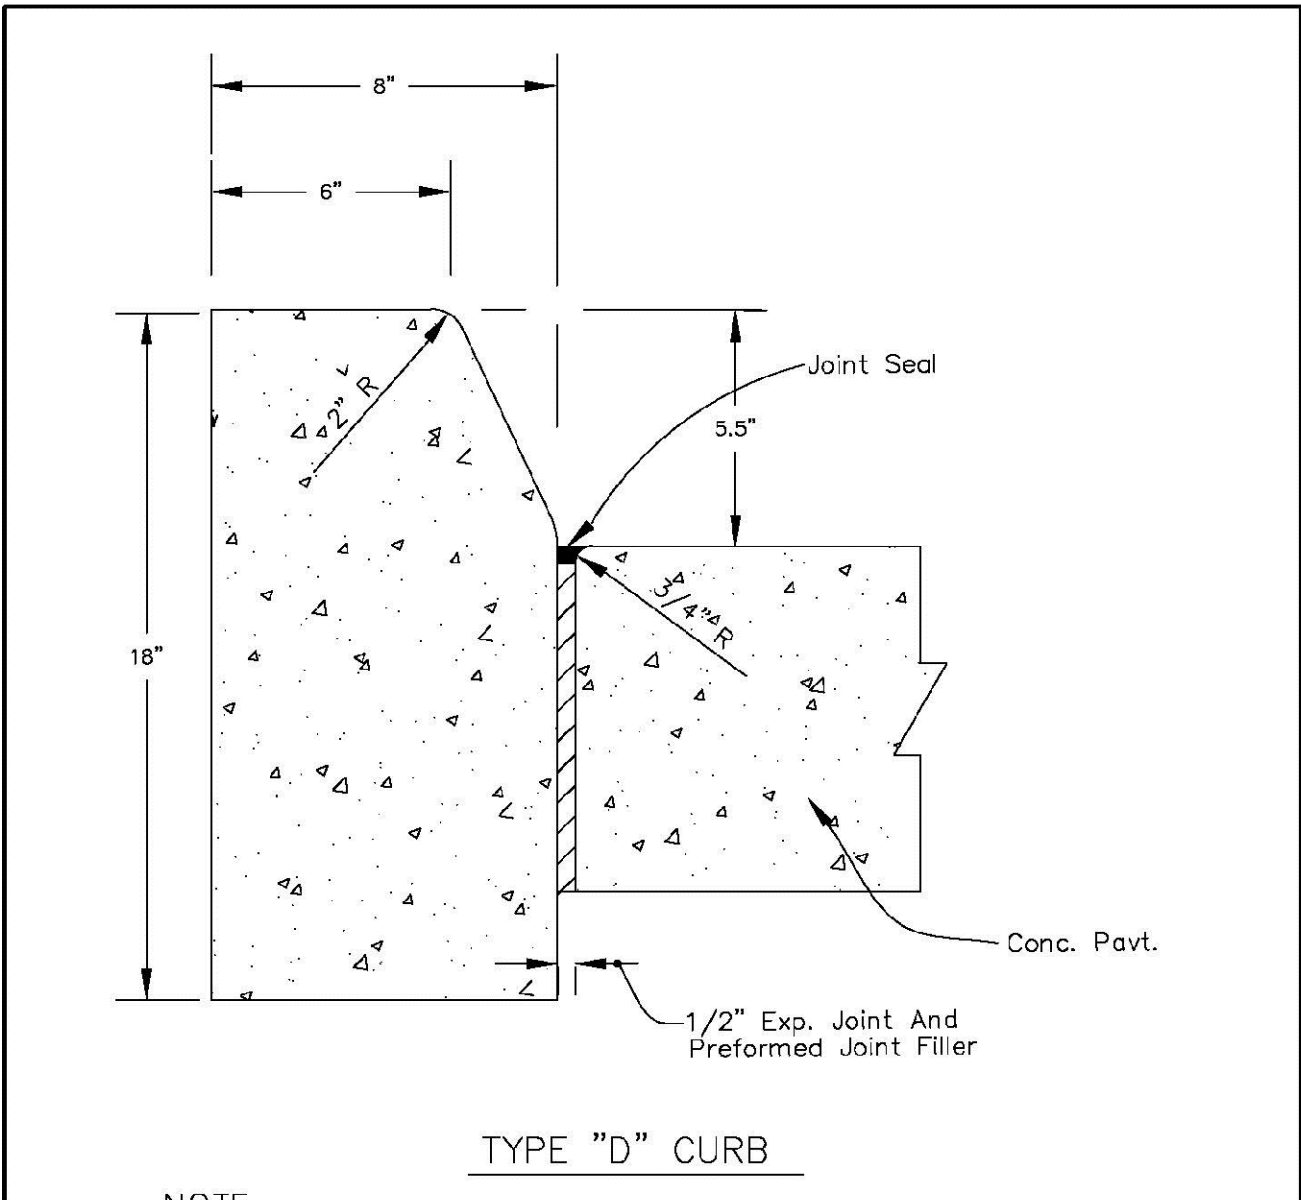


TYPE "D" CURB

NOTE

FOR USE ADJACENT TO CONCRETE OR FLEXIBLE PAVEMENT, CONCRETE SHOWN. EXPANSION JOINT, PREFORMED JOINT FILLER AND JOINT SEAL ARE REQUIRED BETWEEN CURBS AND CONCRETE PAVEMENT ONLY.


CONCRETE CURB DETAIL

ENGINEERING STANDARDS 2025			
REVISIONS		ENGINEERING DIVISION	CONCRETE CURB
BY	DATE		
S.S.	01-2014	CITY OF POMPANO BEACH	
S.S.	08-2015		
S.S.	07-2018		
		SCALE: N.T.S.	DATE: MAY 2022 DWG. NO. 300-2

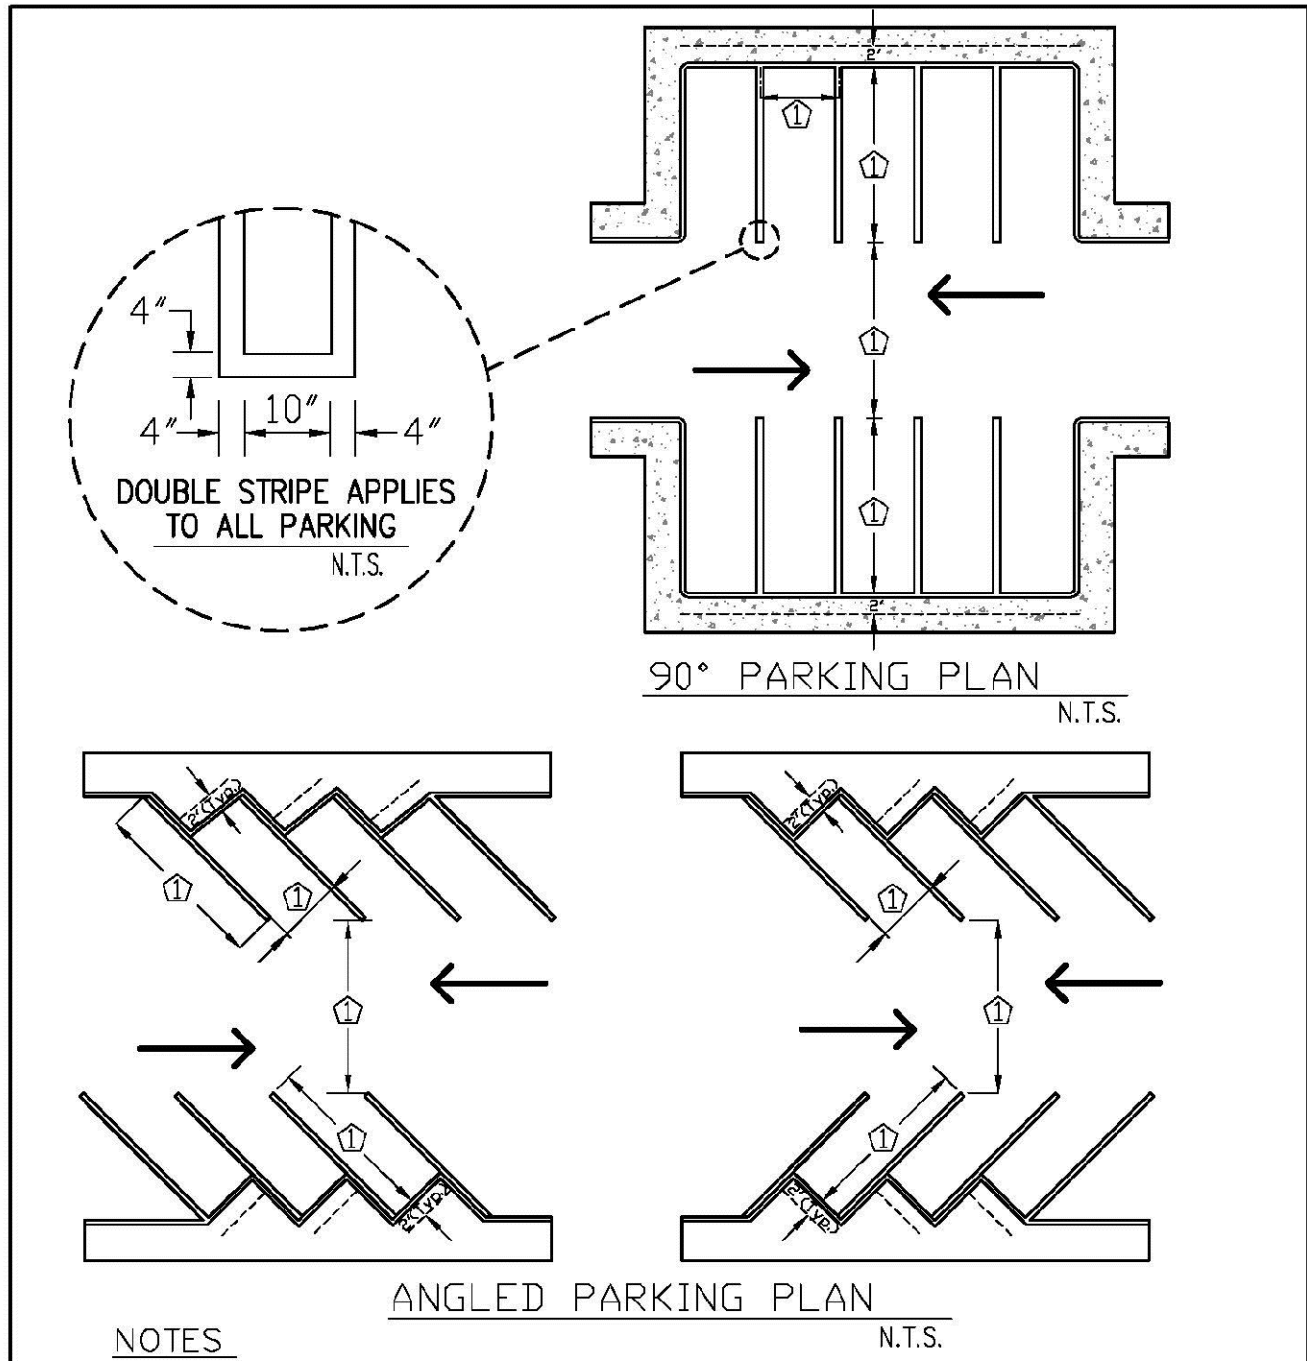

- NOTES**
- INDICATED DIMENSION BY LOCAL ZONING ORDINANCE.
 - CURBING APPLIES TO ALL PARKING.
 - EACH SPACE SHALL BE DESIGNATED BY FOUR 4 INCH WIDE VISIBLE STRIPING CONSISTING OF WHITE PAINT OR AS APPROVED BY THE CITY.





ENGINEERING STANDARDS 2025			
REVISIONS		ENGINEERING DIVISION	STANDARD PARKING SPACES
BY	DATE		
		CITY OF POMPANO BEACH	
		SCALE: N.T.S.	DATE: MAY 2022 DWG. NO. 300-3

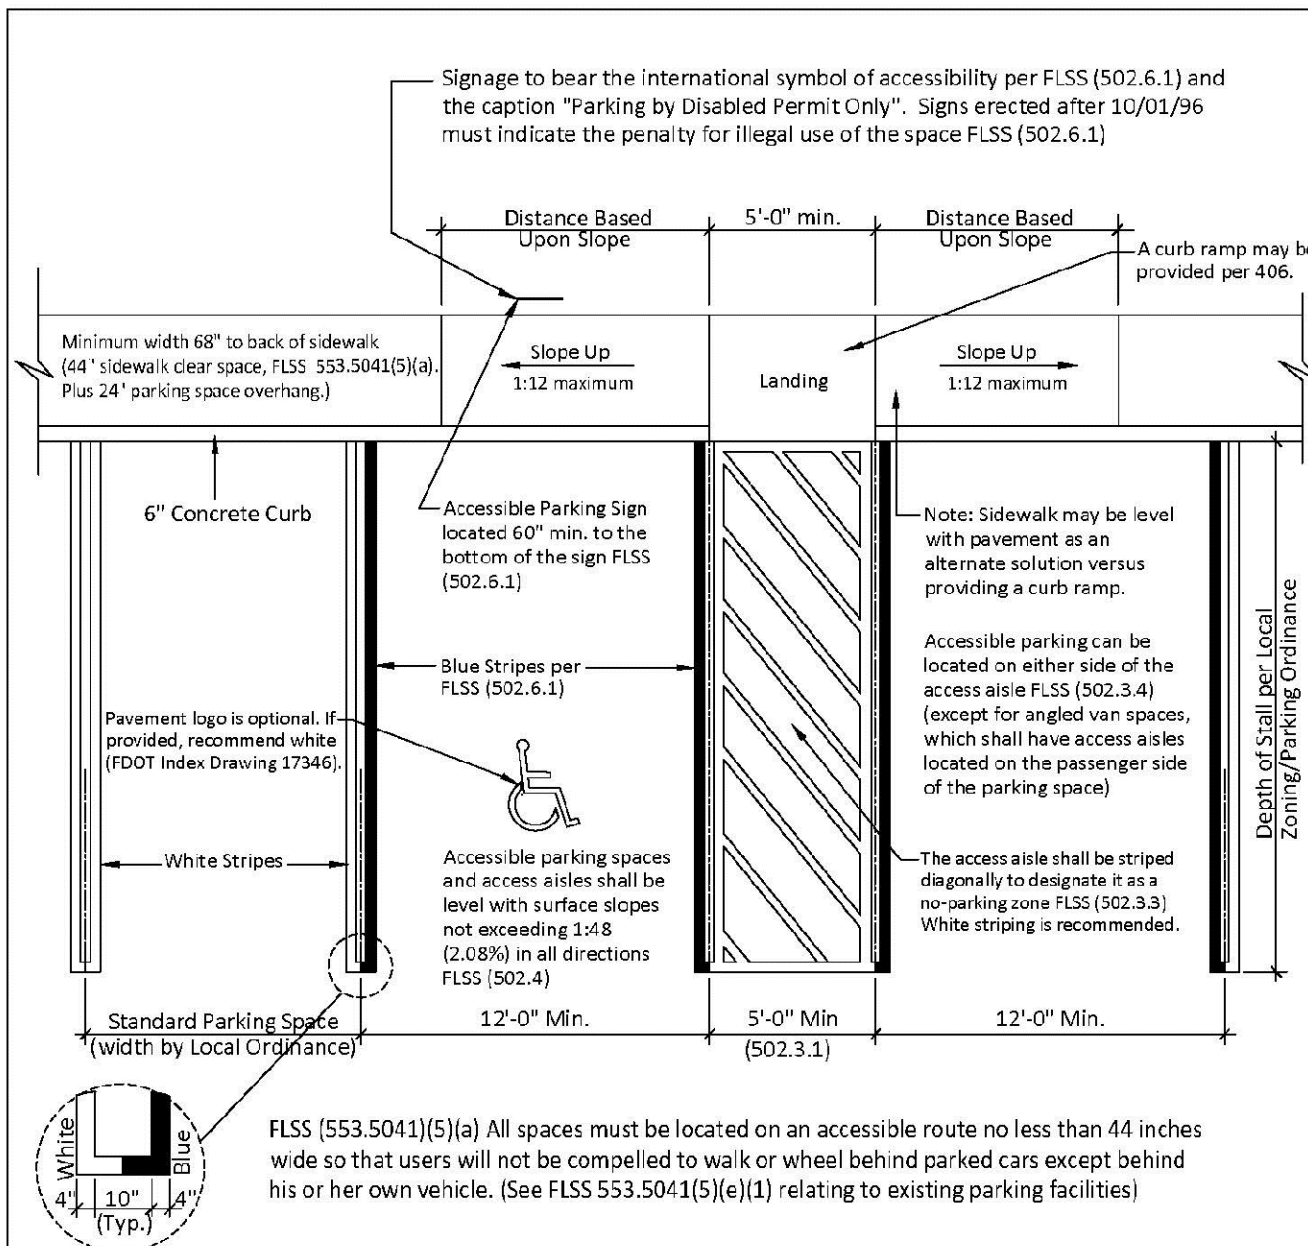

Recommended Accessible Parking Space (S)
Design for Double Line Requirements
N.T.S.

THIS TECHNICAL ASSISTANCE DOCUMENT IS INTENDED TO PROVIDE INFORMAL GUIDANCE AND DOES NOT CONSTITUTE A LEGAL INTERPRETATION OF STATUTORY OR REGULATORY CRITERIA.

ENGINEERING STANDARDS 2025			
REVISIONS		ENGINEERING DIVISION	ACCESSIBLE PARKING SPACES
BY	DATE		
		CITY OF POMPANO BEACH	
		SCALE: N.T.S.	DATE: MAY 2022 DWG. NO. 300-4

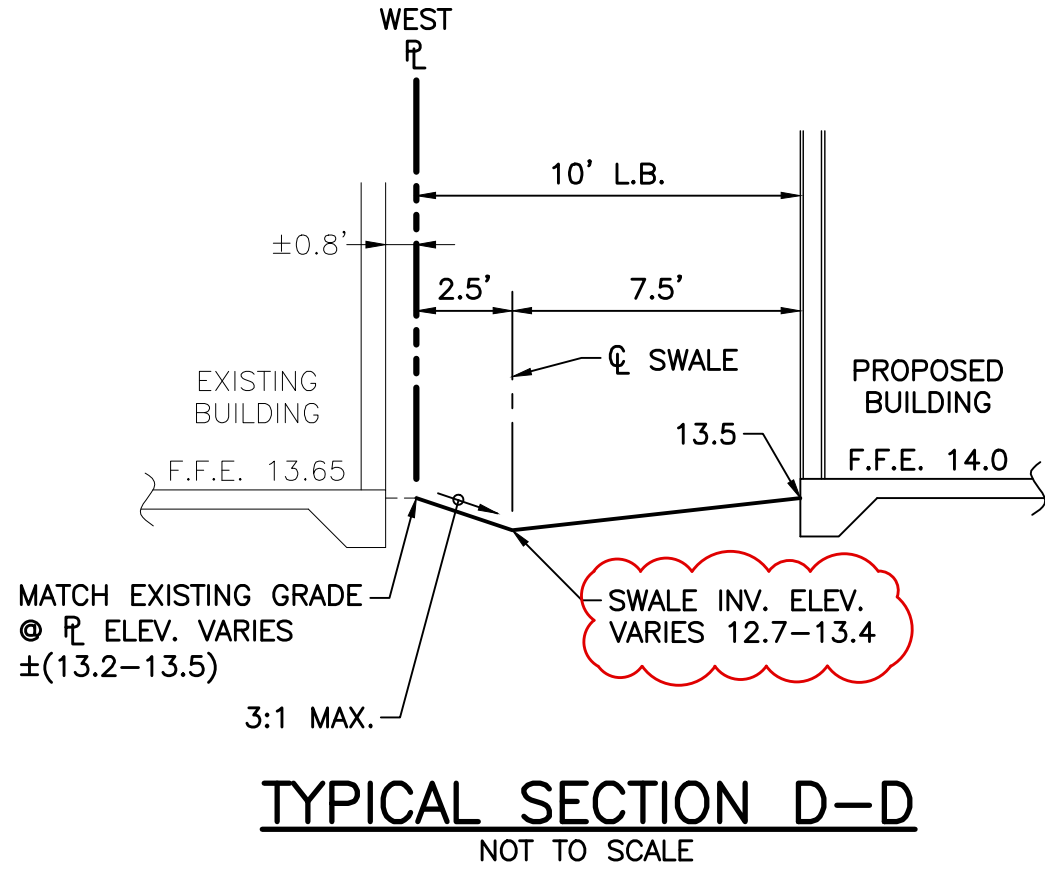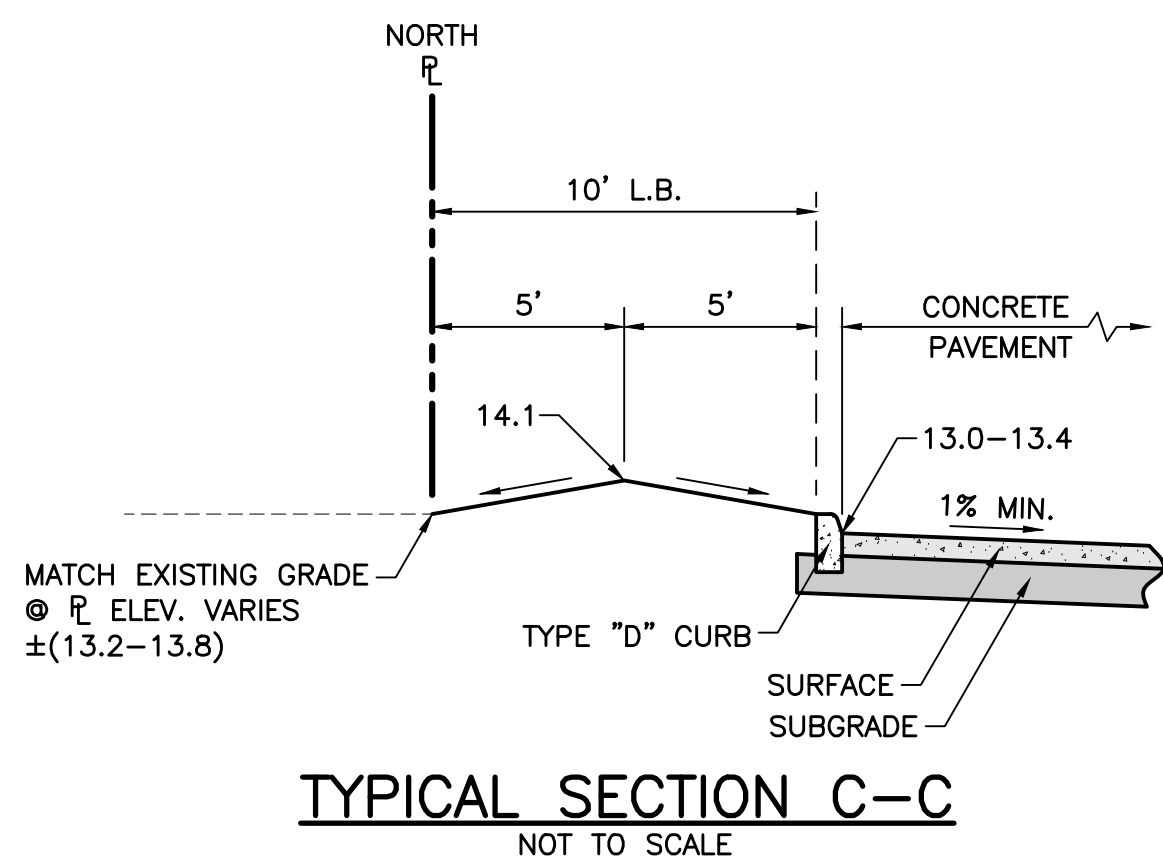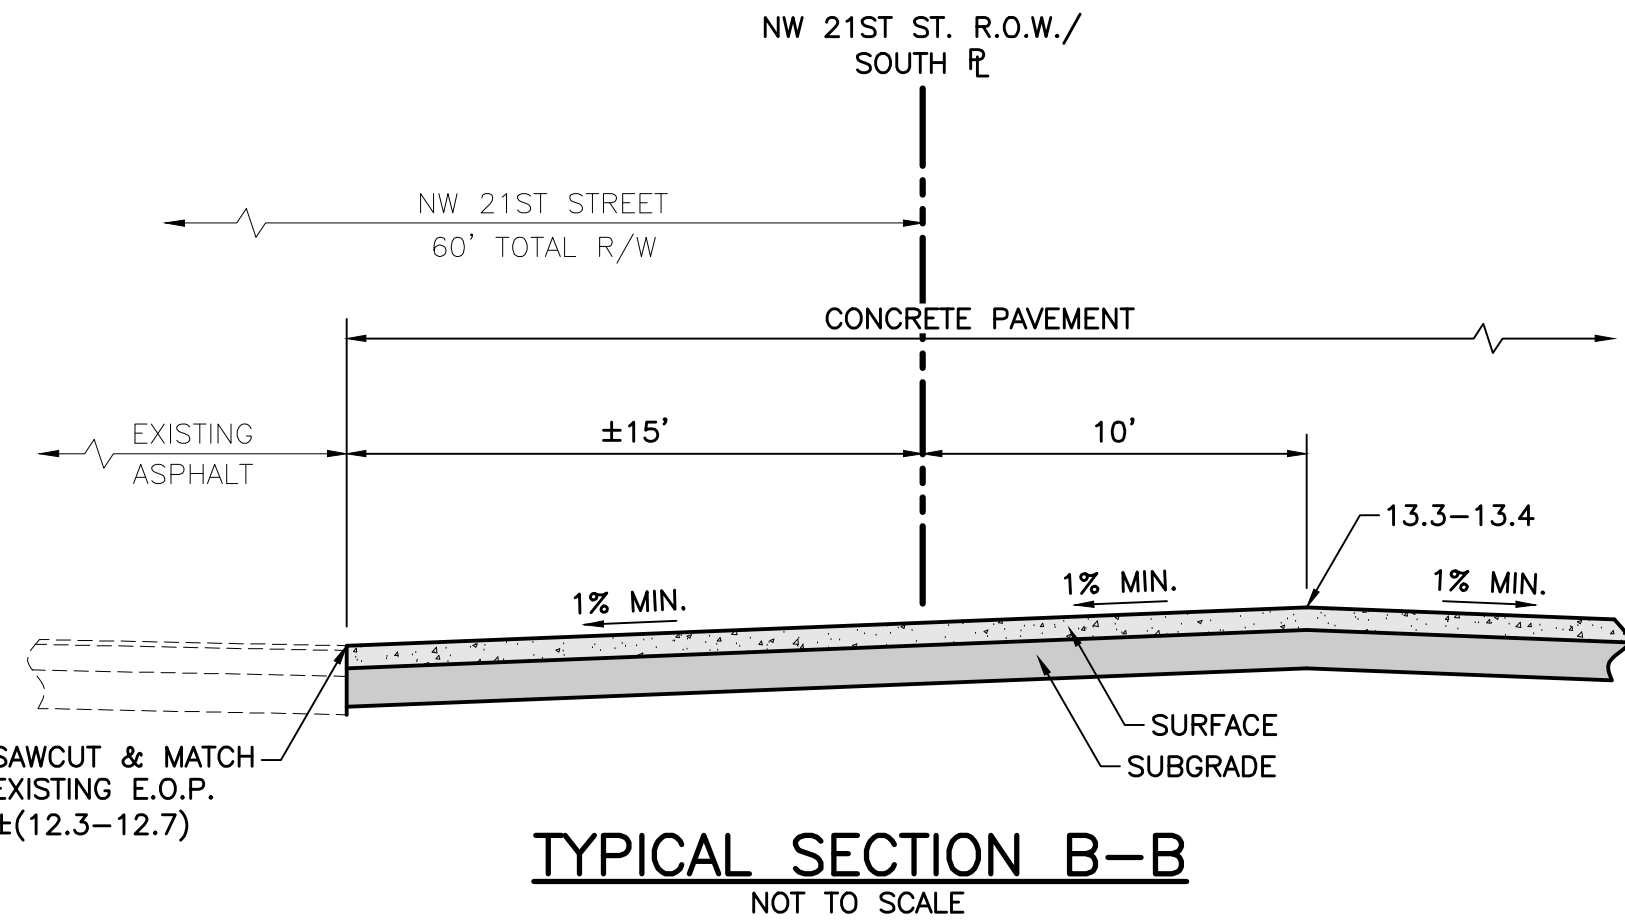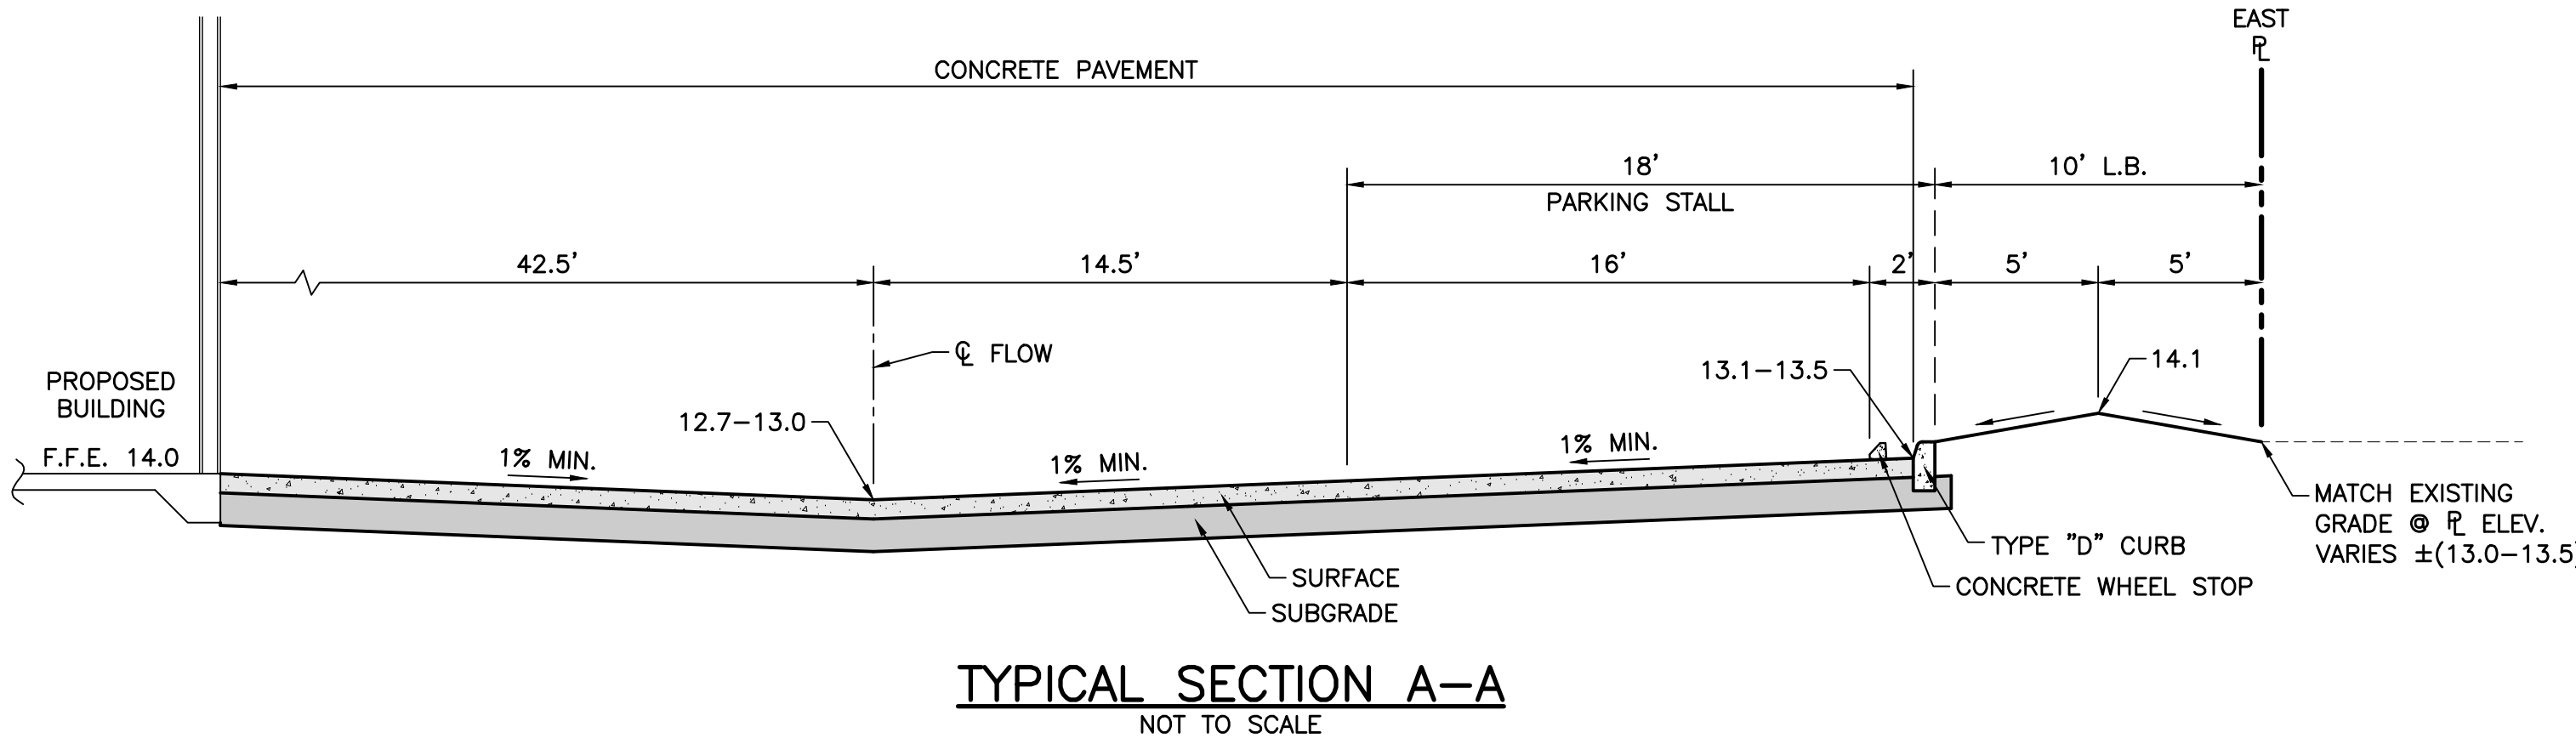

1857 NW 21ST STREET

HODGE MARINE
SECTION 27, TOWNSHIP 48S., RANGE 42E.
CITY OF POMPANO BEACH, FLORIDA
CONCEPTUAL
PAVING AND DRAINAGE DETAILS




1.) REVISED GRADE IN TYPICAL SECTION D-D PER DRC PLAN REVIEW, 08/12/25 D.B.

REVISIONS

DESIGN C.M. DRAWN B.L. CHECKED APPROVED DATE

JOB NO. 25-093 DRAWING NO. 25093C05 SHEET C-5 OF C-15

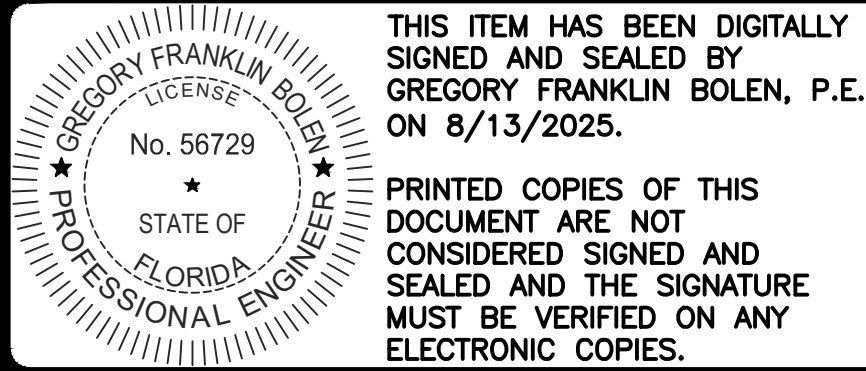

DRC

PZ25-1200024

09/17/2025 1:15 PM Daniel Brunet