




S ARCHITECTURE
33 SE 4TH STREET, SUITE 100
BOCA RATON, FL 33432
561.835.5515
WWW.SARCHITECTURE.COM
AA26003746

SEAL:

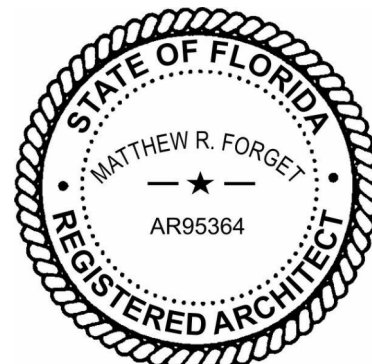

MATTHEW R. FORGET // REG. FL. NO. AR95364

DIGITAL SIGNATURE:

CLIENT / PROJECT ADDRESS:

HODGE MARINE

1857 NW 21ST STREET
POMPANO BEACH, FLORIDA 33069

REVISIONS:

NO.	DATE	DESCRIPTION
1	2025-06-12	DRC PLAN REVIEW

KEY PLAN:

PROJECT NUMBER: 24-057
DATE ISSUED: 2025-06-30


SHEET TITLE:

BUILDING SECTIONS

SHEET NO.:

A300

SITE PLAN APPROVAL

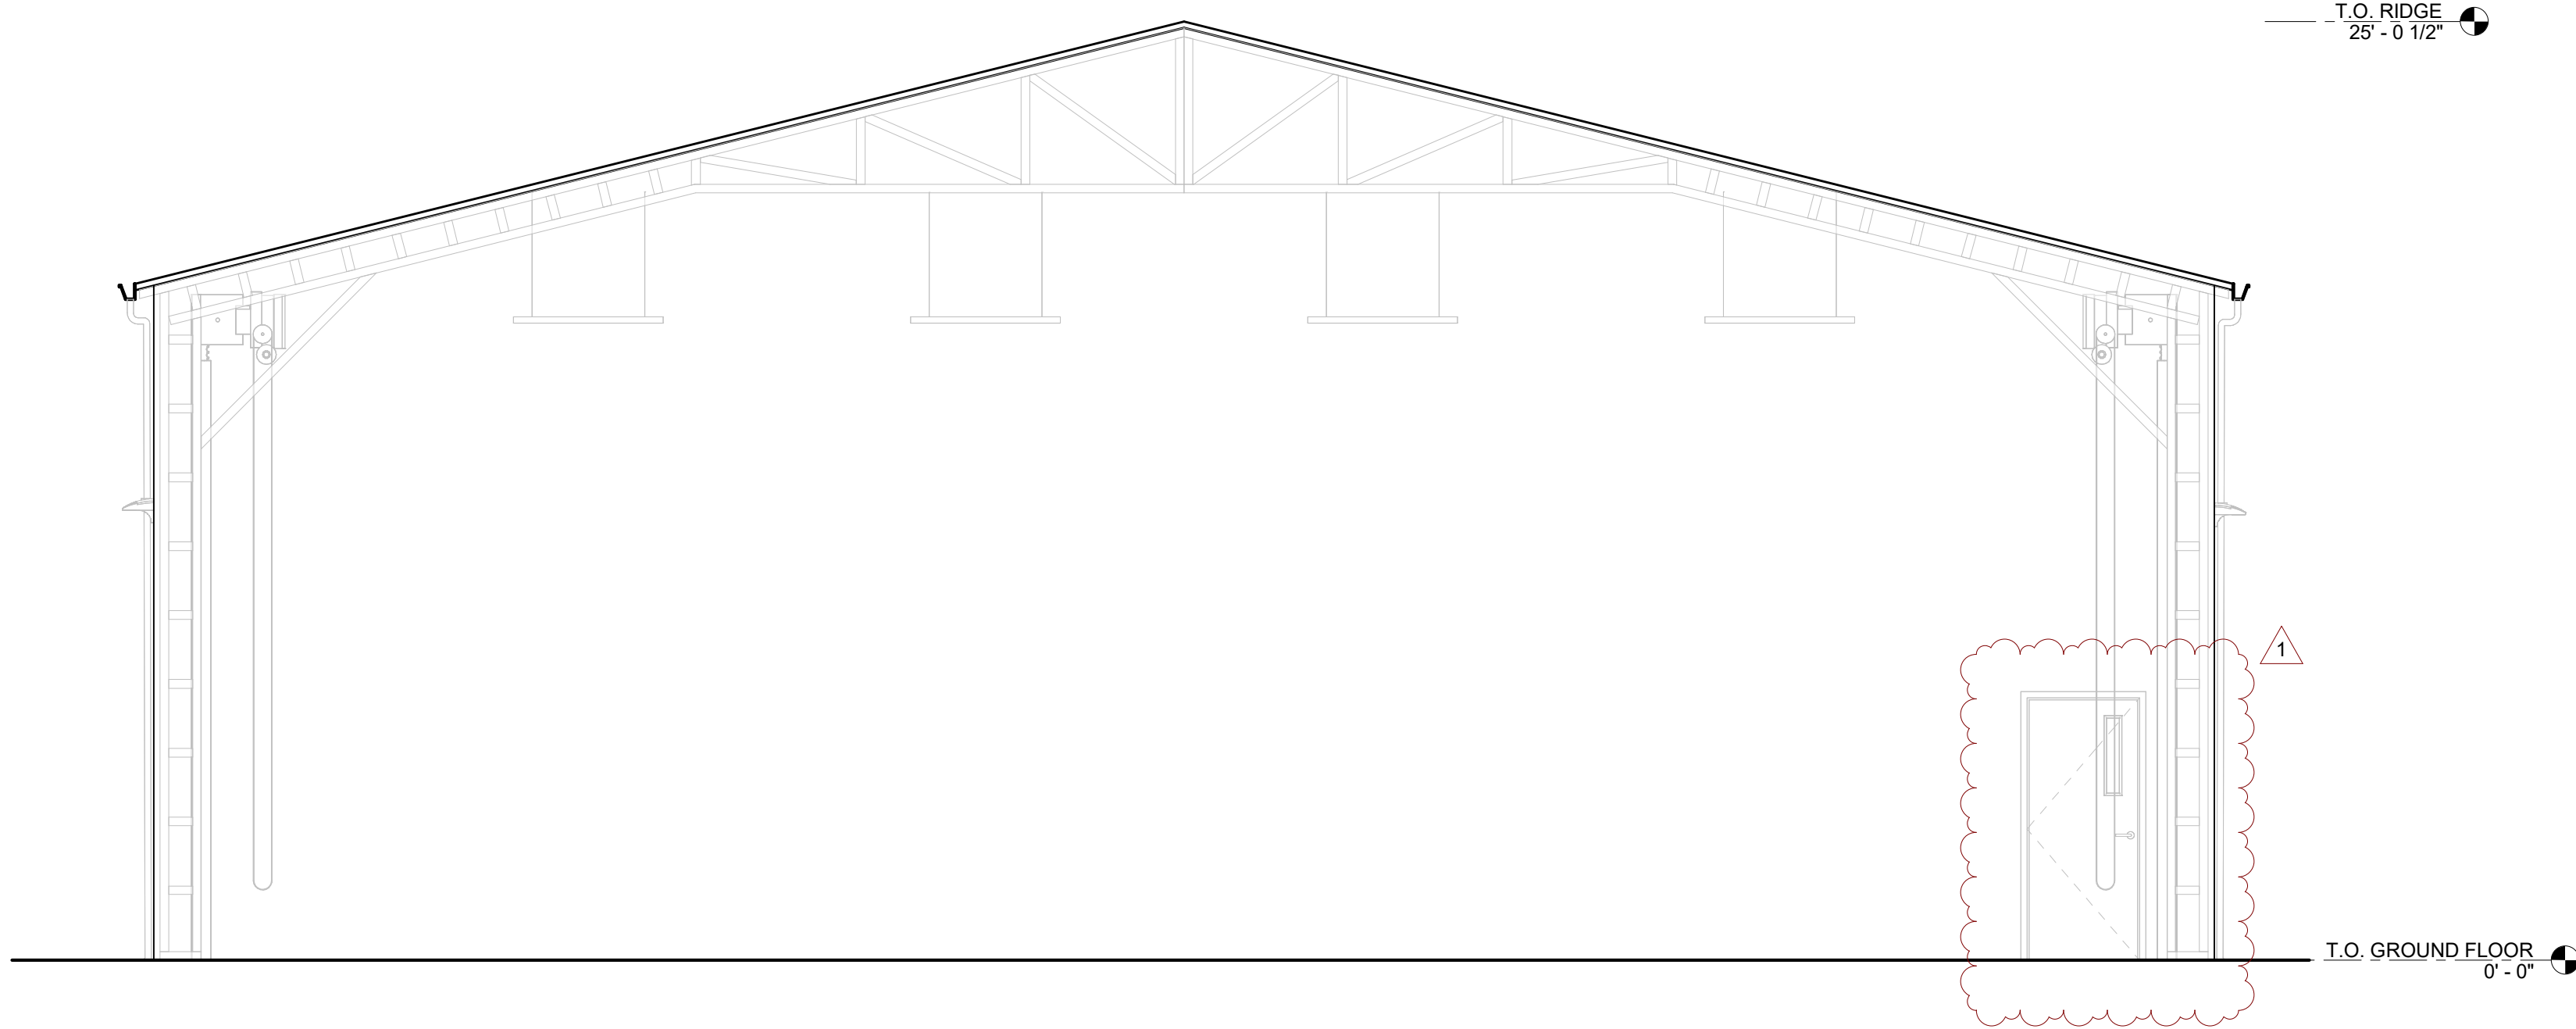

1 OVERALL SECTION 1
1/4" = 1'-0"

C:\Users\mz\Documents\24-057_Hodge Marine_205.rvt
2025-06-12 11:12

PZ25-12000024

09/17/2025

DRC