

FIALLO'S
MEP
DESIGN, INC

10010 SW 83rd St.
Miami, Florida 33173
305.877.1845
Jfiallo@fiallomepdesign.com

CA# 28637

EXISTING U-HAUL FACILITY # 788000

AS-BUILT PLANS

OWNER: UHAUL CO

790 SW 12th Ave, Pompano Beach, FL 33069


JORGE FIALLO FLORIDA P.E. #65527 <small>Drawings not valid unless Signed, Sealed and Dated by a Registered Professional</small>		
NO.	REVISIONS	DATE
▲		
▲		
JOB NUMBER: 21-400-00614		
ISSUE DATE: January, 2021		
DRAWN BY: T.M.		
CHECKED BY: J. FIALLO		
ISSUE:		

SECOND FLOOR PLAN

A-2.0

SHEET NUMBER

EXISTING BUILDING FLOOR AREA SUMMARY		
	OFFICE USE (SF)	STORAGE USE (SF)
FIRST FLOOR	0	7370
SECOND FLOOR	4077	0
BUILDING TOTAL	4077	7370

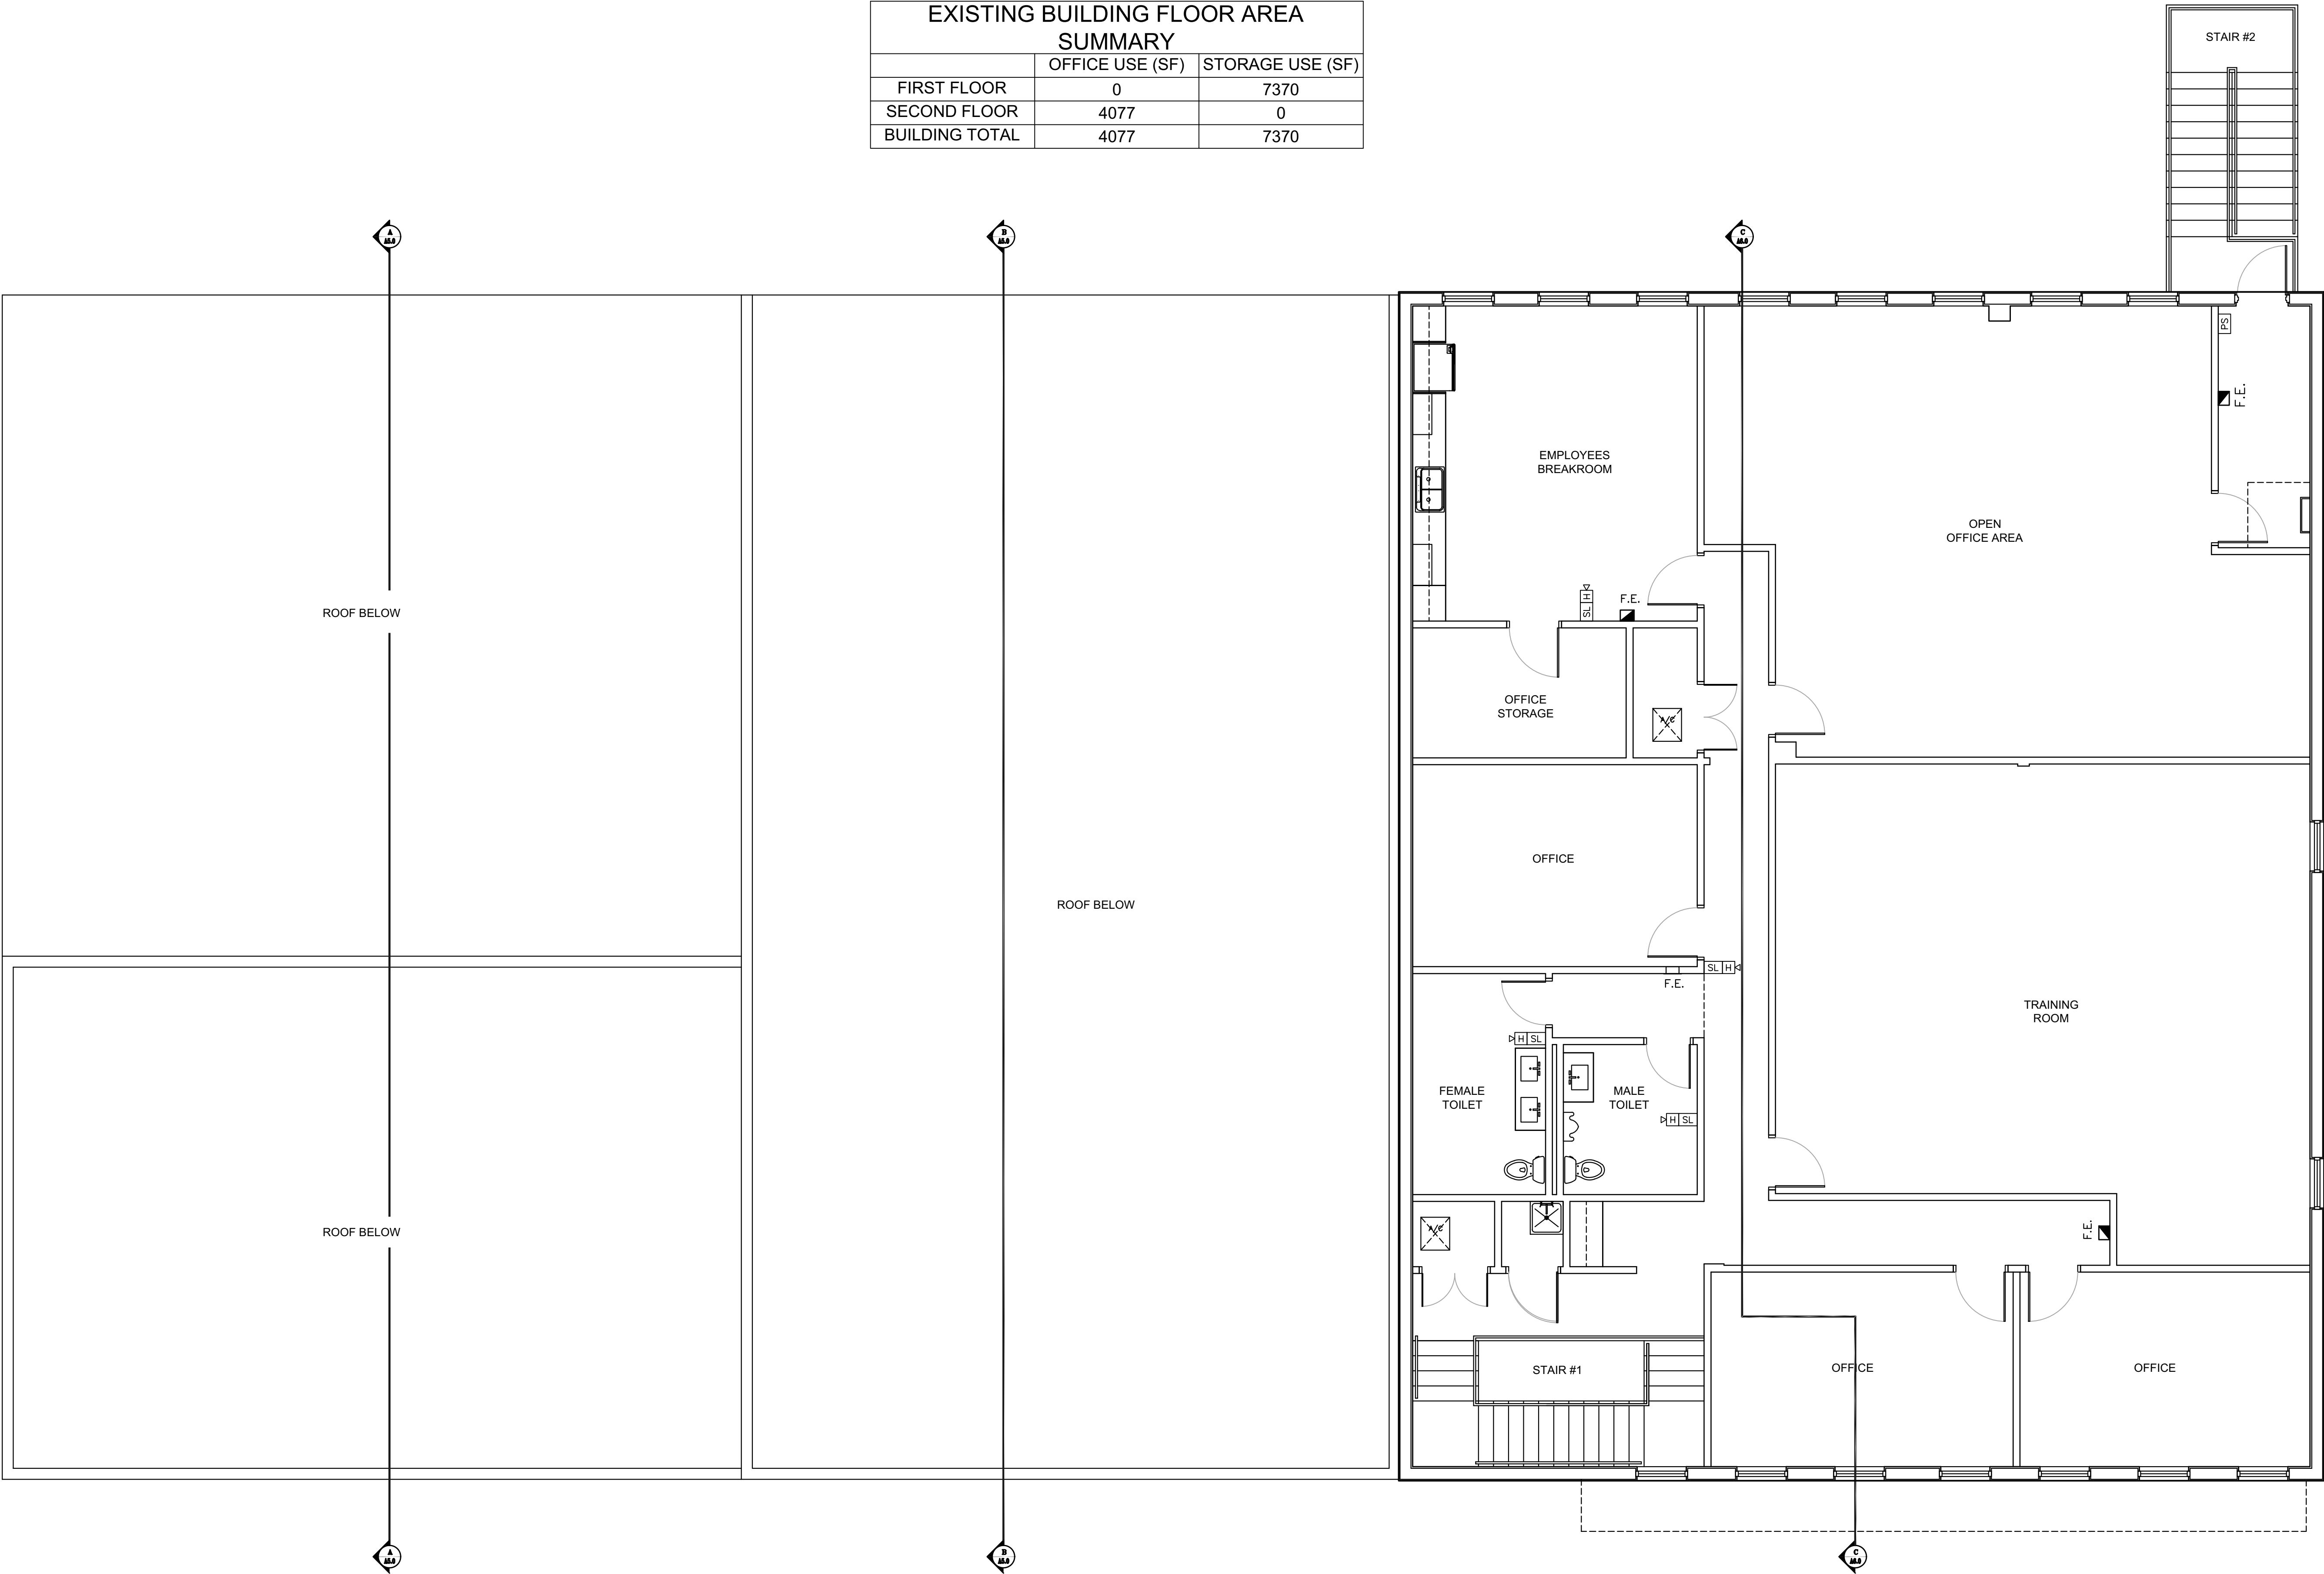

EXISTING SECOND FLOOR PLAN

SCALE : 1/4" = 1'-0"

