


EXISTING BUILDING FLOOR AREA SUMMARY		
	OFFICE USE (SF)	STORAGE USE (SF)
FIRST FLOOR	0	7370
SECOND FLOOR	4077	0
BUILDING TOTAL	4077	7370

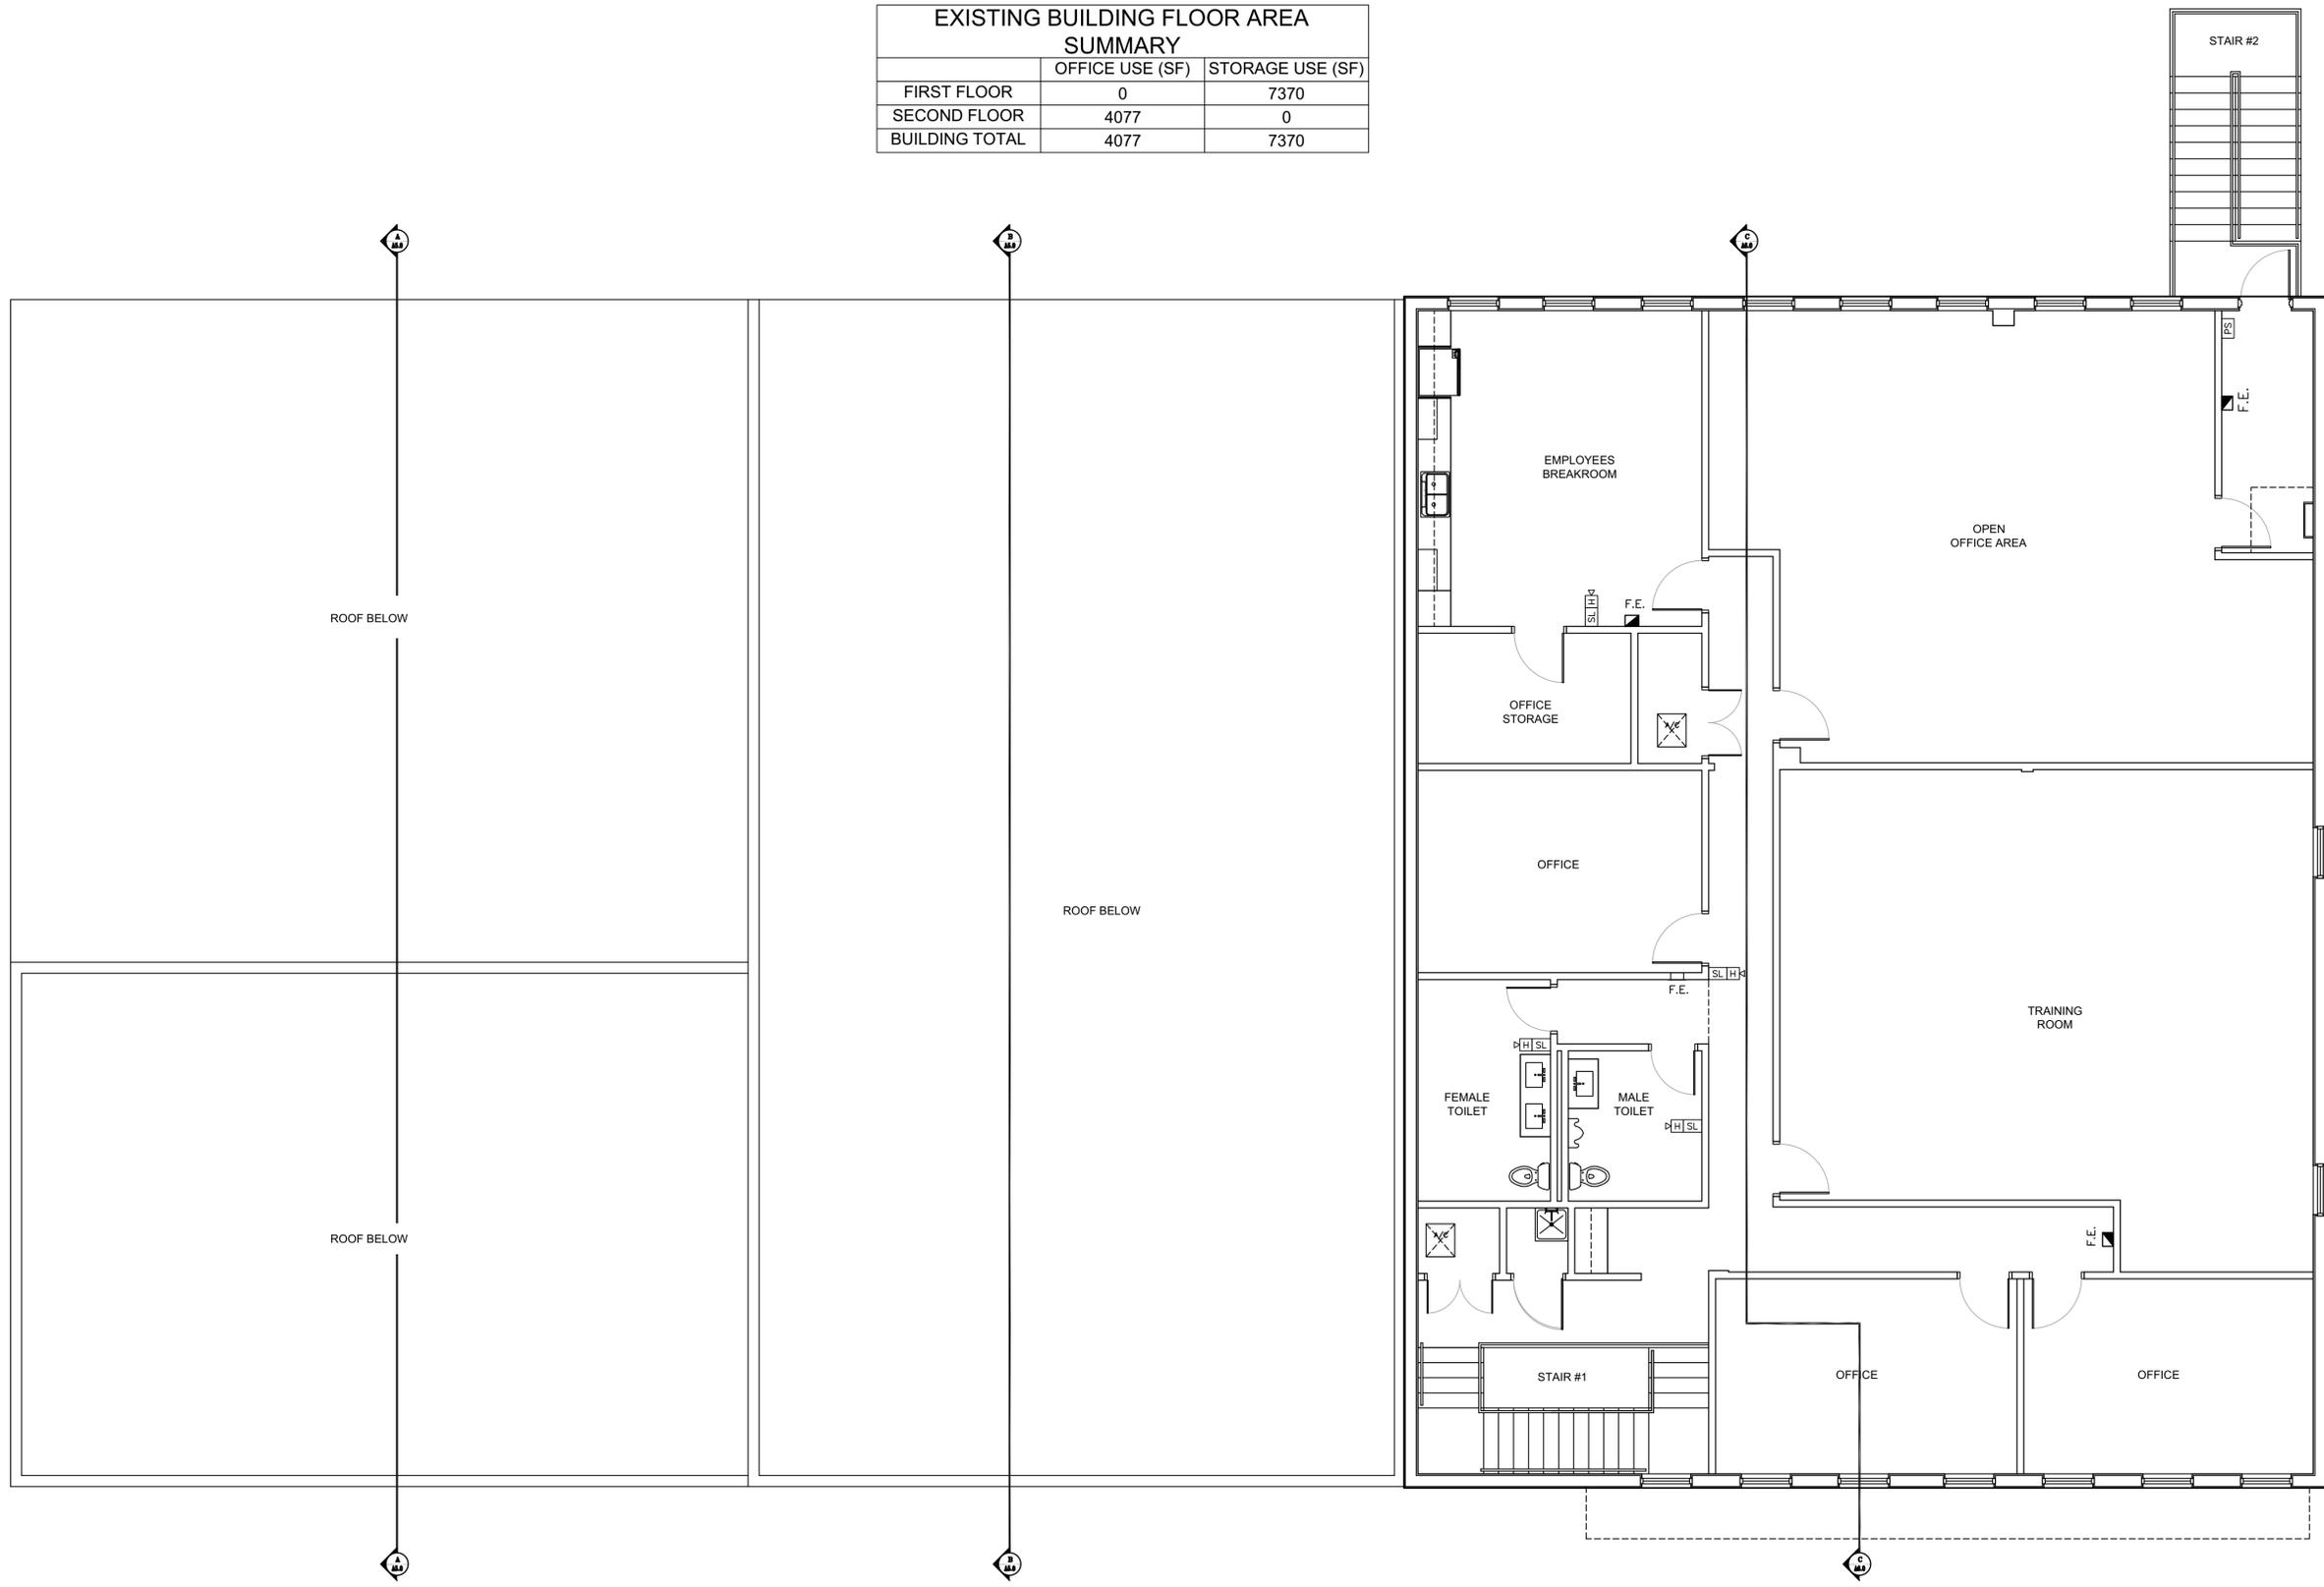

EXISTING SECOND FLOOR PLAN

SCALE: 1/4" = 1'-0"



**EXISTING U-HAUL FACILITY # 788000
AS-BUILT PLANS
OWNER: UHAUL CO
790 SW 12th Ave, Pompano Beach, FL 33069**

JORGE FIALLO
FLORIDA P.E. #65527
Drawings not valid unless signed, sealed
and dated by a Registered Professional

NO.	REVISIONS	DATE

JOB NUMBER:
21-400-00614

ISSUE DATE: January, 2021
DRAWN BY: T.M.
CHECKED BY: J. FIALLO
ISSUE:

SECOND FLOOR PLAN

A-2.0

SHEET NUMBER