



## CONTRACT MODIFICATION (CHANGE ORDER FORM)

CITY OF POMPANO BEACH

P.O. Drawer 1300

Pompano Beach, FL 33061

The City Manager has the authority to approve all construction change orders up to ten percent (**10%**) of the project's original total cost or **\$75,000.00**, whichever is lower, on a cumulative or aggregate basis. The City Commission must formally approve all other change orders in excess of the City Manager's approval authority **prior** to work being performed. The City Engineer, CIP Manager and Project Manager have the discretion to review and approve non-compensatory time-extensions as and when needed up to ninety (90) days or 25% of the Contract time, whichever is lower. The City Manager must be notified once the project is delayed by more than ninety (90) days, or 25% of the contract time, whichever is lower. Change Order is to pay for final work items which includes 5 new lighted crosswalks to enhance vehicular and pedestrian traffic.


Project Name:	SR A1A Improvements	Contract #:	874
Project Number:	191345	Date:	4/21/2025
Project Manager:	Fernand Thony		
Owner:	City of Pompano Beach	Change Order #	2
Contractor:	Burkhard Construction, Inc.		



**All items terms and conditions of the original contract #2019-92 dated 9/26/2029 remain unchanged and in full force and effect.**

The following modifications to the CONTRACT are hereby ordered:

CONTRACT AMOUNT			CONTRACT TIME (Calendar Days)		
Original	\$	3,282,404.39	Original Contract Time	653	Days
Previous Changes (+/-)	\$	0	Previous Changes (+/-)	638	Days
This Change Order (+/-)	\$	597,139.42	This Change Order (+/-)	180	Days
Revised Contract Amount	\$	3,879,543.81	Revised Contract Time	1471	Days
% change from Original (this CO)		18.19%	Cumulative COs	225	%
Revised Contract Completion Date Is		12/26/2025			

OWNER	CONSULTANT	CONTRACTOR
City of Pompano Beach	Burkhardt Construction, Inc	Burkhardt Construction, Inc
P.O. Box 1300	1400 Alabama avenue	1400 Alabama avenue
Pompano Beach, FL 33061	Lantana, Florida, 33462	Lantana, Florida, 33462

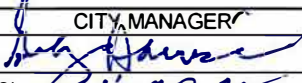CITY MANAGER
By: 
Date: 4-28-25

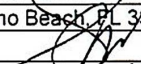CITY ENGINEER	GO BOND DIRECTOR	GENERAL SERVICES DIRECTOR
City of Pompano Beach	City of Pompano Beach	City of Pompano Beach
1201 NE 5 <sup>th</sup> Avenue	100 W Atlantic Boulevard	1190 NE 3 <sup>rd</sup> Avenue
Pompano Beach, FL 33060	Pompano Beach, FL 33060	Pompano Beach, FL 33060
By: John Sfropoulos	By: 	By: 
Date: 4/28/2025	Date: 4/21/2025	Date: Mary Rivero

Change Order Category	Sub Category
<input checked="" type="checkbox"/> Owners Request <input type="checkbox"/> Unforeseen <input type="checkbox"/> Consultant Error / Omission	<input type="checkbox"/> Regulatory Compliance <input type="checkbox"/> Safety/ Emergency

**A copy of the Contract Modification (Change Order) form must be attached to the Original Purchase Order for documentation purposes**

Witnesses:

Brandon Rhodes  
BRANDON RHODES  
Print Name

Vince Burkhardt  
VINCE BURKHARDT  
Print Name

**Burkhardt Construction. Inc**

By: Marc R. Kleisley, VICE PRESIDENT  
Marc R. Kleisley, Vice President




(SEAL)

STATE OF FLORIDA

COUNTY OF BROWARD

The foregoing instrument was acknowledged before me, by means of ☐ physical presence or ☐ online notarization, this 7 day of may, 2025, by MARC R. KLEISLEY as VICE PRESIDENT of BURKHARDT CONSTRUCTION, INC., a Florida corporation on behalf of the corporation. He is personally known to me or who has produced \_\_\_\_\_ (type of identification) as identification.

NOTARY'S SEAL:

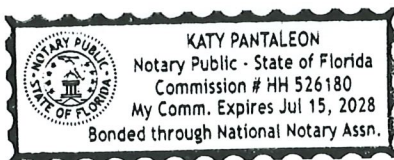

Katy Pantaleon  
NOTARY PUBLIC, STATE OF FLORIDA

Katy Pantaleon -  
(Name of Acknowledger Typed, Printed or Stamped)

HH 526180  
Commission Number

**“CITY”:**

**CITY OF POMPANO BEACH**

By: \_\_\_\_\_  
REX HARDIN, MAYOR

By: \_\_\_\_\_  
GREGORY P. HARRISON, CITY MANAGER

Attest:

\_\_\_\_\_  
KERVIN ALFRED, CITY CLERK

(SEAL)

Dated: \_\_\_\_\_

APPROVED AS TO FORM:

\_\_\_\_\_  
MARK E. BERMAN, CITY ATTORNEY



# CERTIFICATE OF LIABILITY INSURANCE

DATE (MM/DD/YYYY)  
10/01/2024

THIS CERTIFICATE IS ISSUED AS A MATTER OF INFORMATION ONLY AND CONFERS NO RIGHTS UPON THE CERTIFICATE HOLDER. THIS CERTIFICATE DOES NOT AFFIRMATIVELY OR NEGATIVELY AMEND, EXTEND OR ALTER THE COVERAGE AFFORDED BY THE POLICIES BELOW. THIS CERTIFICATE OF INSURANCE DOES NOT CONSTITUTE A CONTRACT BETWEEN THE ISSUING INSURER(S), AUTHORIZED REPRESENTATIVE OR PRODUCER, AND THE CERTIFICATE HOLDER.

**IMPORTANT:** If the certificate holder is an **ADDITIONAL INSURED**, the policy(ies) must have **ADDITIONAL INSURED** provisions or be endorsed. If **SUBROGATION IS WAIVED**, subject to the terms and conditions of the policy, certain policies may require an endorsement. A statement on this certificate does not confer rights to the certificate holder in lieu of such endorsement(s).

<b>PRODUCER</b> Brown & Brown Insurance Services, Inc. 1201 W Cypress Creek Rd Suite 130 Fort Lauderdale FL 33309		<b>CONTACT NAME:</b> <b>PHONE (A/C, No, Ext):</b> (954) 776-2222 <b>FAX (A/C, No):</b> (954) 776-4446 <b>E-MAIL ADDRESS:</b> 053.certs@bbrown.com		
<b>INSURED</b>  Burkhardt Construction, Inc. 1400 Alabama Avenue, Suite 20  West Palm Beach FL 33401-7048		<b>INSURER(S) AFFORDING COVERAGE</b>		<b>NAIC #</b>
		<b>INSURER A:</b> Amerisure Mutual Insurance Company		23396
		<b>INSURER B:</b> Amerisure Insurance Company		19488
		<b>INSURER C:</b> The North River Insurance Company		21105
		<b>INSURER D:</b> Lloyd's		85202
		<b>INSURER E:</b>		
<b>INSURER F:</b>				

## COVERAGES

CERTIFICATE NUMBER: 24-25

REVISION NUMBER:

THIS IS TO CERTIFY THAT THE POLICIES OF INSURANCE LISTED BELOW HAVE BEEN ISSUED TO THE INSURED NAMED ABOVE FOR THE POLICY PERIOD INDICATED. NOTWITHSTANDING ANY REQUIREMENT, TERM OR CONDITION OF ANY CONTRACT OR OTHER DOCUMENT WITH RESPECT TO WHICH THIS CERTIFICATE MAY BE ISSUED OR MAY PERTAIN, THE INSURANCE AFFORDED BY THE POLICIES DESCRIBED HEREIN IS SUBJECT TO ALL THE TERMS, EXCLUSIONS AND CONDITIONS OF SUCH POLICIES. LIMITS SHOWN MAY HAVE BEEN REDUCED BY PAID CLAIMS.

INSR LTR	TYPE OF INSURANCE	ADDL INSD	SUBR WVD	POLICY NUMBER	POLICY EFF (MM/DD/YYYY)	POLICY EXP (MM/DD/YYYY)	LIMITS
A	<input checked="" type="checkbox"/> COMMERCIAL GENERAL LIABILITY			GL208954111	10/01/2024	10/01/2025	EACH OCCURRENCE \$ 1,000,000
	<input type="checkbox"/> CLAIMS-MADE <input checked="" type="checkbox"/> OCCUR	Y	DAMAGE TO RENTED PREMISES (Ea occurrence) \$ 1,000,000				
			MED EXP (Any one person) \$ 10,000				
			PERSONAL & ADV INJURY \$ 1,000,000				
GEN'L AGGREGATE LIMIT APPLIES PER:						GENERAL AGGREGATE \$ 2,000,000	
	<input type="checkbox"/> POLICY <input checked="" type="checkbox"/> PRO-JECT <input type="checkbox"/> LOC					PRODUCTS - COMP/OP AGG \$ 2,000,000	
	OTHER:						\$
B	<b>AUTOMOBILE LIABILITY</b>			CA208954211	10/01/2024	10/01/2025	COMBINED SINGLE LIMIT (Ea accident) \$ 1,000,000
	<input checked="" type="checkbox"/> ANY AUTO		BODILY INJURY (Per person) \$				
	<input type="checkbox"/> OWNED AUTOS ONLY <input type="checkbox"/> SCHEDULED AUTOS		BODILY INJURY (Per accident) \$				
	<input type="checkbox"/> HIRED AUTOS ONLY <input type="checkbox"/> NON-OWNED AUTOS ONLY		PROPERTY DAMAGE (Per accident) \$				
C	<input checked="" type="checkbox"/> UMBRELLA LIAB <input checked="" type="checkbox"/> OCCUR			5821241013	10/01/2024	10/01/2025	EACH OCCURRENCE \$ 4,000,000
	<input type="checkbox"/> EXCESS LIAB <input type="checkbox"/> CLAIMS-MADE		AGGREGATE \$ 8,000,000				
	<input type="checkbox"/> DED <input checked="" type="checkbox"/> RETENTION \$ 0		\$				
	WORKERS COMPENSATION AND EMPLOYERS' LIABILITY						PER STATUTE <input type="checkbox"/> OTH-ER <input type="checkbox"/>
	ANY PROPRIETOR/PARTNER/EXECUTIVE OFFICER/MEMBER EXCLUDED? (Mandatory in NH)	<input type="checkbox"/> Y <input type="checkbox"/> N	N/A				E.L. EACH ACCIDENT \$
	If yes, describe under DESCRIPTION OF OPERATIONS below						E.L. DISEASE - EA EMPLOYEE \$
D	Professional Liability			KAE0001549	07/22/2024	07/22/2025	Per Claim \$1,000,000
			Aggregate \$1,000,000				
			Deductible \$15,000				

DESCRIPTION OF OPERATIONS / LOCATIONS / VEHICLES (ACORD 101, Additional Remarks Schedule, may be attached if more space is required)

Project: 19353 - SR A1A Improvements  
Certificate holder and Pompano Beach CRA listed as additional insured as respects General Liability if required by written contract.

## CERTIFICATE HOLDER

## CANCELLATION

City of Pompano Beach 100 W. Atlantic Blvd. Rm276  Pompano Beach FL 33060	SHOULD ANY OF THE ABOVE DESCRIBED POLICIES BE CANCELLED BEFORE THE EXPIRATION DATE THEREOF, NOTICE WILL BE DELIVERED IN ACCORDANCE WITH THE POLICY PROVISIONS.
	AUTHORIZED REPRESENTATIVE 

© 1988-2015 ACORD CORPORATION. All rights reserved.



4/2/25



Fernand:

Please see the attached proposal for the Lighted Crosswalk Signalization within A1A Streetscape PH I. This system was not a part of the latest A1A Streetscape Plans / Project and was requested by the City of Pompano Beach. We understand this work was approved by FDOT and we would like to move forward if approved. BCI (which term includes all BCI's agents, employees, and Board members) provides no express or implied warranties concerning the fitness, suitability, or quality for the intended use of the solar light system, and agrees to install such solar light system on the City's express representation that FDOT has approved such solar light system and that, except as otherwise provided in this paragraph, the City bears full and sole responsibility for the solar light system, including the fitness for purpose, design, placement, use, and functionality of such solar light system. To that end, the City agrees, to the maximum extent permitted by law, to indemnify, defend, save, and hold harmless BCI from any liability, claim, demand, suit, loss, cost, expense or damage, including attorneys' fees and costs through all levels of appeal, which may be asserted, claimed, or recovered against or from BCI, by reason of any property or other damages or personal injury, including death, sustained by any person whomsoever, which damage is incidental to, occurs as a result of, arises out of, or is otherwise related to the fitness for purpose, design, placement, use, or functionality of the solar lights. However, for a period of twelve (12) months from installation, BCI shall warrant (1) the workmanship of the installation of the solar light system, and (2) against defective, malfunctioning materials in the solar light system, both warranties being contingent upon proper maintenance of the solar light system by the City.

Also, due to the present volatile nature of the construction market, construction material costs could change substantially prior to construction. Due to the recent tariffs and the potential for future tariffs, material prices are increasing anywhere from 5% to 15% per month. The pricing does not include any assumed material price increases. Material price increases may be passed through to the Owner with proper documentation or paid for with construction contingency. Please see below for additional information.

Sincerely,

Brandon Rhodes, Project Manager for Burkhardt Construction, Inc.



1/30/2025

## In Roadway Lighted Solar Crosswalks

5 Crosswalks per attached Marked Up Plans and Shop Drawings

Description	Unit Price				Subtotal
Gereico F&I (See Backup Proposal)	5 EA	\$	80,763.24	\$	403,816.18
MOT	1 LS	\$	60,000.00	\$	60,000.00
Concrete Restoration for ADA Compliance (Including Demo, Regrade, New Concrete)	400 SF	\$	12.00	\$	4,800.00
Surveying (Allowance)	1 LS	\$	5,000.00	\$	5,000.00
5% Contingency	1 LS	\$	24,000.00	\$	24,000.00
SUBTOTALS:				\$	497,616.18
BCI MARKUP				\$	99,523.24
TOTAL:				\$	<b>597,139.42</b>

SEE THE NEXT PAGE FOR EXCLUSIONS AND CLARIFICATIONS

**Exclusions and Clarifications:**

The additional work is requested by the City of Pompano and it's based on FDOT approval.  
This system is not a part of the latest A1A Streetscape Plans / Project.

BCI (which term includes all BCI's agents, employees, and Board members) provides no express or implied warranties concerning the fitness, suitability, or quality for the intended use of the solar light system, and agrees to install such solar light system on the City's express representation that FDOT has approved such solar light system and that, except as otherwise provided in this paragraph, the City bears full and sole responsibility for the solar light system, including the fitness for purpose, design, placement, use, and functionality of such solar light system. To that end, the City agrees, to the maximum extent permitted by law, to indemnify, defend, save, and hold harmless BCI from any liability, claim, demand, suit, loss, cost, expense or damage, including attorneys' fees and costs through all levels of appeal, which may be asserted, claimed, or recovered against or from BCI, by reason of any property or other damages or personal injury, including death, sustained by any person whomsoever, which damage is incidental to, occurs as a result of, arises out of, or is otherwise related to the fitness for purpose, design, placement, use, or functionality of the solar lights. However, for a period of twelve (12) months from installation, BCI shall warrant (1) the workmanship of the installation of the solar light system, and (2) against defective, malfunctioning materials in the solar light system, both warranties being contingent upon proper maintenance of the solar light system by the City.

There is an 8-12 week lead time once change order is approved.

Terms and Conditions still apply from original contract dated March 30, 2022.

Proposal is valid for 30 days after date of submission.

Lighted Crosswalk Installation will occur during FDOT approved night time ours.

Pricing does not include landscape or irrigation.

Pricing does not include asphalt restoration, water, sewer, and/or storm drainage.

Pricing does not include permit fees.

Attached are the marked up plans of proposed locations of the lighted crosswalks.

Attached are the submittals of the materials being used for the lighted crosswalks.

# Gerelco Traffic Controls, Inc.

<b>To:</b>	Burkhardt Construction	<b>Contact:</b>	Brandon Rhodes
<b>Address:</b>	1400 Alabama Ave, Suite 20 West Palm Beach, FL 33401	<b>Phone:</b>	
<b>Project Name:</b>	CO SR A1A Improvement Project #19353 Crosswalks	<b>Bid Number:</b>	24012101
<b>Project Location:</b>	A1A Pompano Beach, Pompano Beach, FL	<b>Bid Date:</b>	1/21/2025

Item #	Item Description	Estimated Quantity	Unit	Unit Price	Total Price
<b>Roadway</b>					
101-1	Mobilization	1.00	LS	\$13,556.18	\$13,556.18
654-1-20	In Roadway Light Assembly, F&I, Solar Power,	5.00	AMBY	\$78,052.00	\$390,260.00
<b>Total Price for above Roadway Items:</b>					<b>\$403,816.18</b>

**Total Bid Price: \$403,816.18**

## Notes:

- Our proposal is valid for 30 days following the date of bid submission. Exceptions may be granted upon written request.
- Permit fees are not included.
- Surveying and layout are not included.
- MOT requiring lane closures, traffic diversions, detours, or police officers necessary for the safe work by Gerelco is to be handled by OTHERS. MOT Devices including but not limited to Message Boards, Arrow Boards, Light Plants, Barrier Walls, Cones, Drums, Crash Cushions, ECT to be handled by others.

# RECEIVED

BURKHARDT  
CONSTRUCTION, INC.

***By brandon at 8:32:34 AM, 1/22/2025***

## ACCEPTED:

The above prices, specifications and conditions are satisfactory and are hereby accepted.

**Buyer:** \_\_\_\_\_

**Signature:** \_\_\_\_\_

**Date of Acceptance:** \_\_\_\_\_

## CONFIRMED:

**Gerelco Traffic Controls, Inc.**

**Authorized Signature:** \_\_\_\_\_

**Estimator:** Carlos Vera

772-201-0634 CVera@gerelco.com


**3 OF 20**

RECEIVED

BURKHARDT  
CONSTRUCTION, INC.

By brandon at 8:01:25 AM, 11/11/2022

BEGIN PROJECT  
BEGIN CONSTRUCTION  
BEGIN MILLING & RESURFACING FPID# 441628-2-58-01  
STA 95+00.00  
SURVEY SR A1A (OCEAN BLVD.)

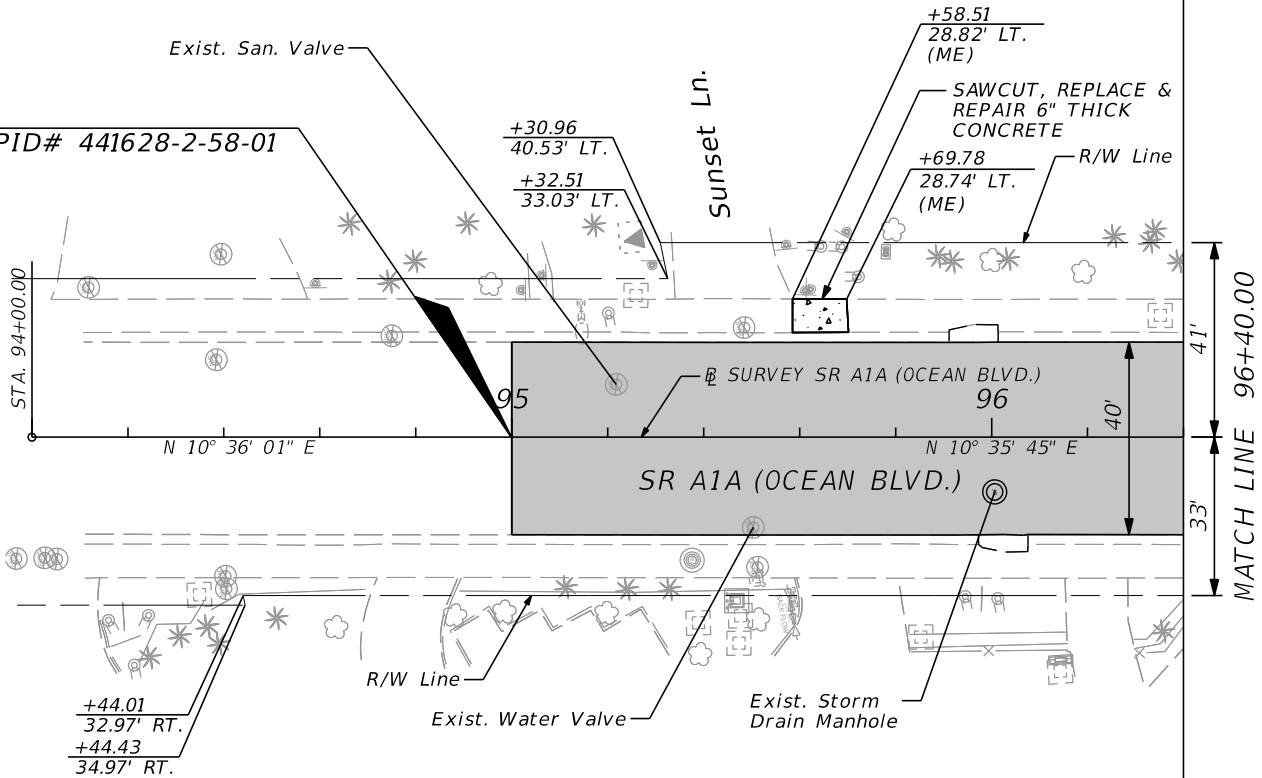

LEGEND

- 6" CONCRETE
- LIMITS OF MILLING AND RESURFACING (1-1/2")
- (ME) MATCH EXISTING

REVISIONS				LORI J. TREVIRANUS, P.E. P.E. LICENSE NUMBER 73684 KEITH AND ASSOCIATES, INC. 301 EAST ATLANTIC BOULEVARD POMPAÑO BEACH, FL 33060	STATE OF FLORIDA DEPARTMENT OF TRANSPORTATION			ROADWAY PLAN	SHEET NO. 9
DATE	DESCRIPTION	DATE	DESCRIPTION		ROAD NO.	COUNTY	FINANCIAL PROJECT ID		
					SR A1A	BROWARD	N/A		


THE OFFICIAL RECORD OF THIS SHEET IS THE ELECTRONIC FILE DIGITALLY SIGNED AND SEALED UNDER RULE 61G15-23.004, F.A.C.

PHASE I SUBMITTAL  
NOT FOR CONSTRUCTION  
PRELIMINARY AND SUBJECT TO CHANGE

Approved  
2020-C-491-00008  
Roger Lemieux  
6/13/2022

4 OF 20



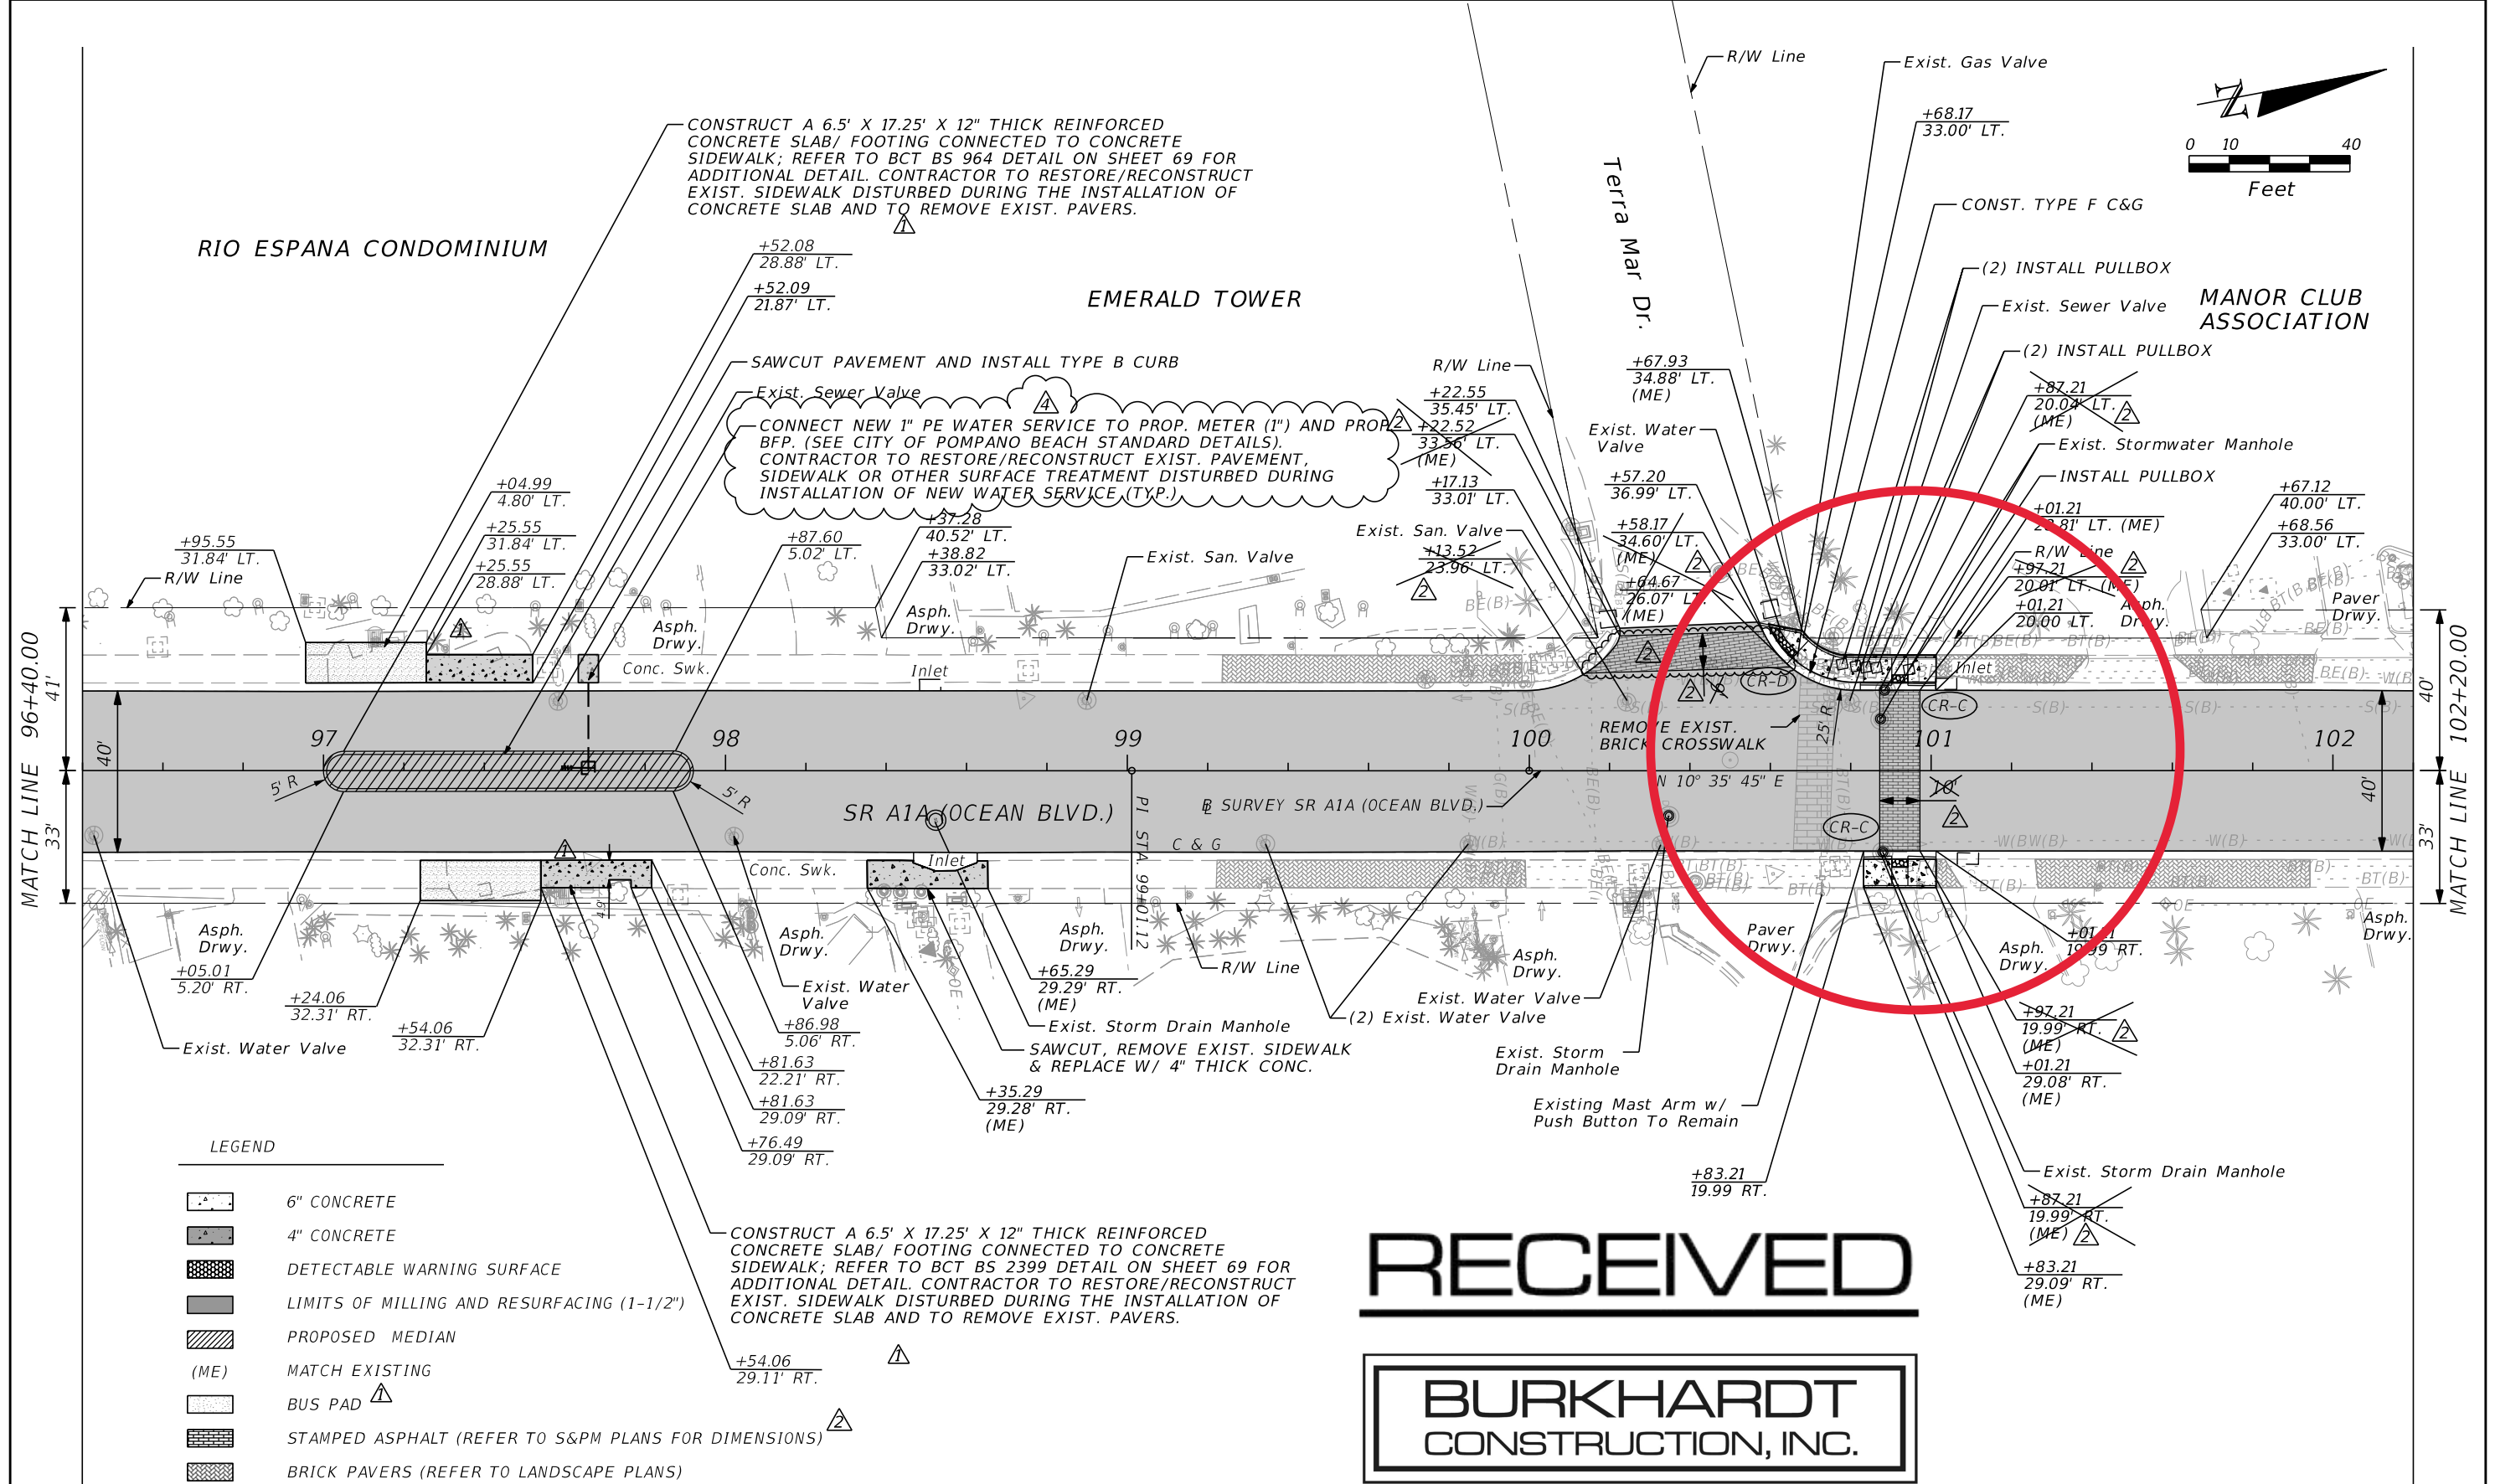

RIO ESPANA CONDOMINIUM

EMERALD TOWER

MANOR CLUB ASSOCIATION



LEGEND

- 6" CONCRETE
- 4" CONCRETE
- DETECTABLE WARNING SURFACE
- LIMITS OF MILLING AND RESURFACING (1-1/2")
- PROPOSED MEDIAN
- (ME) MATCH EXISTING
- BUS PAD
- STAMPED ASPHALT (REFER TO S&PM PLANS FOR DIMENSIONS)
- BRICK PAVERS (REFER TO LANDSCAPE PLANS)

REVISIONS				DATE	DESCRIPTION	DATE	DESCRIPTION	SHEET NO.
DATE	DESCRIPTION	DATE	DESCRIPTION					
1/3/22	Adjusted bus pad shape, update description on legend and sheet number and added text	6/1/22	Added text to legend, removed text labels, and updated crosswalk					
		9/15/22	Modified text					

LORI J. TREVIRANUS, P.E.  
P.E. LICENSE NUMBER 73684  
KEITH AND ASSOCIATES, INC.  
301 EAST ATLANTIC BOULEVARD  
POMPAHO BEACH, FL 33060

By brandon at 8:01:30 AM, 11/11/2022

STATE OF FLORIDA  
DEPARTMENT OF TRANSPORTATION

ROAD NO.

COUNTY

FINANCIAL PROJECT ID

SR A1A

BROWARD

N/A

ROADWAY PLAN

10


bhitt 9/19/2022 9:19:48 AM Default Q:\10654.04 -SR A1A Streetscape Improvements - COPB (KEITH Prime)\Highway - FDOT\cadd\Phase 1 PB No. 19353-CADD\roadway\PLANRD01.dgn

THE OFFICIAL RECORD OF THIS SHEET IS THE ELECTRONIC FILE DIGITALLY SIGNED AND SEALED UNDER RULE 61G15-23.004, F.A.C.





RENAISSANCE III CONDO ASSOCIATION

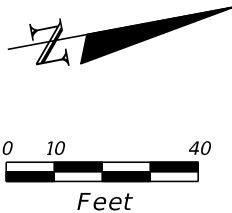

7 OF 20

RECEIVED

BURKHARDT CONSTRUCTION INC.

CONSTRUCT REINFORCED CONCRETE BUS PAD; REFER TO BCT DETAIL A ON SHEET 69. CONTRACTOR TO RESTORE/RECONSTRUCT EXIST. SIDEWALK DISTURBED DURING THE INSTALLATION OF CONCRETE SLAB.

RENAISSANCE II CONDO


***By brandon at 8:01:41 AM, 11/11/2022***

REVISIONS				LORI J. TREVIRANUS, P.E. P.E. LICENSE NUMBER 73684 KEITH AND ASSOCIATES, INC. 301 EAST ATLANTIC BOULEVARD POMPANO BEACH, FL 33060	STATE OF FLORIDA DEPARTMENT OF TRANSPORTATION			ROADWAY PLAN	SHEET NO.
DATE	DESCRIPTION	DATE	DESCRIPTION		ROAD NO.	COUNTY	FINANCIAL PROJECT ID		12
1/3/22	△ Update description on legend and sheet number and added text								
9/15/22	△ Removed proposed pullbox and associated label								

THE OFFICIAL RECORD OF THIS SHEET IS THE ELECTRONIC FILE DIGITALLY SIGNED AND SEALED UNDER RULE 61G15-23.004, F.A.C.





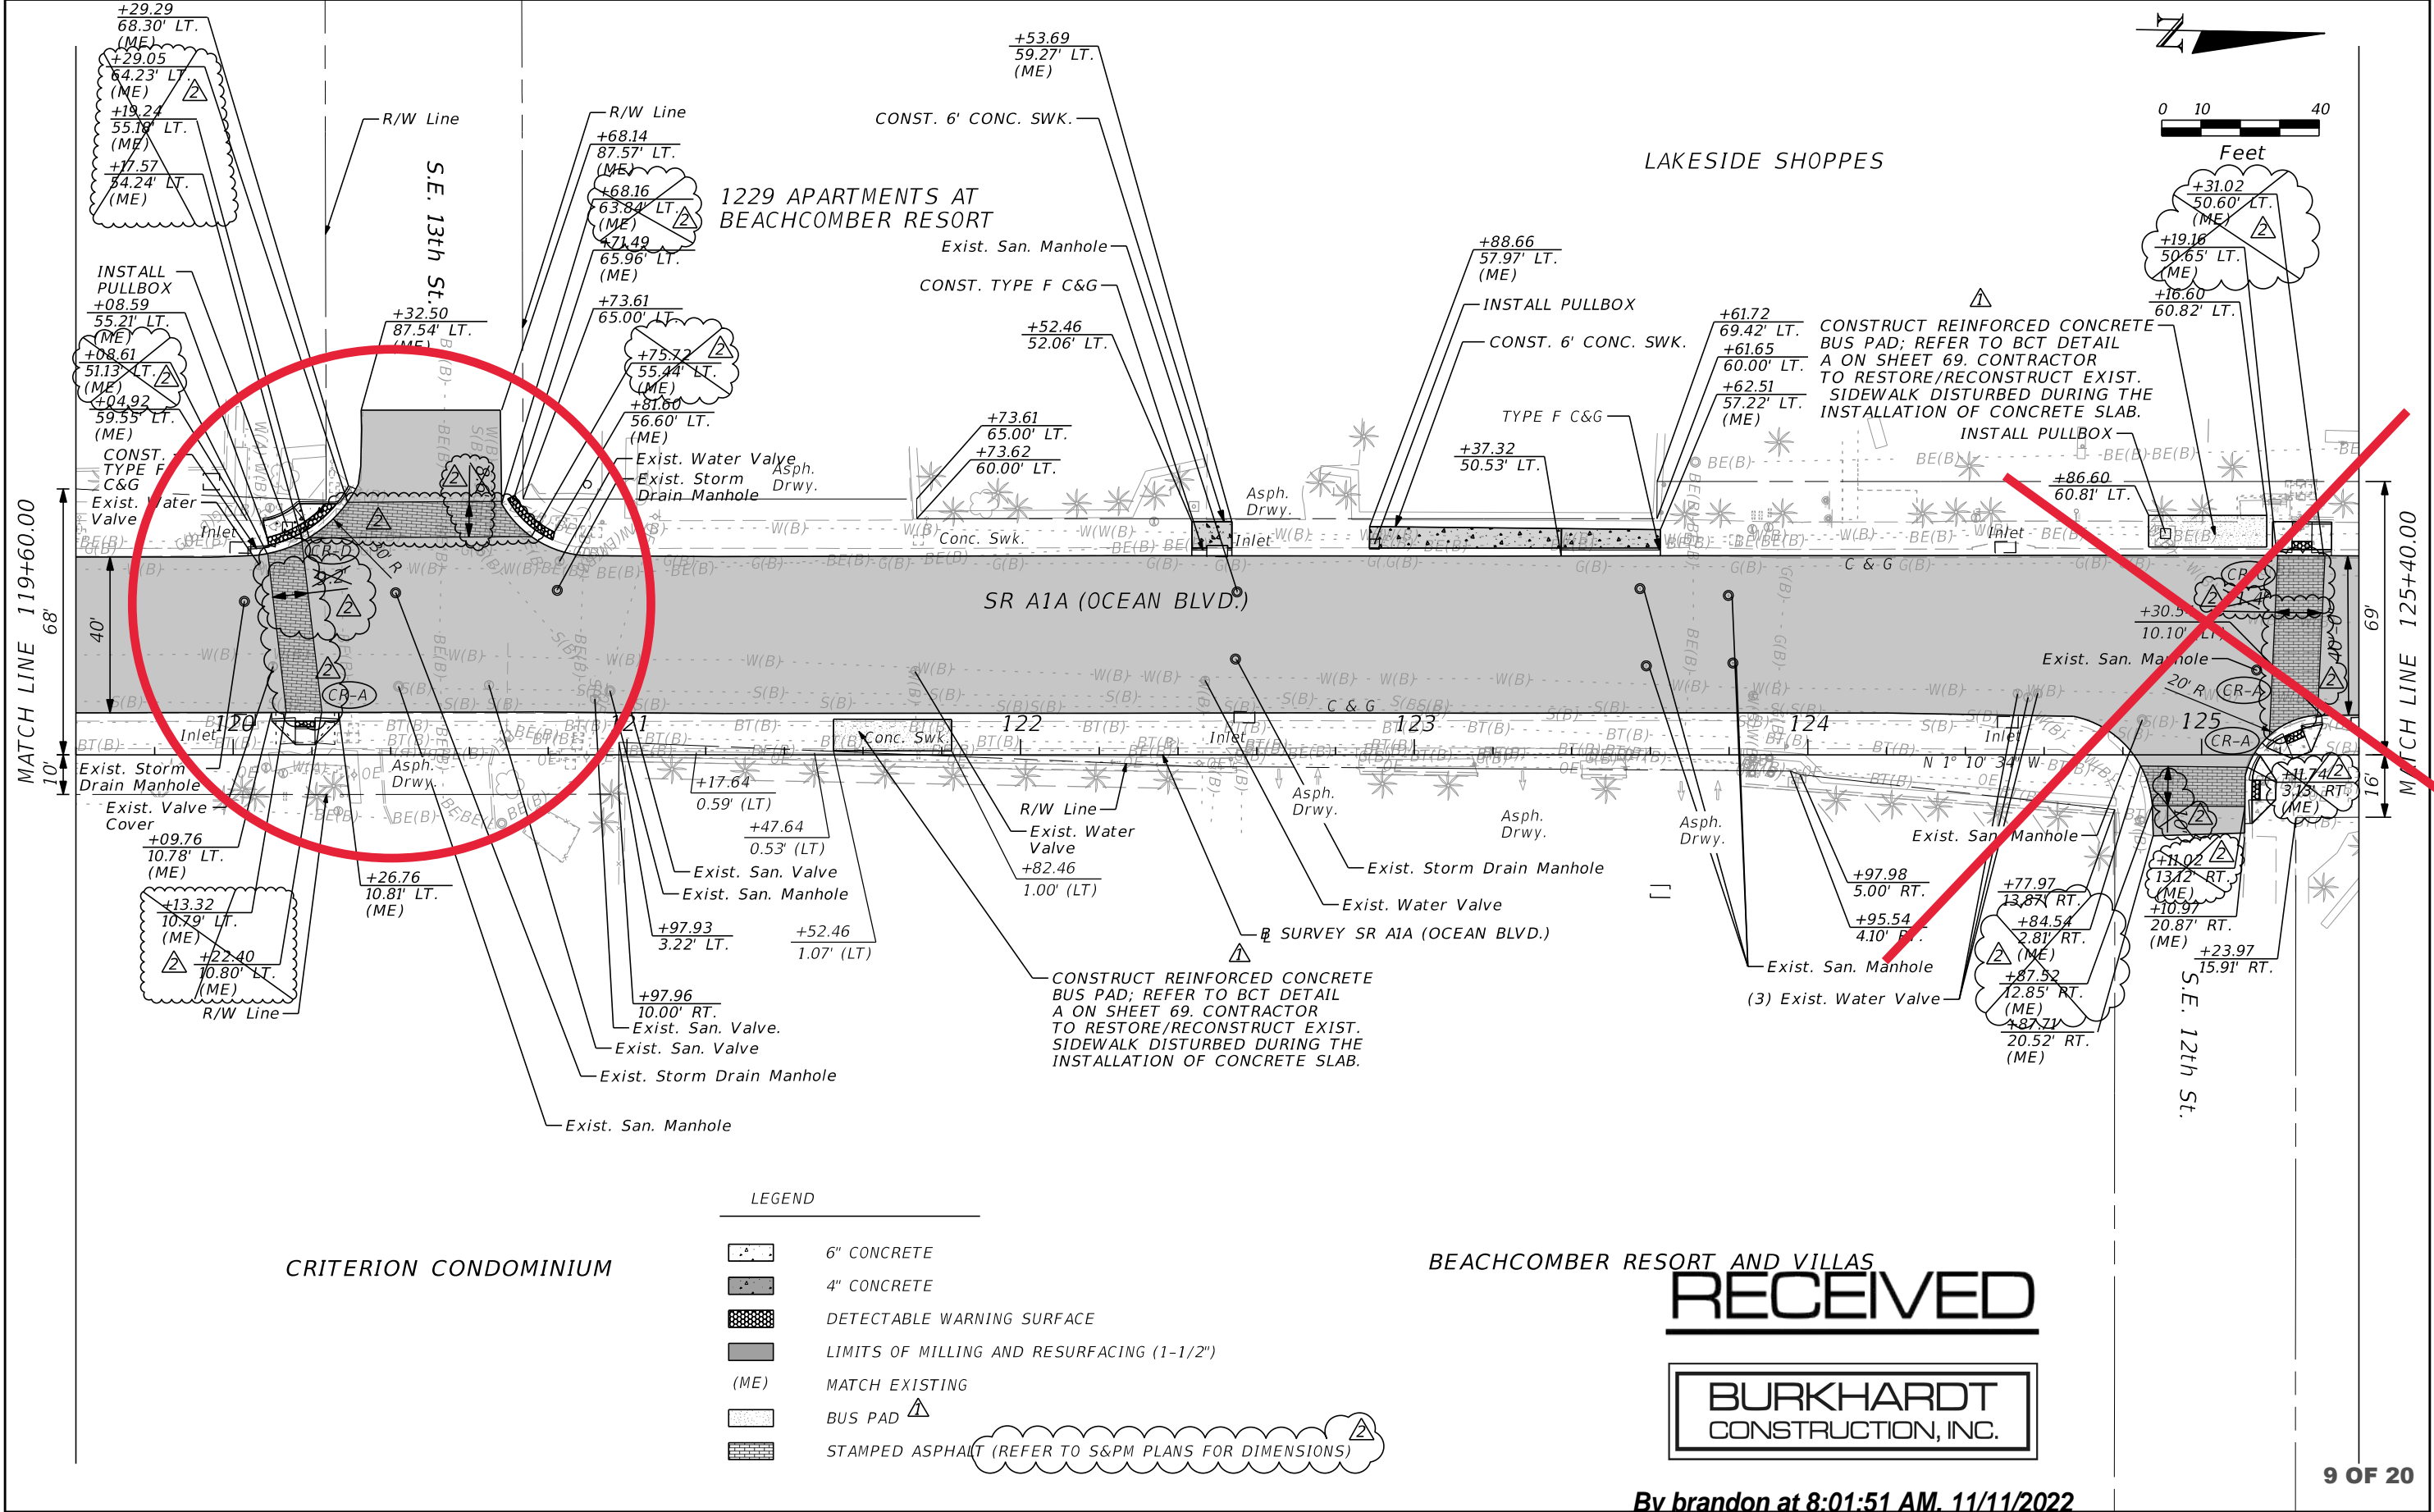


REVISIONS				LORI J. TREVIRANUS, P.E. P.E. LICENSE NUMBER 73684 KEITH AND ASSOCIATES, INC. 301 EAST ATLANTIC BOULEVARD POMPANO BEACH, FL 33060	STATE OF FLORIDA DEPARTMENT OF TRANSPORTATION			ROADWAY PLAN	SHEET NO.  14
DATE	DESCRIPTION	DATE	DESCRIPTION		ROAD NO.	COUNTY	FINANCIAL PROJECT ID		
1/3/22	Update description on legend and sheet number and added text	6/10/22	Added text to legend, removed text labels, and updated (3) crosswalks		SR A1A	BROWARD	N/A		


By brandon at 8:01:51 AM, 11/11/2022

9 OF 20

THE OFFICIAL RECORD OF THIS SHEET IS THE ELECTRONIC FILE DIGITALLY SIGNED AND SEALED UNDER RULE 61G15-23.004, F.A.C.

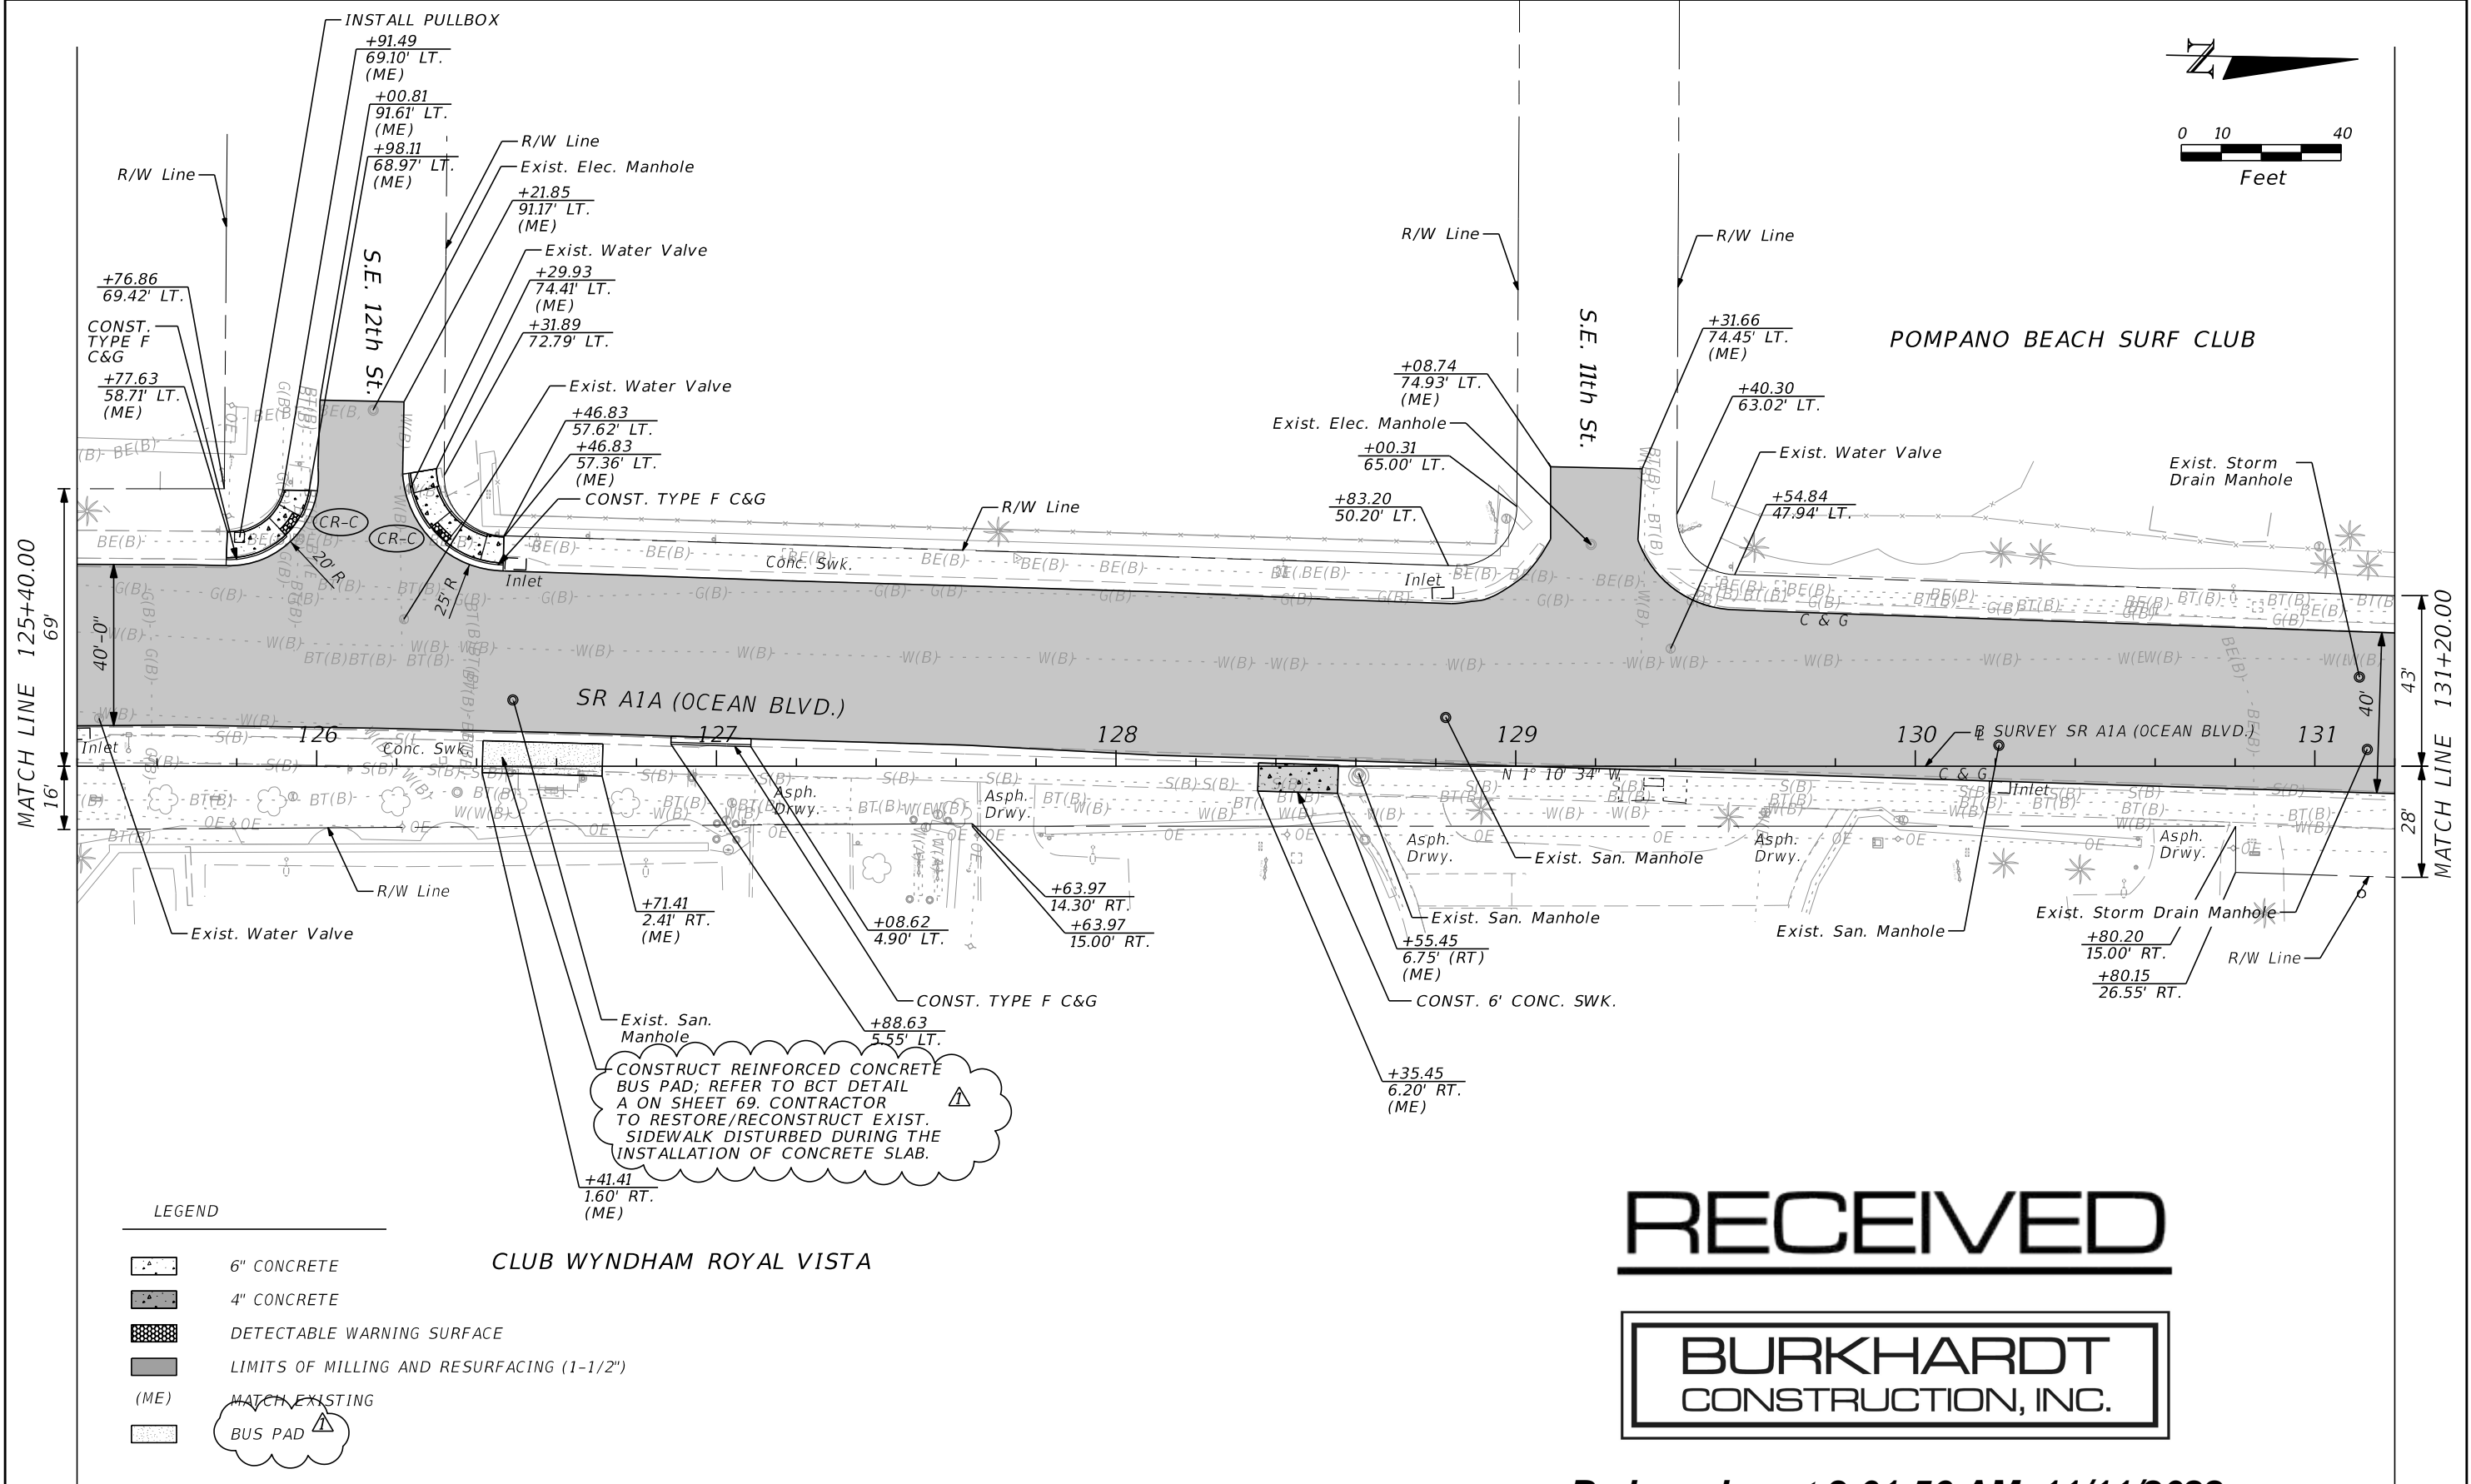

REVISIONS				LORI J. TREVIRANUS, P.E. P.E. LICENSE NUMBER 73684 KEITH AND ASSOCIATES, INC. 301 EAST ATLANTIC BOULEVARD POMPAÑO BEACH, FL 33060	STATE OF FLORIDA DEPARTMENT OF TRANSPORTATION			ROADWAY PLAN	SHEET NO.  15
DATE	DESCRIPTION	DATE	DESCRIPTION		ROAD NO.	COUNTY	FINANCIAL PROJECT ID		
1/3/22	Update description on legend and sheet number and added text				SR A1A	BROWARD	N/A		

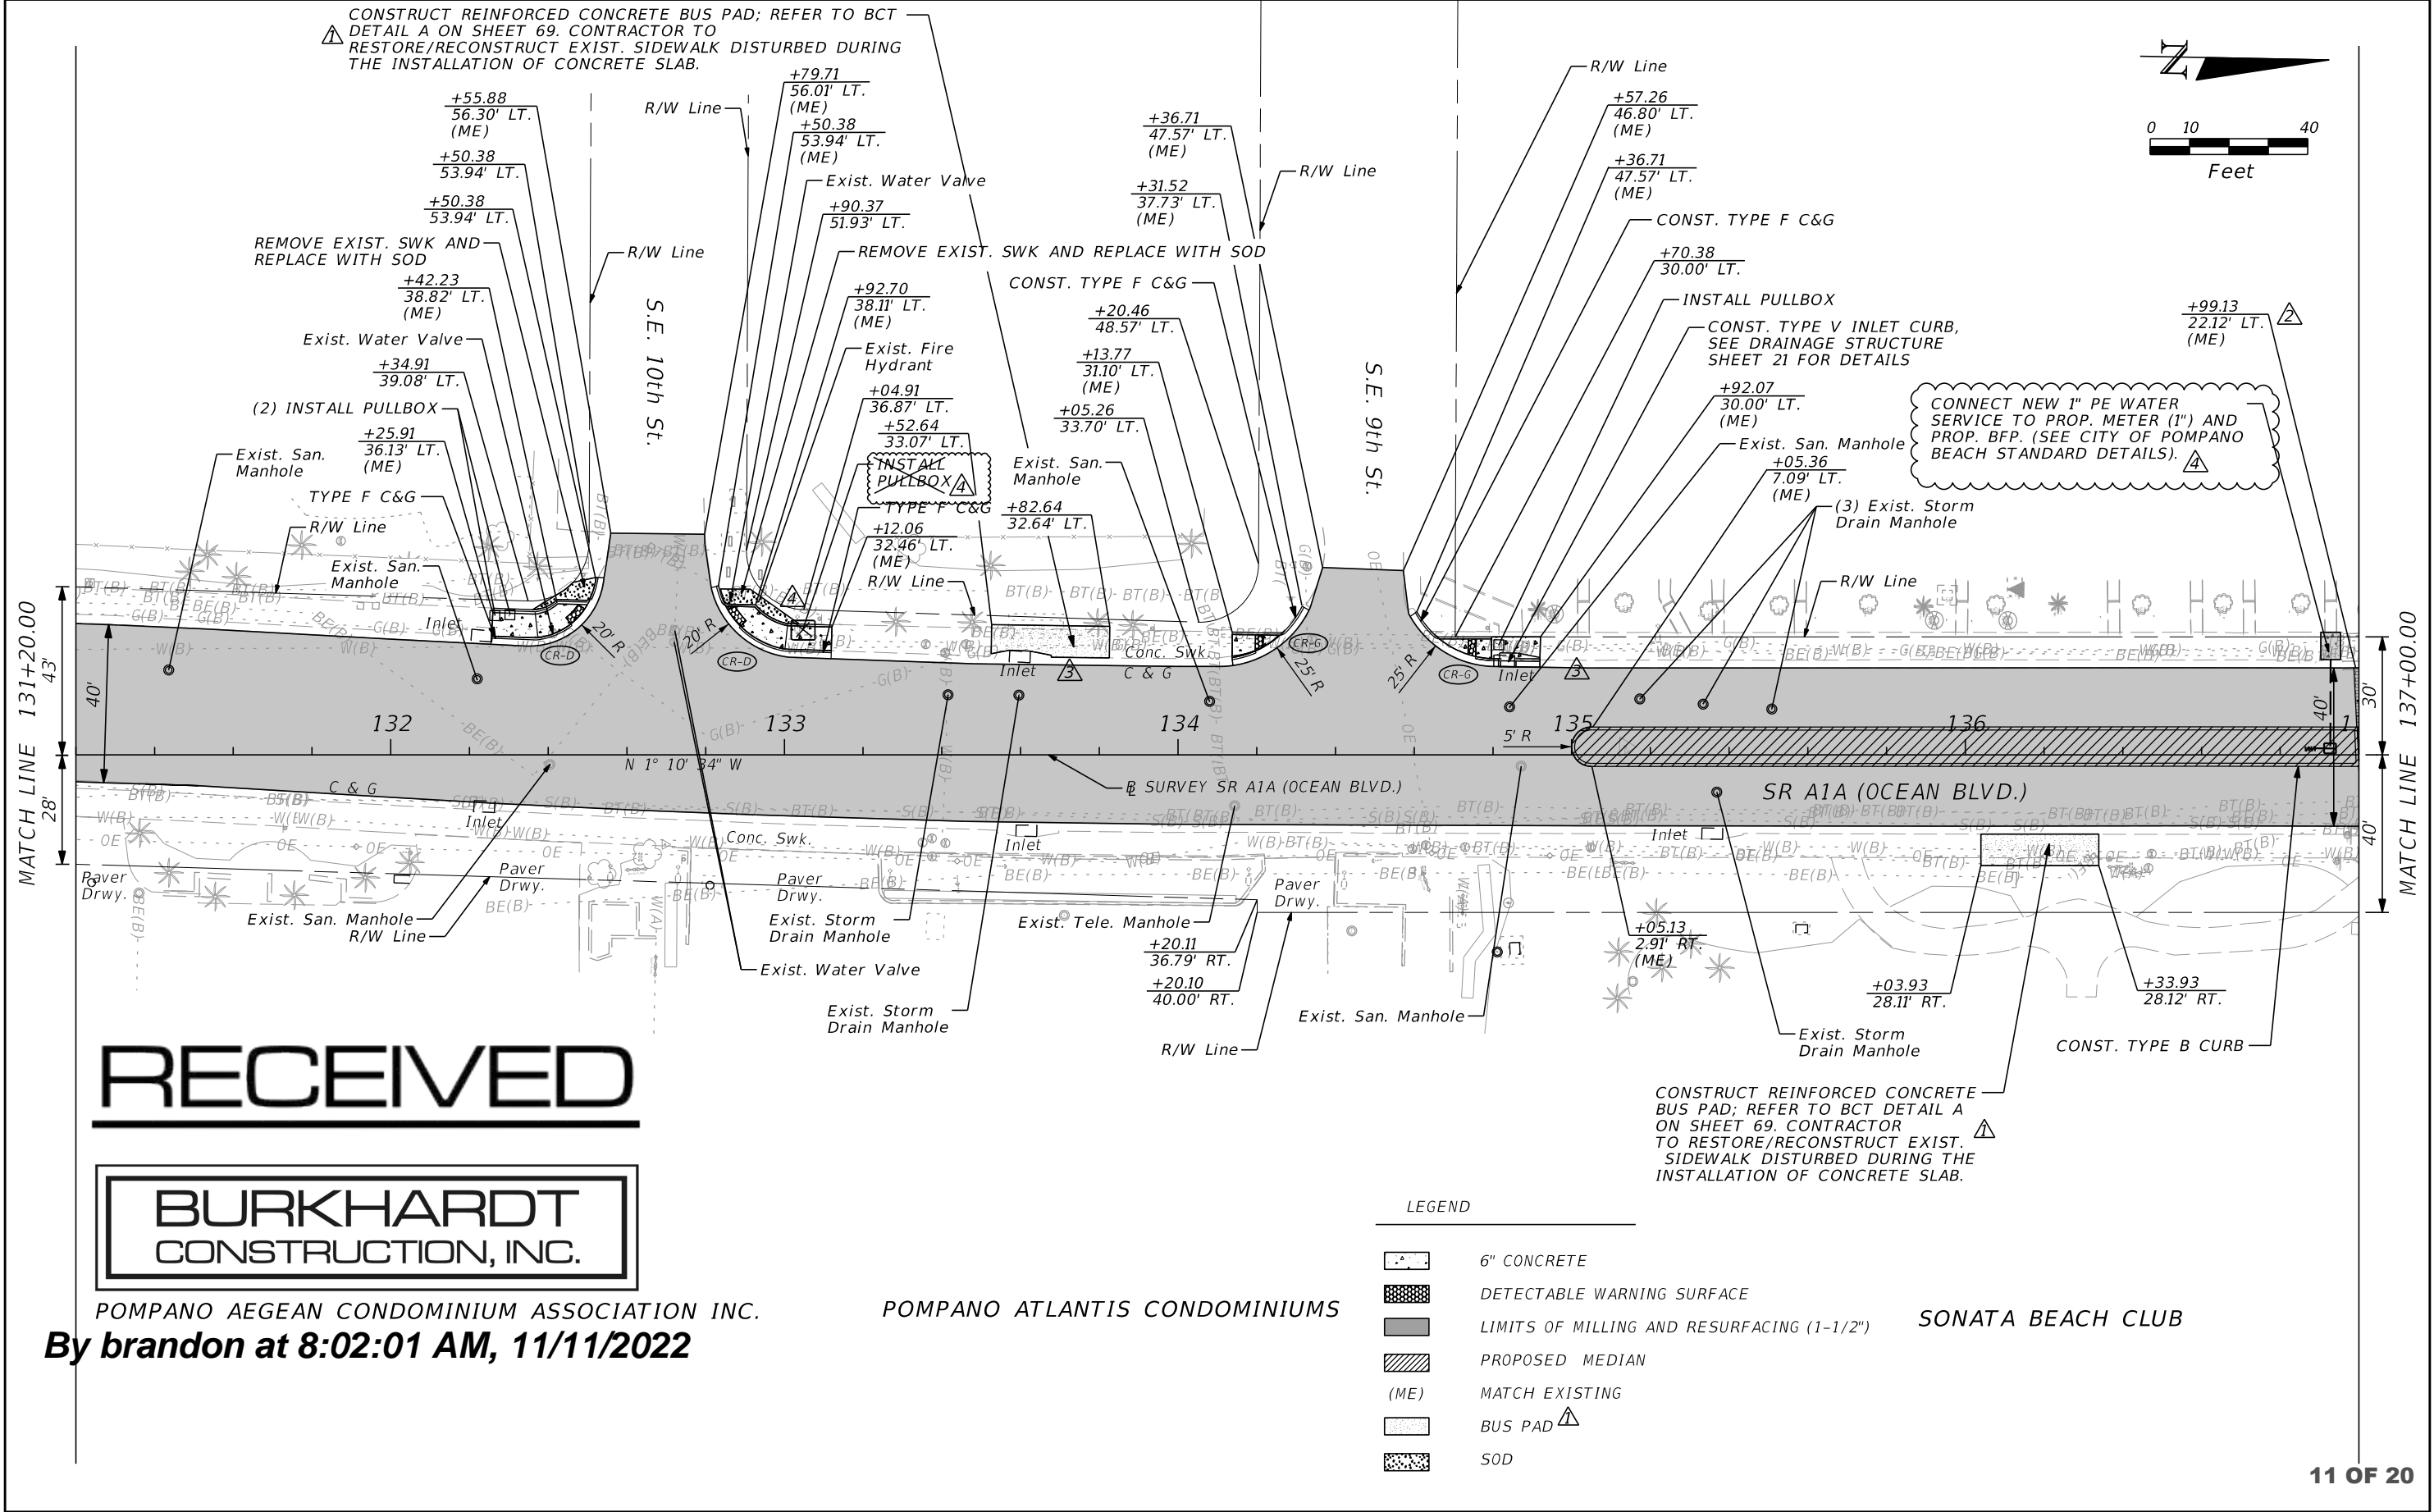

RECEIVED

BURKHARDT  
CONSTRUCTION, INC.

POMPANO AEGEAN CONDOMINIUM ASSOCIATION INC.  
By brandon at 8:02:01 AM, 11/11/2022



POMPANO ATLANTIS CONDOMINIUMS

SONATA BEACH CLUB

- LEGEND
- 6" CONCRETE
  - DETECTABLE WARNING SURFACE
  - LIMITS OF MILLING AND RESURFACING (1-1/2")
  - PROPOSED MEDIAN
  - (ME) MATCH EXISTING
  - BUS PAD
  - SOD

REVISIONS				LORI J. TREVIRANUS, P.E. P.E. LICENSE NUMBER 73684 KEITH AND ASSOCIATES, INC. 301 EAST ATLANTIC BOULEVARD POMPANO BEACH, FL 33060	STATE OF FLORIDA DEPARTMENT OF TRANSPORTATION			ROADWAY PLAN	SHEET NO.  16
DATE	DESCRIPTION	DATE	DESCRIPTION		ROAD NO.	COUNTY	FINANCIAL PROJECT ID		
1/3/22	Update description on legend and sheet number and added text	6/1/22	Removed text labels		SR A1A	BROWARD	N/A		
8/18/22	Removed sidewalk curb and adjusted bus pad around inlet	9/15/22	Modified text and removed proposed pullbox and associated label						



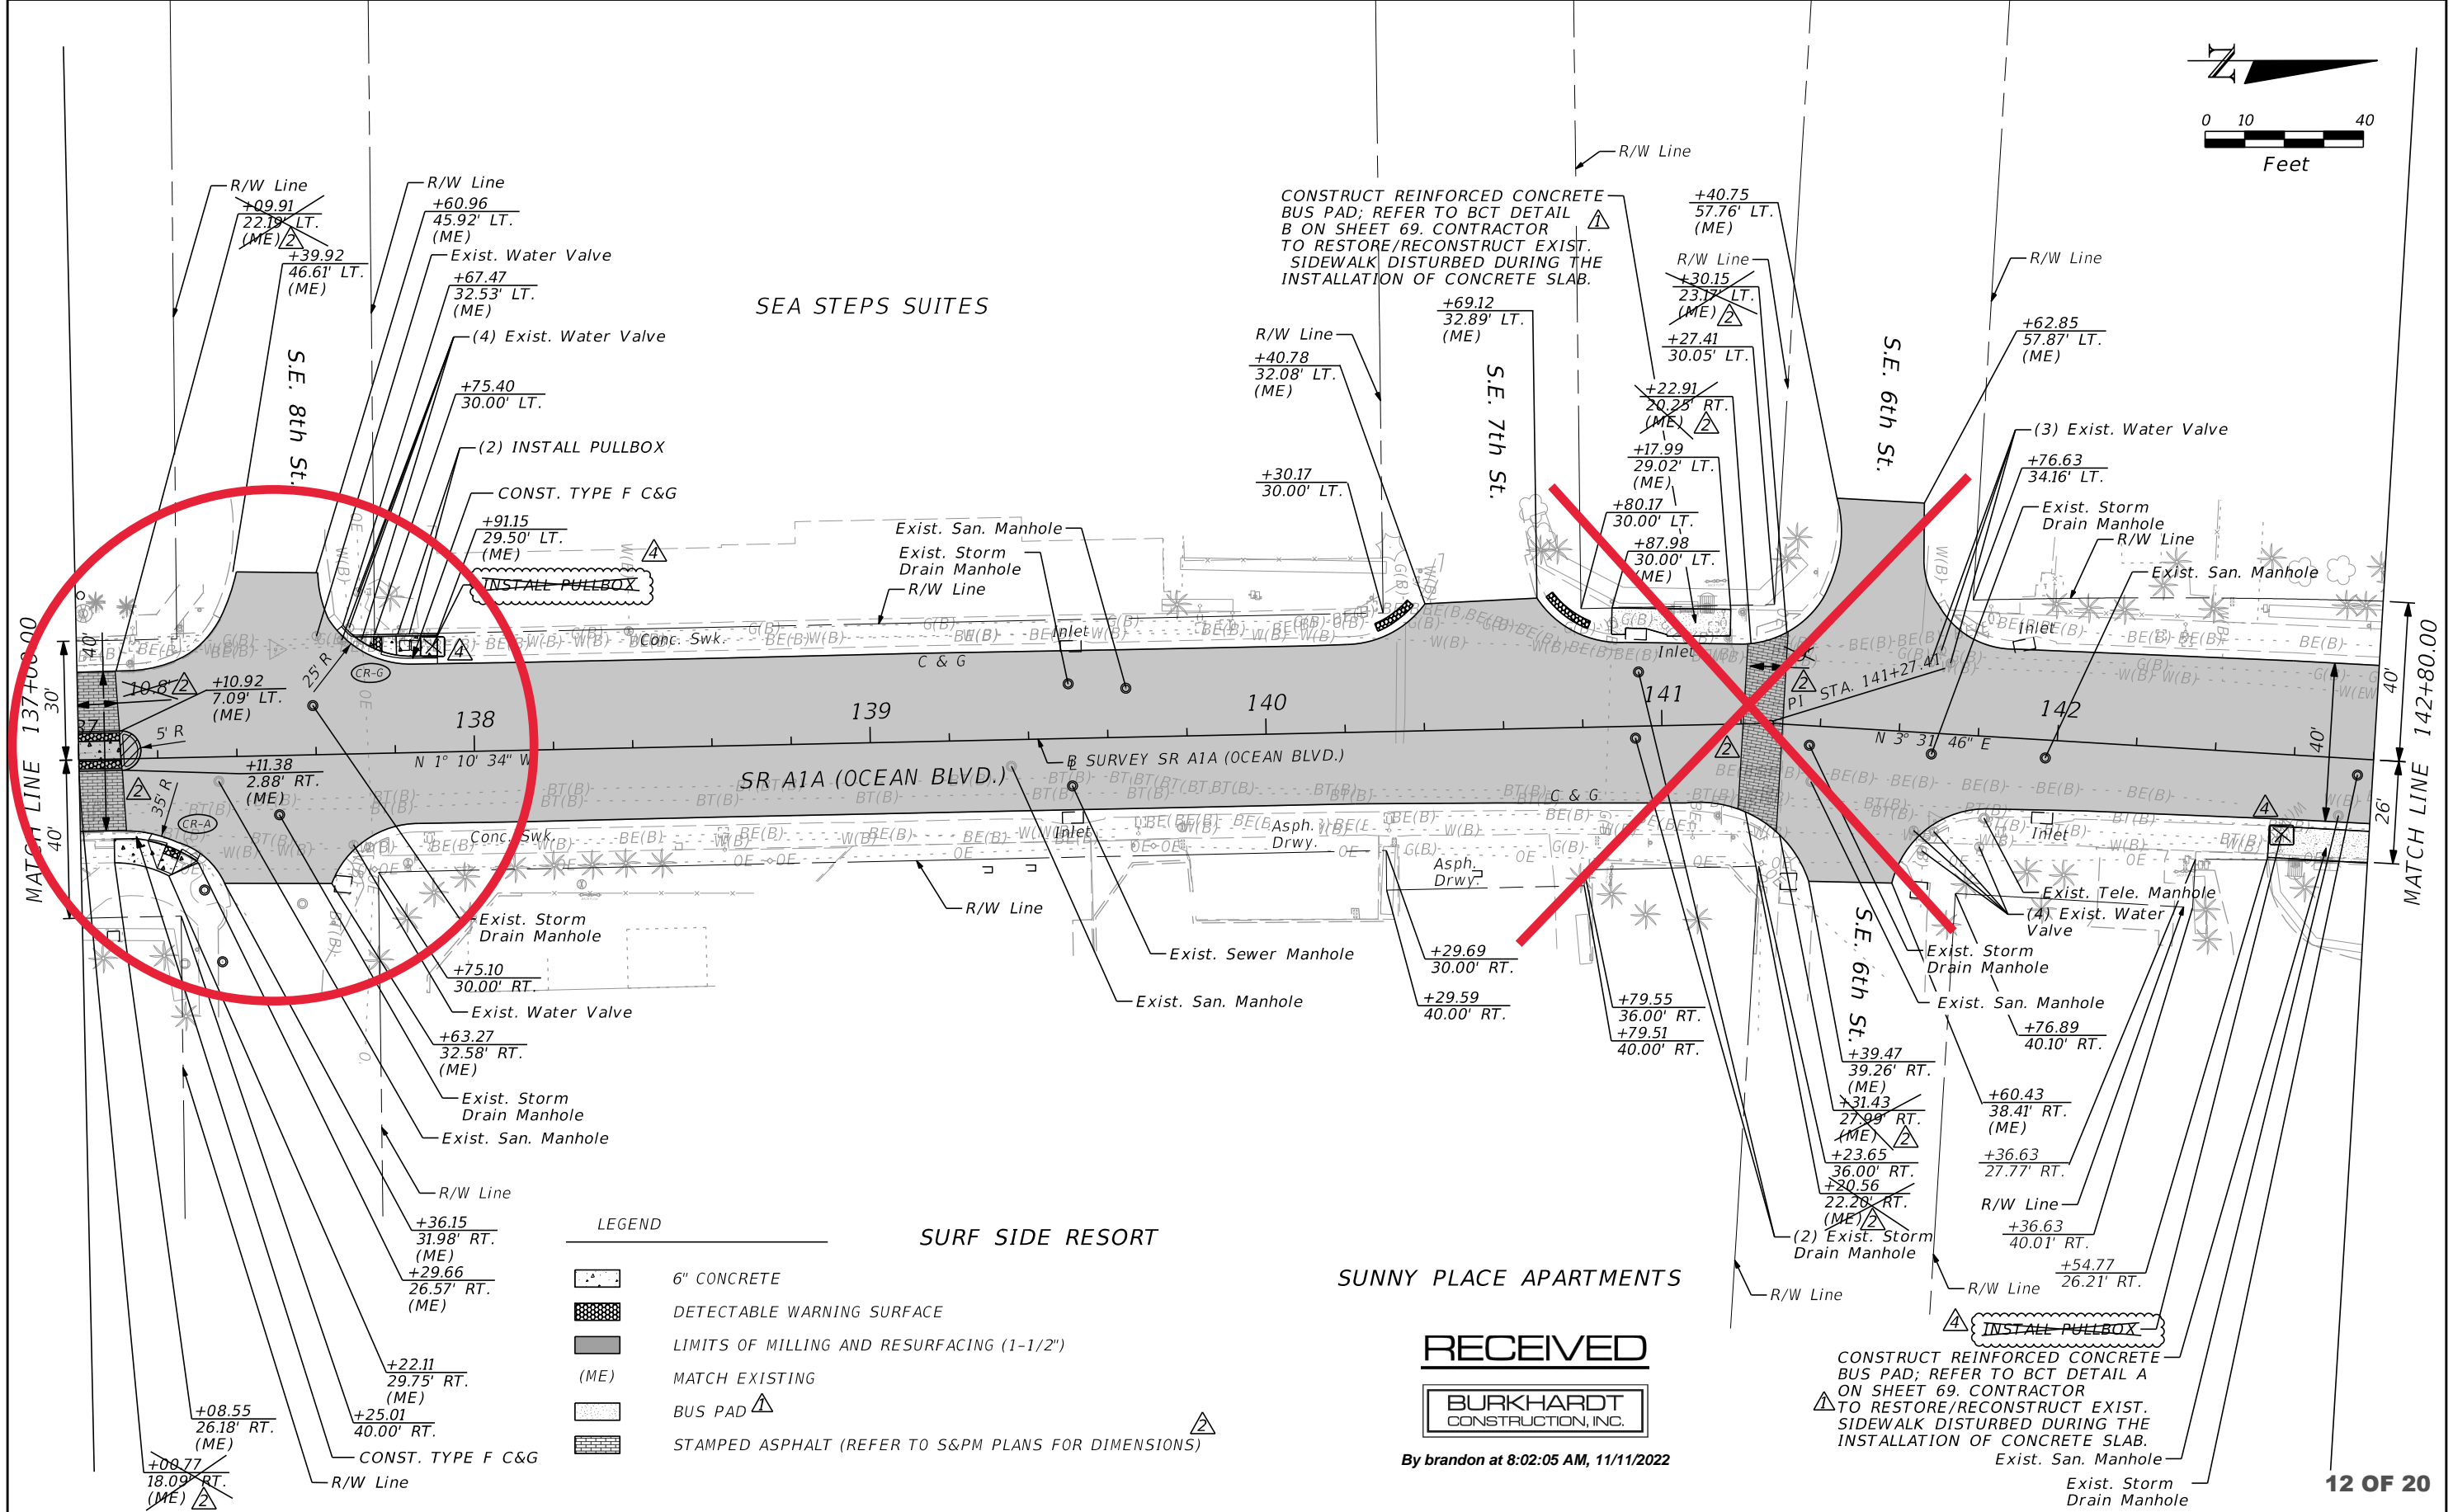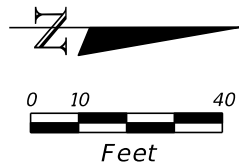


REVISIONS				LORI J. TREVIRANUS, P.E. P.E. LICENSE NUMBER 73684 KEITH AND ASSOCIATES, INC. 301 EAST ATLANTIC BOULEVARD POMPANO BEACH, FL 33060	STATE OF FLORIDA DEPARTMENT OF TRANSPORTATION			ROADWAY PLAN	SHEET NO.  17
DATE	DESCRIPTION	DATE	DESCRIPTION		ROAD NO.	COUNTY	FINANCIAL PROJECT ID		
1/3/22	Update description on legend and sheet number and added text	6/1/22	Added text to legend, removed text labels, and updated (2) crosswalks		SR A1A	BROWARD	N/A		
		9/15/22	Removed proposed pullbox and associated label						

RECEIVED


BURKHARDT  
CONSTRUCTION, INC.

By brandon at 8:02:11 AM, 11/11/2022

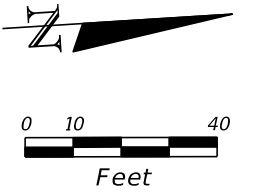

MATCH LINE 142+80.00

MATCH LINE 148+60.00

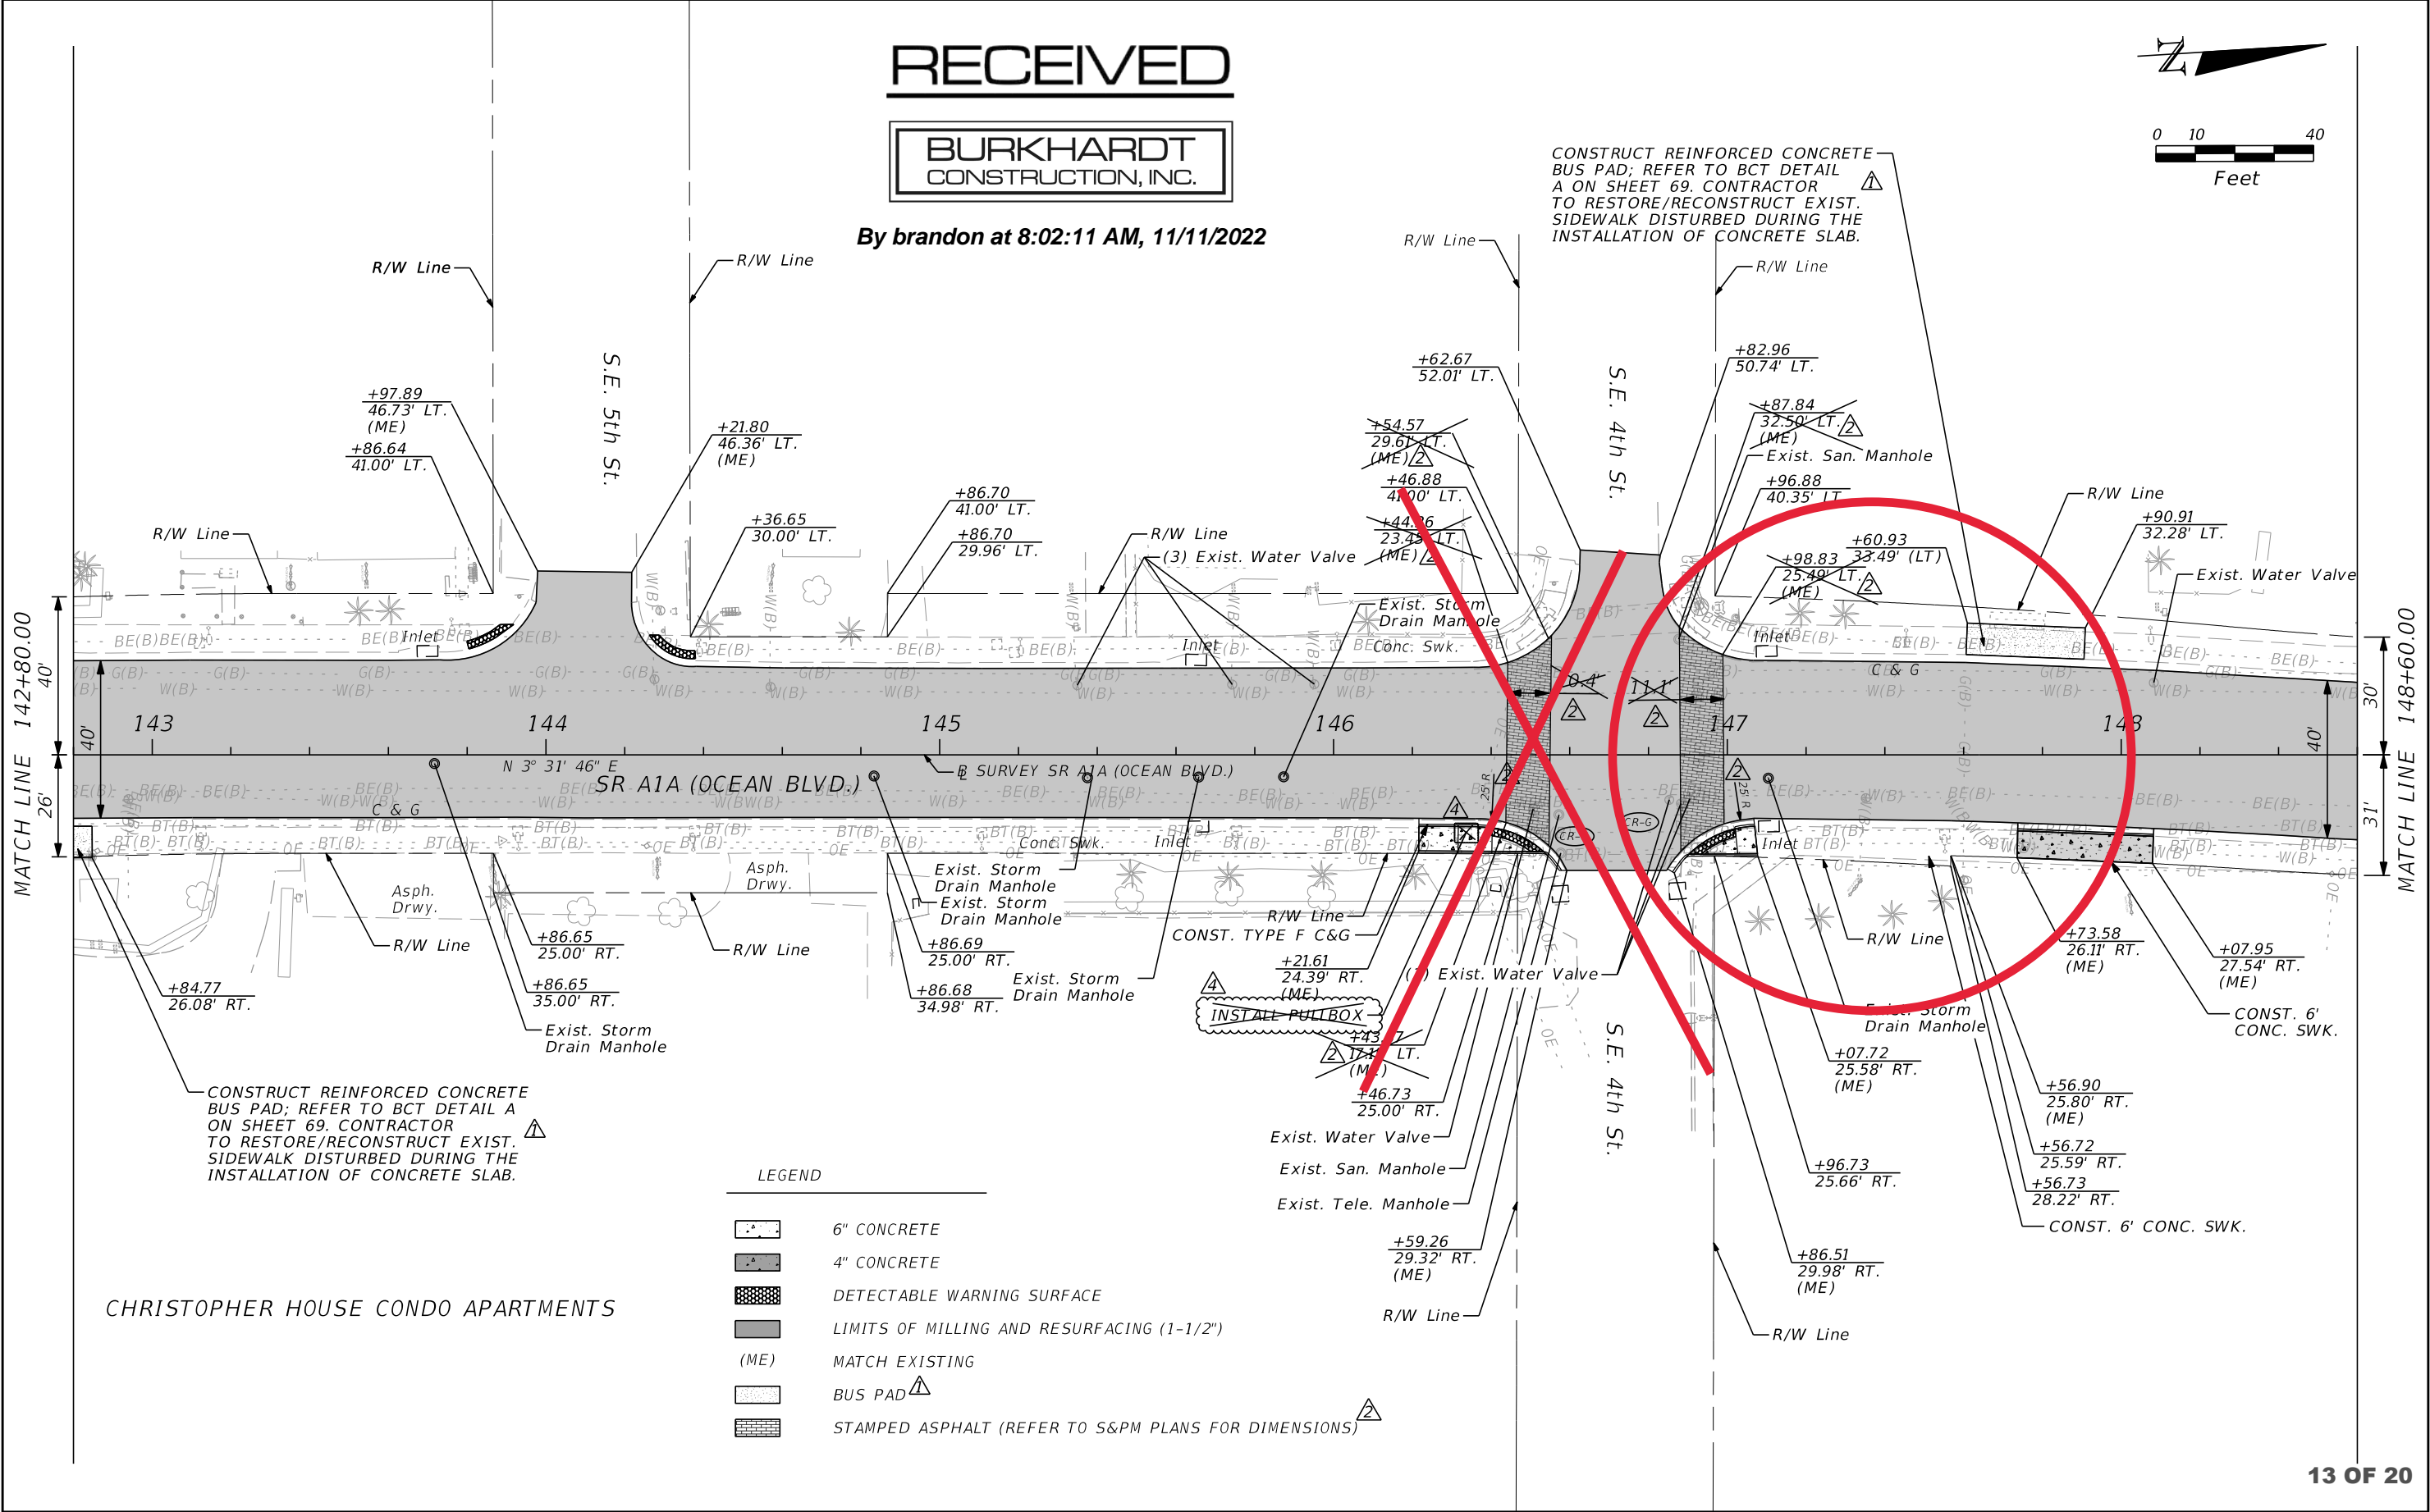



13 OF 20

REVISIONS				LORI J. TREVIRANUS, P.E. P.E. LICENSE NUMBER 73684 KEITH AND ASSOCIATES, INC. 301 EAST ATLANTIC BOULEVARD POMPANO BEACH, FL 33060	STATE OF FLORIDA DEPARTMENT OF TRANSPORTATION			ROADWAY PLAN	SHEET NO.  18
DATE	DESCRIPTION	DATE	DESCRIPTION		ROAD NO.	COUNTY	FINANCIAL PROJECT ID		
1/3/22	Update description on legend and sheet number and added text	6/1/22	Added text to legend, removed text labels, and updated (2) crosswalks		SR A1A	BROWARD	N/A		
		9/15/22	Removed proposed pullbox and associated label						

RECEIVED




By brandon at 8:02:23 AM, 11/11/2022

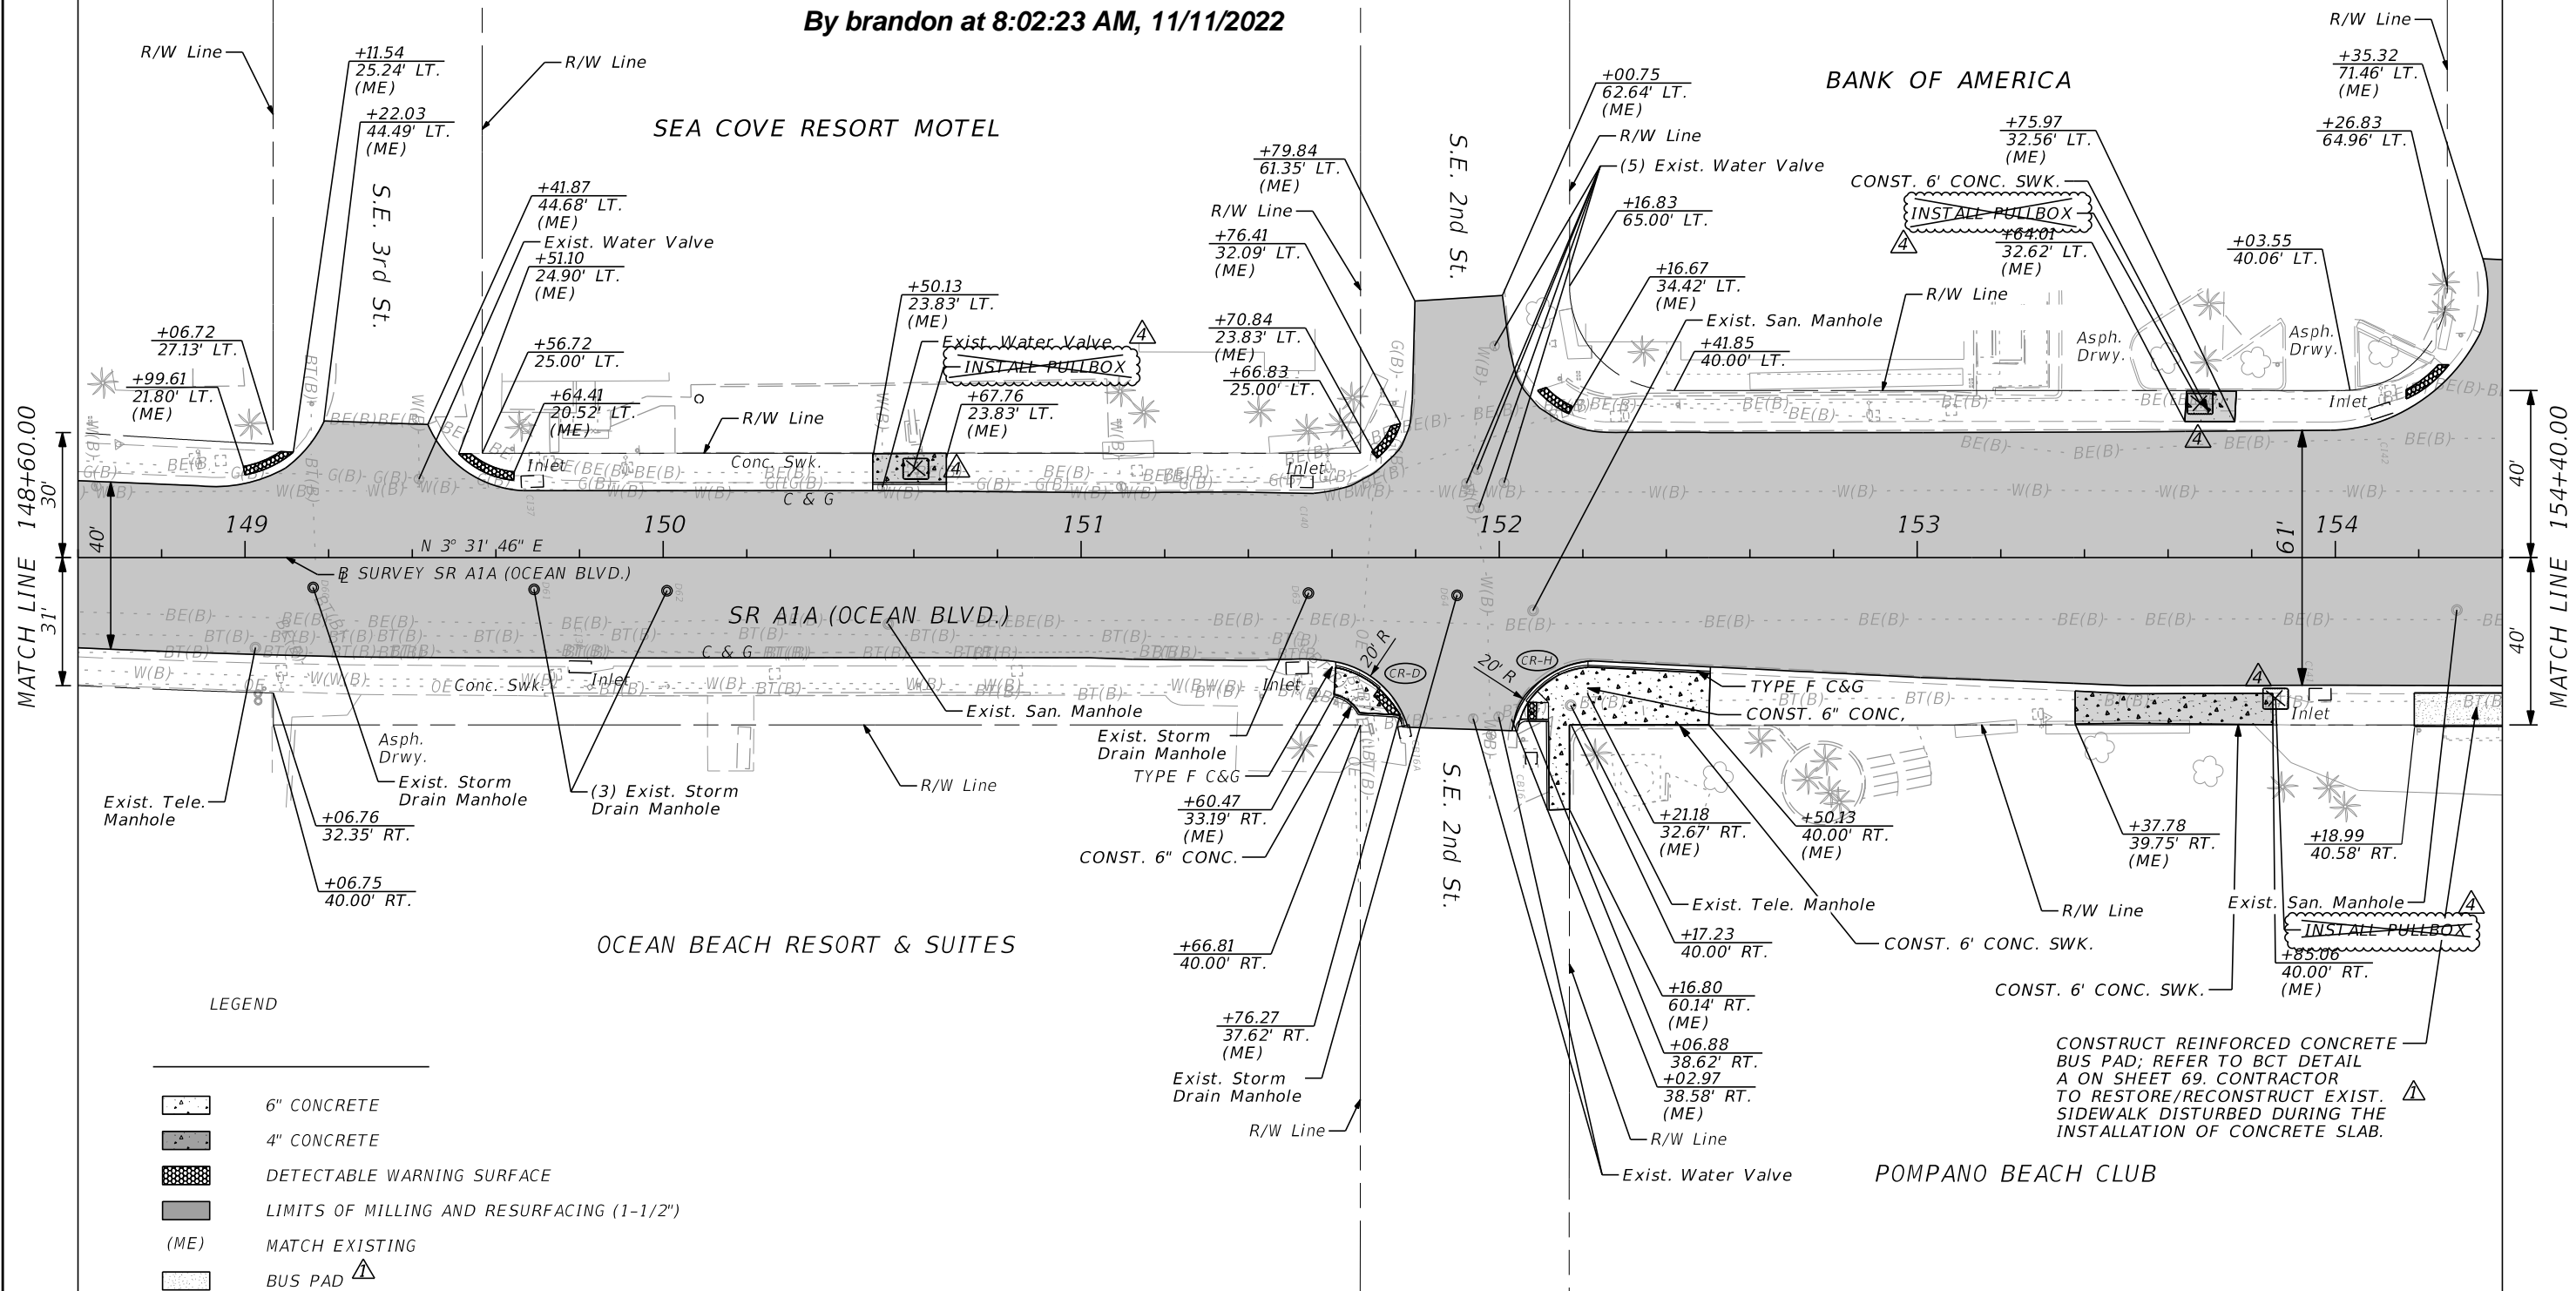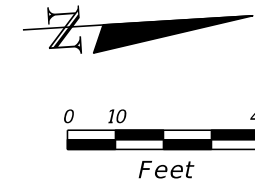

REVISIONS				LORI J. TREVIRANUS, P.E. P.E. LICENSE NUMBER 73684 KEITH AND ASSOCIATES, INC. 301 EAST ATLANTIC BOULEVARD POMPANO BEACH, FL 33060	STATE OF FLORIDA DEPARTMENT OF TRANSPORTATION			ROADWAY PLAN	SHEET NO.  19
DATE	DESCRIPTION	DATE	DESCRIPTION		ROAD NO.	COUNTY	FINANCIAL PROJECT ID		
1/3/22	Update description on legend and sheet number and added text				SR A1A	BROWARD	N/A		
9/15/22	Removed proposed pullbox and associated label								

THE OFFICIAL RECORD OF THIS SHEET IS THE ELECTRONIC FILE DIGITALLY SIGNED AND SEALED UNDER RULE 61G15-23.004, F.A.C.



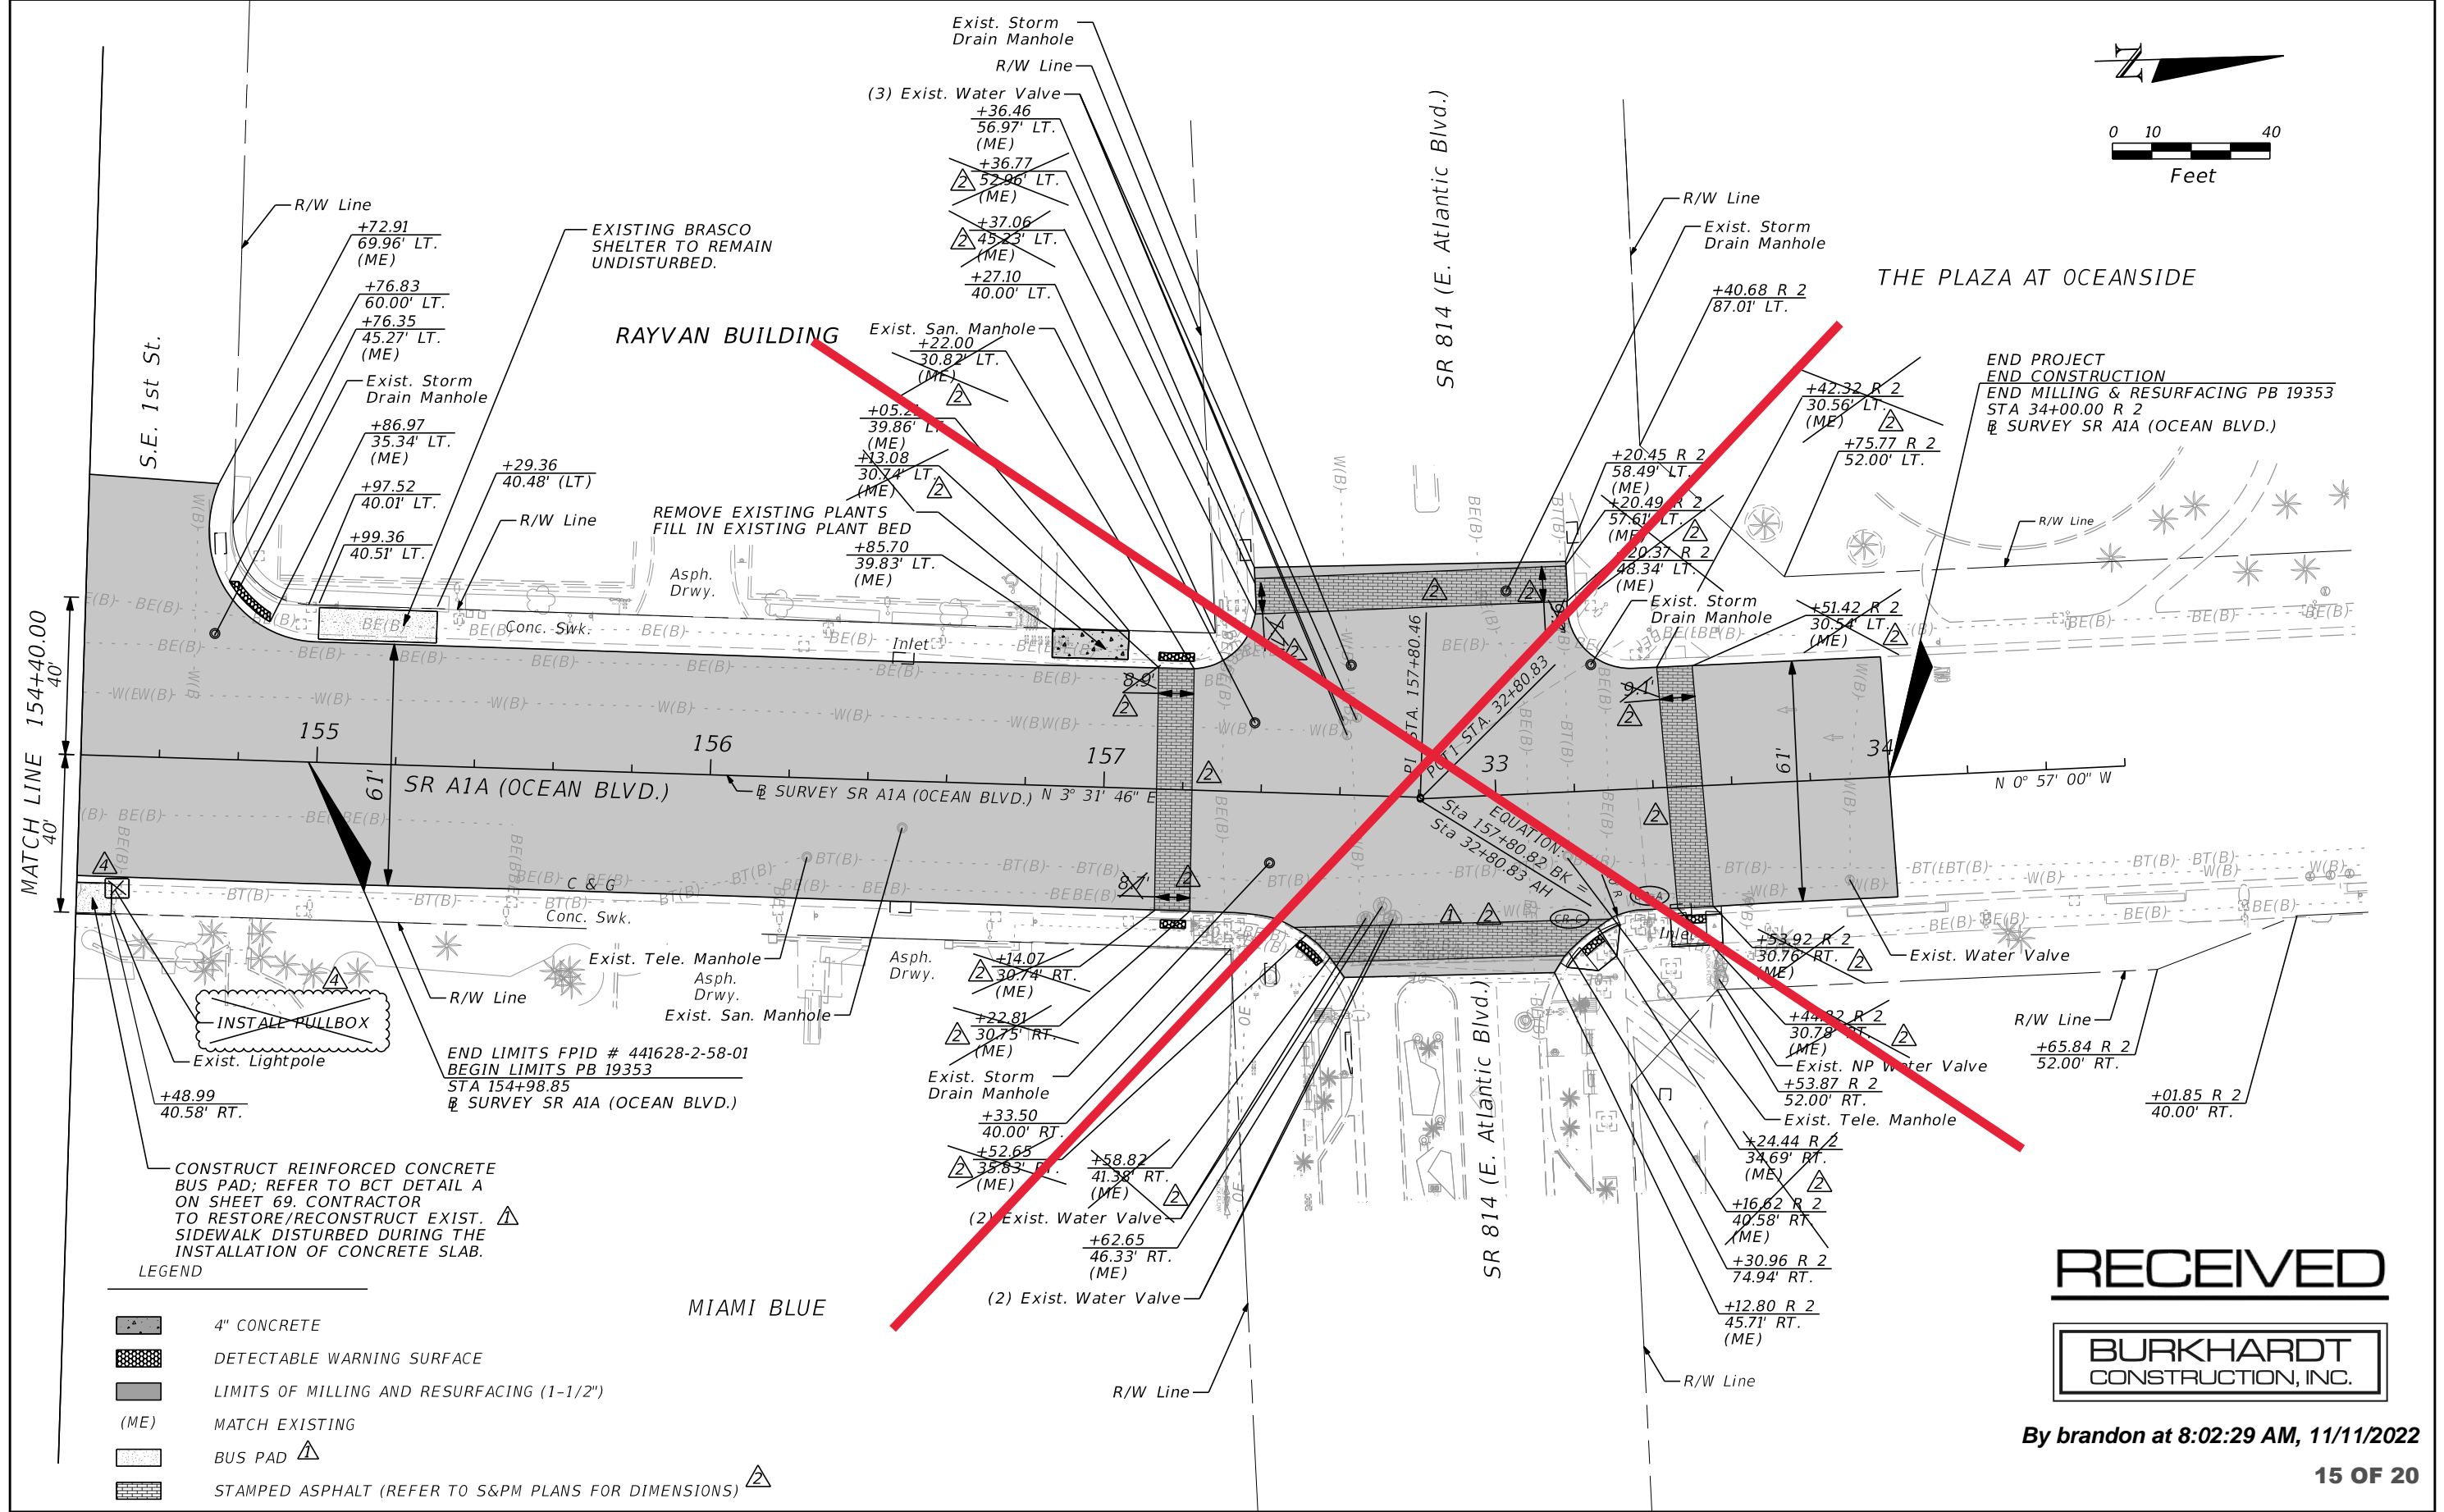

LEGEND

- 4" CONCRETE
- DETECTABLE WARNING SURFACE
- LIMITS OF MILLING AND RESURFACING (1-1/2")
- (ME) MATCH EXISTING
- BUS PAD
- STAMPED ASPHALT (REFER TO S&PM PLANS FOR DIMENSIONS)

REVISIONS				LORI J. TREVIRANUS, P.E. P.E. LICENSE NUMBER 73684 KEITH AND ASSOCIATES, INC. 301 EAST ATLANTIC BOULEVARD POMPANO BEACH, FL 33060	STATE OF FLORIDA DEPARTMENT OF TRANSPORTATION			ROADWAY PLAN	SHEET NO.  20
DATE	DESCRIPTION	DATE	DESCRIPTION		ROAD NO.	COUNTY	FINANCIAL PROJECT ID		
1/3/22	Included stamped asphalt on East leg of intersection and added text	6/1/22	Added text to legend and updated (4) crosswalks		SR A1A	BROWARD	N/A		
		9/15/22	Removed proposed pullbox and associated label						

RECEIVED

BURKHARDT  
CONSTRUCTION, INC.

By brandon at 8:02:29 AM, 11/11/2022

**State of Florida  
Department of Transportation**



INVITATION TO BID  
**FDOT Approved Products List (APL) Traffic Equipment**

**Agency Term Contract**

**Solicitation Number: DOT-ITB-24-9098-SJ**

**EFFECTIVE DATES: JUNE 6, 2024 – JUNE 5, 2026**

FDOT APL Traffic Equipment		DOT-ITB-24-9098-SJ	
Vendor	MFMP Contract Number	Vendor	MFMP Contract Number
Aramco, Inc. dba Striping Service and Supply	CR932	Econolite Control Products, Inc.	CR950
Control Technologies, Inc.	CR933	Intelicom Inc. dba LiteSys, Inc.	CR951
TKH Security LLC	CR934	Split Pine Technologies, LLC	CR952
Integrated Synergy, Inc.	CR935	Express Supply, Inc.	CR953
Blue-Band, LLC	CR936	Hermes42	CR954
Wavetronix, LLC	CR937	GovBros, LLC dba Think IT Ai	CR955
TraStar, Inc.	CR938	Cubic ITS, Inc.	CR956
Sky Bracket	CR940	Lux Solar, Inc.	CR957
Transportation Solutions and Lighting	CR941	Intelligent Transportation Services, Inc.	CR958
Rainbow Distributors USA Inc.	CR943	Pelco Products, Inc.	CR959
Daktronics, Inc.	CR944	GovComm, Inc.	CR960
General Traffic Equipment Corp.	CR945	Blackhawk Enterprises, Inc.	CR961
Temple, Inc.	CR946	Transportation Control Systems, Inc.	CR962
K&K Systems, Inc.	CR947	MG-Squared, Inc.	CR963
All Traffic Solutions, Inc.	CR948	ITS Plus, Inc.	CR964
Earnest Products, Inc. dba Southern Manufacturing	CR949	Safety Zone Holdings, Inc. dba Safety Zone Specialists	CR965

***Note: All purchase orders issued against this contract must reference the following items: Line Number, APL Certification/Configuration No., Manufacturer, Product Category and the Model/Product/Component Description***




# MIDBLOCK PED CROSSWALK SYSTEM

## AC/DC SOLAR POWER IN-ROAD WIRED LED LIGHTS SYSTEM



\_Pedestrian Activated AC/DC SOLAR Power In-Road Lights System\_

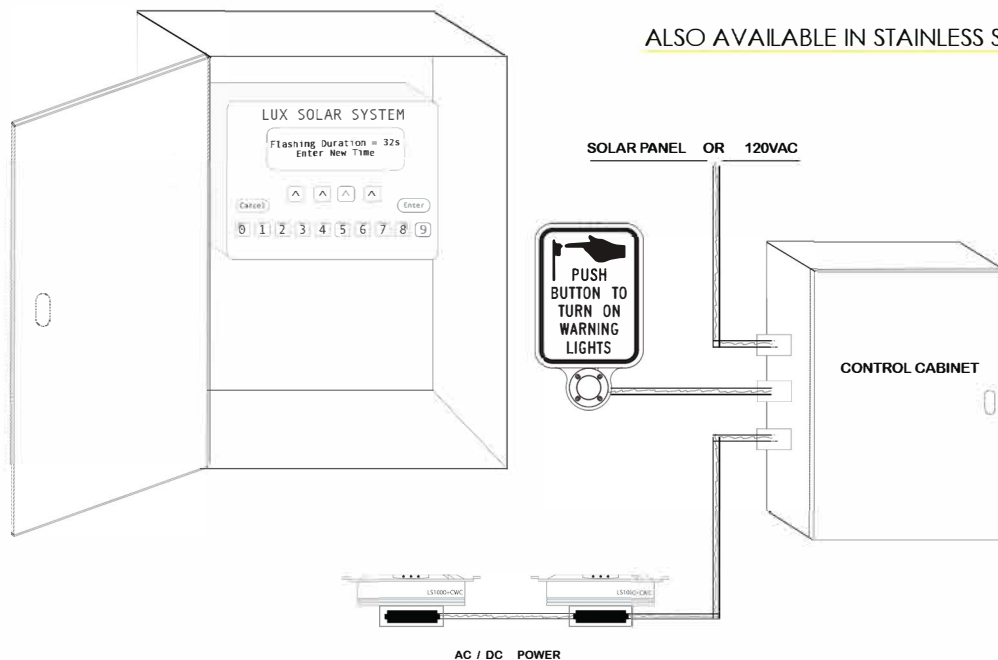



# MIDBLOCK PED CROSSWALK SYSTEM

In-Road Wired AC/DC Solar Powered LED Lights System

MADE IN  
USA

PATENTED

FLASHING YELLOW

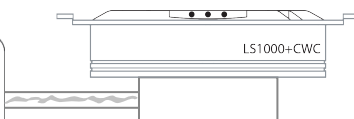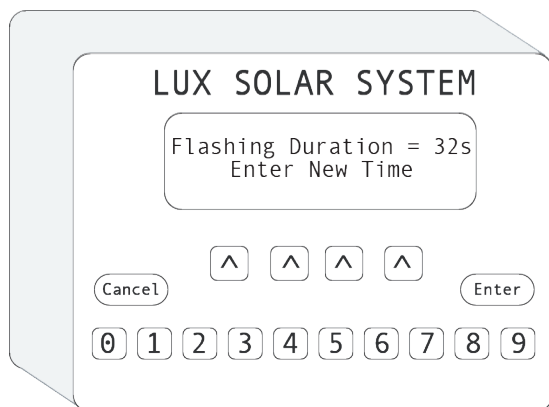

## Dimensions and Weight

Size: ø 6.3" x 1.75" (ø160 x 45mm)  
Weight: 3.4 lbs (1,250g)

## Pedestrian Activation

Customized Pedestrian Actuation  
(1sec to 60sec)



## Physical Properties :: LS100+CWSYS

Environmental ..... NEMA TS2  
Operating Temperature ..... -40°C to +74°C  
Operating Cycles ..... Continuous  
FCC ..... Title 47-B-15

## Physical Properties :: LS1000+CWC

Compressive Strength ..... 120,000 lbs (535,000 N)  
Water Proof ..... IP68  
Operating Temperature ..... -40°C to +74°C  
Operating Cycles ..... Continuous  
FCC ..... Title 47-B-15

## Lighting Properties :: LS1000+CWC

Model	Colors	Typical Light Brightness (mcd)	
LS1000+CWSYS	Yellow	Day / Night	225,000
<b>Type:</b> One Flash (1/sec) Bi-Directional			

## Basic Components

<b>Power</b>	AC / DC	2 Watts
<b>LED</b>	LED Size LED Brightness LED Quantities	3.2mm x 2.7mm 225 Candela 3PCS / Bi-Directional
<b>LED Light Source</b>	Yellow	595 nm
<b>Aluminum Die Cast Housing</b>	Aluminum A383 Die Cast with Polycarbonate Lenses & Composite Cup	
<b>Electronic Controller</b>	MAIN PCB uses Ultra Low Power Microprocessor control to provide a steady flash rate over the temperature range.	

19 OF 20

# WIRED AC/DC SOLAR POWER

## PED CROSSWALK SYSTEM

LS1000+CWSYS

