


Lawrence Beams
12-08-05
LAWRENCE BEAMS
P.A. REGISTERED ARCHITECT

In my professional judgment and to the best of my knowledge and belief, these plans and specifications comply with the applicable minimum building codes and the applicable fire safety standards as determined by local authority in accordance with FL Statutes Chapter 553 and 633.

NO.	DATE	BUILDING DEPT. COMMENTS
1	12/08/05	BUILDING DEPT. COMMENTS

OCEANVIEW
PARCEL B

SCALE: 1/16" = 1'-0"
GROUND FLOOR
PLANNING REVIEW
RESCUE
PLAN REVIEW
JOB NUMBER: 03020.00
SHEET NUMBER: A1.01

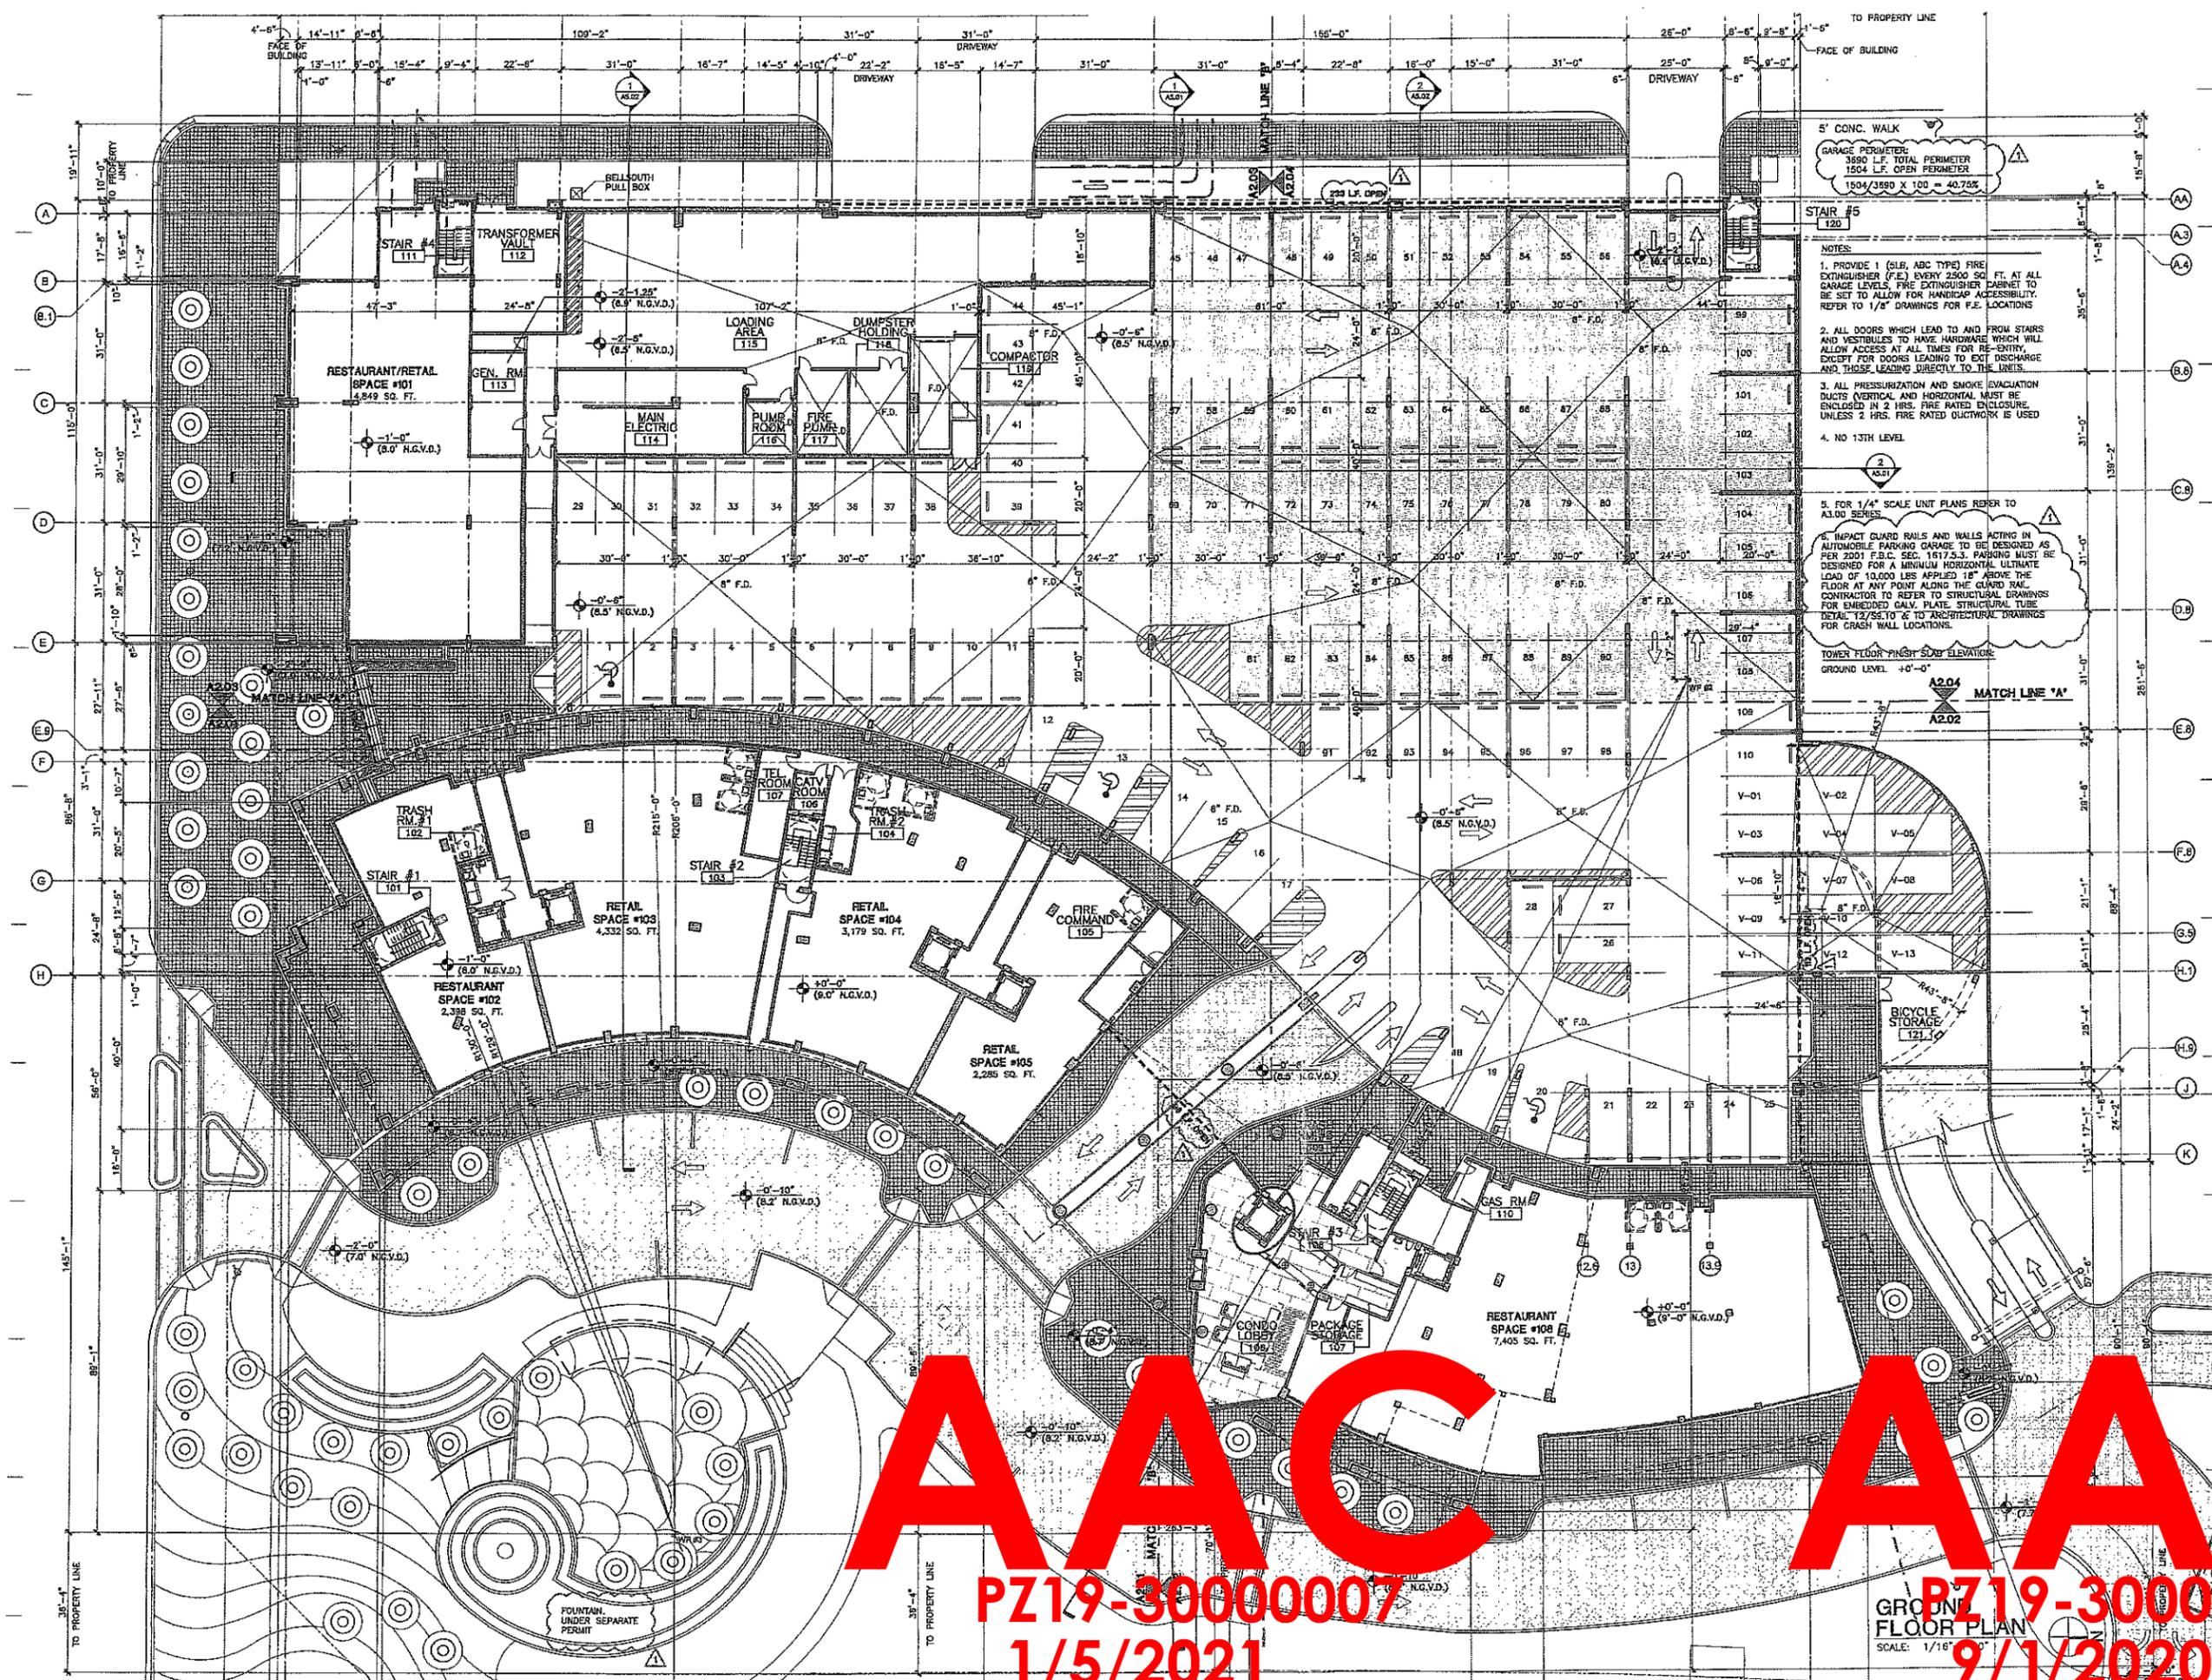

A A C A C
PZ19-30000007
1/5/2021
PZ19-30000007
9/1/2020