NOTES:

1. THE SUBJECT PROPERTY IS A PORTION OF TRACT G OF "POMPANO INDUSTRIAL PARK THIRD ADDITION" AS RECORDED IN PLAT BOOK 111 PAGE 33 AND BEING THE LANDS OF 33 NW 33RD ST INDUSTRIAL, LLC AS RECORDED IN INSTRUMENT NUMBER 117728272, AMONG THE LAND RECORDS OF BROWARD COUNTY, FLORIDA AND HAVING A PARCEL IDENTIFICATION NUMBER OF 4842-21-07-0070 PER THE BROWARD COUNTY PROPERTY APPRAISER.
2. AREA = 451,421 SQUARE FEET OR 10.363 ACRES (MEASURED).
3. LOCATION OF ALL UNDERGROUND UTILITIES ARE APPROXIMATE, SOURCE INFORMATION FROM PLANS AND MARKINGS HAS BEEN COMBINED WITH OBSERVED EVIDENCE OF UTILITIES TO DEVELOP A VIEW OF THOSE UNDERGROUND UTILITIES. HOWEVER, LACKING EXCAVATION, THE EXACT LOCATION OF UNDERGROUND FEATURES CANNOT BE ACCURATELY, COMPLETELY AND RELIABLY DEPICTED. WHERE ADDITIONAL OR MORE DETAILED INFORMATION IS REQUIRED, THE CLIENT IS ADVISED THAT EXCAVATION MAY BE NECESSARY.
4. THIS SURVEY WAS PERFORMED IN THE FIELD ON FEBRUARY 25, 2025 UTILIZING THE REFERENCE DOCUMENTS AS LISTED HEREON AND DEPICTS BUILDINGS, STRUCTURES AND OTHER IMPROVEMENTS.
5. ELEVATIONS ARE BASED ON NAVD88 DATUM DETERMINED BY GPS OBSERVATIONS AND TIED IN TO THE NGS COUNTY BENCHMARK PID: DO2646 WITH A PUBLISHED ELEVATION OF 13.35 FEET.
6. THE PROPERTY IS LOCATED IN SPECIAL FLOOD HAZARD AREAS SUBJECT TO INUNDATION BY THE 1% ANNUAL CHANCE FLOOD ZONE AE (BASE FLOOD ELEVATIONS DETERMINED); OTHER AREAS ZONE X (AREAS DETERMINED TO BE OUTSIDE THE 0.2% ANNUAL CHANCE FLOODPLAIN); AND OTHER FLOOD AREAS ZONE X (AREAS OF 0.2% ANNUAL CHANCE FLOOD; AREAS OF 1% ANNUAL CHANCE FLOOD WITH AVERAGE DEPTHS OF LESS THAN 1 FOOT OR WITH DRAINAGE AREAS LESS THAN 1 SQUARE MILE; AND AREAS PROTECTED BY LEVEES FROM 1% ANNUAL CHANCE FLOOD) PER MAP ENTITLED "FIRM, FLOOD INSURANCE RATE MAP, BROWARD COUNTY, FLORIDA AND INCORPORATED AREAS, PANEL 170 OF 751", MAP NUMBER 12011C0170H, WITH A MAP EFFECTIVE DATE OF AUGUST 18, 2014.
7. NO SURVEY OF SUBTERRANEAN STRUCTURES OR INTERIOR SPACES SUCH AS FOOTINGS, FOUNDATIONS, VAULTS OR BASEMENTS WAS PERFORMED AS PART OF THIS LAND SURVEY, AND THIS PLAN SHOULD NOT BE CONSTRUED AS CERTIFICATION TO THE EXISTENCE OR LOCATION OF THE SAME.
8. THERE IS NO RECENT EVIDENCE OF EARTH MOVING WORK, BUILDING CONSTRUCTION OR BUILDING ADDITIONS OBSERVED IN THE PROCESS OF CONDUCTING THE FIELDWORK.
9. THERE ARE NOT ANY CHANGES IN STREET RIGHT OF WAY LINES EITHER COMPLETED OR PROPOSED, AND AVAILABLE FROM THE CONTROLLING JURISDICTION AND THERE IS NO EVIDENCE OF RECENT STREET OR SIDEWALK CONSTRUCTION OR REPAIRS OBSERVED IN THE PROCESS OF CONDUCTING THE FIELDWORK.
10. TREES SHOWN HEREON ARE BASED ON LOCATIONS AND TREE INFORMATION PROVIDED BY M.J. & ASSOCIATES, LLC, FILE "FESTIVAL FLEA MARKET SOUTH", PROJECT NUMBER 25-331 AND IS DATED MARCH 2025.
11. PARKING: 812 STANDARD
    12 ADA
    824 TOTAL SPACES
12. THERE ARE NO VISIBLE ENCROACHMENTS EXCEPT AS SHOWN ON THE SURVEY. ENCROACHMENT IS A LEGAL CONDITION, NOT A MATTER OF SURVEY AND, AS A RESULT, THERE MAY BE OTHER POSSIBLE ENCROACHMENTS AFFECTING THE PROPERTY THAT ARE NOT SHOWN.
13. PROPERTY HAS ACCESS ALONG NW 33RD STREET AND NW 27TH AVENUE.
14. THIS SURVEY WAS PREPARED IN ACCORDANCE WITH THE "STANDARDS OF PRACTICE", AS SET FORTH BY THE FLORIDA BOARD OF PROFESSIONAL SURVEYORS AND MAPPERS IN RULES 5J-17.050 THROUGH 5J-17.053, OF THE FLORIDA ADMINISTRATIVE CODE.
15. BEARINGS ARE BASED ON THE SOUTH LINE OF TRACT G AS RECORDED IN PLAT BOOK 111, PAGE 33, LINEWORK AND FEATURES SHOWN HEREON ARE BASE ON NORTH AMERICAN DATUM OF 1983. PROJECTION; TRANSVERSE MERCATOR.
16. ALL DISTANCES ARE MEASURED GROUND DISTANCES UNLESS NOTED OTHERWISE.
17. THE CONTRACTED PURPOSE OF THIS SURVEY IS FOR PERMITTING. THIS SURVEY IS NOT VALID FOR ANY OTHER USE.
18. ADDITIONS OR DELETIONS TO SURVEY MAPS OR REPORTS BY ANYONE OTHER THAN THE SIGNING PARTY OR PARTIES IS PROHIBITED WITHOUT WRITTEN CONSENT OF THE SIGNING PARTY OR PARTIES.
19. THIS MAP IS INTENDED TO BE DEPICTED AT A SCALE OF 1"=30' ON 24"X36" SHEETS. UNITS SHOWN ARE U.S. SURVEY FEET.
20. ZONING: I-1(GENERAL INDUSTRIAL)

    BUILDING SETBACKS

    FRONT: 25 FEET
    SIDE (STREET): 10 FEET
    SIDE (INTERIOR): 10 FEET
    REAR: 30 FEET

    ALL ZONING INFORMATION WAS PROVIDED IN A ZONING REPORT PREPARED BY BOHLER ENGINEERING FL, LLC , DATED NOVEMBER 29, 2021 AND MUST BE VERIFIED PRIOR TO USE OR RELIANCE UPON SAME, TO CONFIRM THE ZONING INFORMATION REPRESENTS AND DEPICTS THE THEN-CURRENT SITE-SPECIFIC INFORMATION." SHOULD THERE BE ANY CHANGE IN USE, SETBACK(S) AND/OR SET BACK REQUIREMENTS, ZONING CLASSIFICATION AND/OR ANY OTHER CHANGE OR VARIATION FROM THE CONDITIONS RECORDED HEREIN, THE CLIENT MUST VERIFY COMPLIANCE WITH THE USE, SET BACK, ZONING CLASSIFICATION AND/OR ORDINANCE, REGULATION OR LEGAL REQUIREMENT, PRIOR TO USING OR RELYING UPON THE FINDINGS RECORDED HEREIN, OR REFERENCING SAME AS RELATED TO THE PROPERTY, PROJECT AND/OR DEVELOPMENT.
21. THERE IS NO OBSERVABLE EVIDENCE OF SITE USE AS A SOLID WASTE DUMP, SUMP OR SANITARY LANDFILL.
22. BOHLER WAS NOT MADE AWARE OF ANY WETLAND DELINEATION PERFORMED ON THE SUBJECT PROPERTIES AND THERE WERE NO WETLAND FLAGS OBSERVED AT THE TIME OF THE FIELD SURVEY. A PHASE 1 REPORT WAS NOT PROVIDED.
23. FROM A VISUAL INSPECTION ONLY, ALL UTILITIES APPEAR TO ENTER THE SUBJECT PROPERTY FROM A PUBLIC RIGHT-OF-WAY OR RECORDED EASEMENT. (SEE SURVEY).
24. FROM A VISUAL INSPECTION ONLY, THE SUBJECT PROPERTY APPEARS TO DRAIN INTO RIGHT-OF-WAY.
25. THEIR ARE NO DISCREPANCIES BETWEEN THE BOUNDARY LINES SHOWN ON THIS SURVEY AND THE LEGAL DESCRIPTION CONTAINED IN THE TITLE COMMITMENT.
26. IF THE SUBJECT PROPERTY IS COMPRISED OF MULTIPLE PARCELS, THE PARCELS ARE CONTIGUOUS ALONG THEIR COMMON BOUNDARIES AS SHOWN ON THIS SURVEY, AND THAT THERE ARE NO GAPS, STRIPS OR GORES IN SAID PROPERTIES.
27. THERE ARE NO GAP/GORES OR OVERLAPS BETWEEN THE RIGHT-OF-WAY LINES OF BLOUNT ROAD, NW 33RD STREET, FLORIDAS TURNPIKE AND THE SUBJECT PARCEL.
28. THE BOUNDARY LINE DIMENSIONS AS SHOWN ON THIS SURVEY MAP FORM A MATHEMATICALLY CLOSED FIGURE WITHIN ± 0.1 FOOT.
29. THERE ARE NO OBSERVABLE PARTY WALLS AND NO OBSERVABLE ABOVE GROUND ENCROACHMENTS EITHER (A) BY THE IMPROVEMENTS ON THE SUBJECT PROPERTY UPON ADJOINING PROPERTIES, STREETS, ALLEYS, EASEMENTS OR RIGHT-OF-WAY, OR (B) BY THE IMPROVEMENTS ON ANY ADJOINING PROPERTIES STREETS OR ALLEYS UPON THE SUBJECT PROPERTY, EXCEPT AS OTHERWISE SHOWN HEREON.
30. THERE IS NO OBSERVABLE EVIDENCE OF EASEMENT OR RIGHT-OF-WAY ON OR ACROSS THE SURVEYED PROPERTY, OR ON ANY ADJOINING PROPERTIES IF THEY APPEAR TO AFFECT THE SUBJECT PROPERTY, EXCEPT AS OTHERWISE SHOWN HEREON.
31. THE SUBJECT PROPERTY DOES NOT APPEAR TO SERVE ANY ADJOINING PROPERTY FOR DRAINAGE, UTILITIES STRUCTURAL SUPPORT, INGRESS OR EGRESS.
32. © COPYRIGHT 2025 BY BOHLER ENGINEERING FL, LLC.
REPRODUCTIONS OF THIS SURVEY ARE NOT VALID WITHOUT THE ORIGINAL SIGNATURE AND STAMP, OR A DIGITALLY VERIFIED ELECTRONIC SIGNATURE AND SEAL, OF A FLORIDA LICENSED SURVEYOR AND MAPPER EMPLOYED BY BOHLER ENGINEERING FL, LLC.

LEGAL DESCRIPTION

PARCEL 1: (FEE TITLE)

TRACT G OF POMPANO INDUSTRIAL PARK THIRD ADDITION, ACCORDING TO THE PLAT THEREOF, AS RECORDED IN PLAT BOOK 111, PAGE 33, OF THE PUBLIC RECORDS OF BROWARD COUNTY, FLORIDA;

LESS AND EXCEPT THE FOLLOWING:

A PORTION OF TRACT G OF, POMPANO INDUSTRIAL PARK THIRD ADDITION, AS RECORDED IN PLAT BOOK 111, PAGE 33, OF THE PUBLIC RECORDS OF BROWARD COUNTY, FLORIDA, IN SECTION 21, TOWNSHIP 48 SOUTH, RANGE 42 EAST, MORE PARTICULARLY DESCRIBED AS FOLLOWS:

BEGIN AT THE SOUTHEAST CORNER OF SAID TRACT G;

THENCE SOUTH 89 DEGREES 47' 14" WEST, ALONG THE SOUTH LINE OF SAID TRACT G, FOR A DISTANCE OF 40.00 FEET TO A POINT 40.00 FEET WEST OF AND PARALLEL WITH, AS MEASURED AT RIGHT ANGLES TO, THE EAST LINE OF THE NORTHWEST ONE QUARTER (NW 1/ 4) OF SAID SECTION 21;

THENCE NORTH 00 DEGREES 19' 17" EAST, ALONG SAID PARALLEL LINE, FOR A DISTANCE OF 204.33 FEET TO A POINT ON THE EXISTING WEST RIGHT OF WAY LINE OF BLOUNT ROAD AND TO A POINT OF CUSP OF A CURVE CONCAVE TO THE NORTHEAST;

THENCE SOUTHEASTERLY ALONG SAID CURVE, HAVING A RADIUS OF 540.00 FEET, A CENTRAL ANGLE OF 22 DEGREES 11' 30", FOR AN ARC DISTANCE OF 209.15 FEET TO THE POINT OF BEGINNING.

SAID LANDS LYING IN THE CITY OF POMPANO BEACH, BROWARD COUNTY, FLORIDA.

PARCEL 2: NON-EXCLUSIVE EASEMENT

("EASEMENT - A")

NON-EXCLUSIVE EASEMENTS AS CONTAINED IN THAT CERTAIN EASEMENT, BY AND BETWEEN POWERLINE PARK SERVICE ASSOCIATION, INC., A FLORIDA NON-PROFIT CORPORATION, GRANTOR AND R/S ASSOCIATES OF FLORIDA, A PENNSYLVANIA LIMITED PARTNERSHIP, GRANTEE, RECORDED NOVEMBER 30, 1993, IN OFFICIAL RECORDS BOOK 21444, PAGE 925; AS AFFECTED BY CONSENT TO EASEMENT (CORPORATION) RECORDED SEPTEMBER 16, 2014, IN OFFICIAL RECORDS BOOK 51096, PAGE 1455 OF THE PUBLIC RECORDS OF BROWARD COUNTY, FLORIDA, FOR THE PURPOSES DESCRIBED IN SAID EASEMENT, OVER, UNDER AND ACROSS THE LAND DESCRIBED BELOW, SUBJECT TO THE TERMS, PROVISIONS AND CONDITIONS SET FORTH IN SAID EASEMENT:

TRACT F (PRIVATE LAKE) OF POMPANO INDUSTRIAL PARK THIRD ADDITION, ACCORDING TO THE PLAT THEREOF, AS RECORDED IN PLAT BOOK 111, PAGE 33, OF THE PUBLIC RECORDS OF BROWARD COUNTY, FLORIDA.

("EASEMENT - B")

NON-EXCLUSIVE EASEMENTS AS CONTAINED IN THAT CERTAIN GRANT OF EASEMENT AGREEMENT, BY AND BETWEEN POWERLINE PARK SERVICE ASSOCIATION, INC., A FLORIDA NON-PROFIT CORPORATION, GRANTOR AND R/S ASSOCIATES OF FLORIDA, A PENNSYLVANIA LIMITED PARTNERSHIP, GRANTEE, RECORDED FEBRUARY 12, 2001 IN OFFICIAL RECORDS BOOK 31268, PAGE 1866, OF THE PUBLIC RECORDS OF BROWARD COUNTY, FLORIDA, FOR THE PURPOSES DESCRIBED IN SAID EASEMENT, OVER, UNDER AND ACROSS THE LAND DESCRIBED BELOW, SUBJECT TO THE TERMS, PROVISIONS AND CONDITIONS SET FORTH IN SAID EASEMENT:

A PORTION OF TRACT "F", POMPANO INDUSTRIAL PARK THIRD ADDITION, ACCORDING TO THE PLAT THEREOF AS RECORDED IN PLAT BOOK 111, PAGE 33 OF THE PUBLIC RECORDS OF BROWARD COUNTY, FLORIDA, DESCRIBED AS FOLLOWS:

COMMENCING AT THE SOUTHWEST CORNER OF SAID PLAT; THENCE NORTH 89 DEGREES 47' 14" EAST ALONG THE SOUTH LINE OF SAID PLAT, A DISTANCE OF 981.25 FEET; THENCE NORTH 00 DEGREES 21' 30" EAST 321.50 FEET TO A POINT ON THE SOUTH LINE OF SAID TRACT "F", ALSO BEING THE POINT OF BEGINNING; THENCE CONTINUE NORTH 00 DEGREES 21' 30" EAST 186.13 FEET TO A POINT ON THE NORTH LINE OF SAID TRACT "F"; THENCE NORTH 89 DEGREES 41' 47" EAST, ALONG SAID NORTH LINE, 15.00 FEET; THENCE SOUTH 00 DEGREES 21' 30" WEST, 186.13 FEET TO A POINT ON THE SOUTH LINE OF SAID TRACT "F"; THENCE SOUTH 89 DEGREES 41' 47" WEST, ALONG THE SOUTH LINE OF SAID TRACT "F", 15.00 FEET TO THE POINT OF BEGINNING, SAID LANDS SITUATE, LYING AND BEING IN BROWARD COUNTY, FLORIDA

(BEING THE SAME PROPERTY AS DESCRIBED IN A COMMITMENT FOR TITLE INSURANCE PREPARED BY COMMONWEALTH LAND TITLE INSURANCE COMPANY, COMMITMENT NUMBER 12351290, ISSUING OFFICE FILE NUMBER 4112351290BM. WITH A COMMITMENT DATE OF JUNE 09, 2025, WITH A REVISION DATE OF JUNE 18, 2025, AND IS SUBJECT TO RESTRICTIONS, COVENANTS, AND/OR EASEMENTS, WRITTEN OR IMPLIED.)

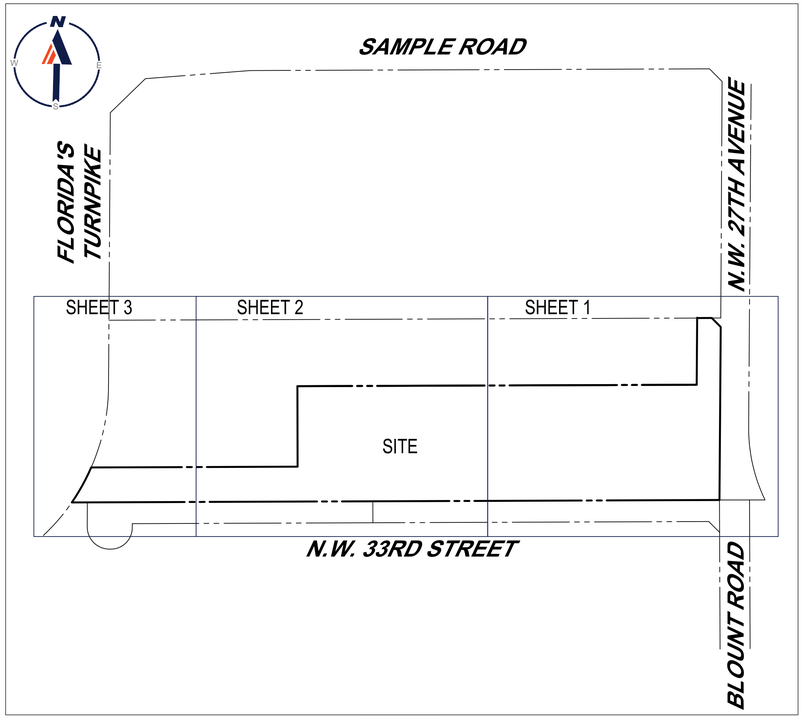

KEY MAP
SCALE: 1"=200'

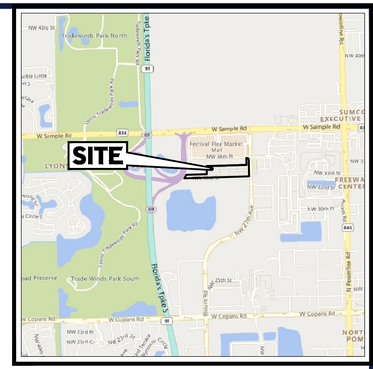

SITE LOCATION MAP
SCALE: 1"=2,000'
SOURCE: AUTODESK GEOLOCATION MAP

TITLE NOTES:

THIS SURVEY IS PREPARED WITH REFERENCE TO A COMMITMENT FOR TITLE INSURANCE PREPARED BY COMMONWEALTH LAND TITLE INSURANCE COMPANY COMMITMENT NUMBER: 12351290, ISSUING OFFICE FILE NUMBER 4112351290BM. WITH A COMMITMENT DATE OF JUNE 09, 2025 AND A REVISION DATE OF JUNE 18, 2025. OUR OFFICE HAS REVIEWED THE FOLLOWING SURVEY RELATED EXCEPTIONS IN SCHEDULE B, PART II - EXCEPTIONS FROM COVERAGE:

(6) PLAT OF POMPANO INDUSTRIAL PARK THIRD ADDITION, RECORDED IN PLAT BOOK 111, PAGE 33; AS AFFECTED BY ORDINANCE NO. 85-13 RECORDED IN OFFICIAL RECORDS BOOK 12186, PAGE 70; AS AFFECTED BY ORDINANCE NO. 85-12 RECORDED IN OFFICIAL RECORDS BOOK 12186, PAGE 72; AS AFFECTED BY RESOLUTION NO. 85-1993 RECORDED IN OFFICIAL RECORDS BOOK 12654, PAGE 941; AS AFFECTED BY RE-RECORDED OF RESOLUTION NO. 85-1993 RECORDED IN OFFICIAL RECORDS BOOK 12670, PAGE 481; AS AFFECTED BY ORDINANCE NO. 95-25 RECORDED IN OFFICIAL RECORDS BOOK 23018, PAGE 932, OF THE PUBLIC RECORDS OF BROWARD COUNTY, FLORIDA, SETS FORTH THE FOLLOWING MATTERS: **AFFECTS THE SUBJECT PROPERTY, PLOTTABLE ITEMS SHOWN.**

A. DEDICATIONS AND RESTRICTIONS AS LISTED
B. UTILITY EASEMENTS
C. RIGHTS OF WAY AS SHOWN
D. PRIVATE LAKE
E. DRAINAGE EASEMENTS

(7) DECLARATION OF COVENANTS, CONDITIONS, RESTRICTIONS AND EASEMENTS, WHICH CONTAINS PROVISIONS FOR A PRIVATE CHARGE OR ASSESSMENTS, RECORDED IN OFFICIAL RECORDS BOOK 9669, PAGE 892; AS AFFECTED BY AMENDMENT TO DECLARATION OF COVENANTS, CONDITIONS AND RESTRICTIONS AND RESERVATION OF EASEMENTS FOR POWERLINE PARK RECORDED IN OFFICIAL RECORDS BOOK 12269, PAGE 623, BUT DELETING ANY COVENANT, CONDITION OR RESTRICTION INDICATING A PREFERENCE, LIMITATION OR DISCRIMINATION BASED ON RACE, COLOR, RELIGION, SEX, HANDICAP, FAMILIAL STATUS OR NATIONAL ORIGIN TO THE EXTENT SUCH COVENANTS, CONDITIONS OR RESTRICTIONS VIOLATE 42 USC 3604(C); **AFFECT THE SUBJECT PROPERTY, GRANTS EASEMENTS THAT ARE GENERAL IN NATURE, CONTAINS RESTRICTIONS.**

(8) **INTENTIONALLY DELETED PER SURVEY.**

(9) **INTENTIONALLY DELETED PER SURVEY.**

(10) EASEMENT, GRANTED FROM GREENWIN FLORIDA INVESTMENTS, A FLORIDA GENERAL PARTNERSHIP TO BROWARD COUNTY, A POLITICAL SUBDIVISION OF STATE OF FLORIDA, RECORDED IN OFFICIAL RECORDS BOOK 13744, PAGE 308; **AFFECTS THE SUBJECT PROPERTY, EASEMENT SHOWN.**

(11) **INTENTIONALLY DELETED PER SURVEY.**

(12) **INTENTIONALLY DELETED PER SURVEY.**

(13) **INTENTIONALLY DELETED.**

(14) UNRECORDED LEASE BETWEEN NCWPCS MPL 26 - YEAR SITE TOWER HOLDINGS LLC, A DELAWARE LIMITED LIABILITY COMPANY AND R/S ASSOCIATES OF FLORIDA, A PENNSYLVANIA LIMITED PARTNERSHIP AND THAT CERTAIN UNRECORDED LEASE, BY AND BETWEEN BELLSOUTH MOBILITY INC., A GEORGIA CORPORATION, LESSOR, AND NEXTEL SOUTH CORP., A GEORGIA CORPORATION, LESSEE, AS EVIDENCED BY THAT CERTAIN MEMORANDUM OF AGREEMENT, RECORDED IN OFFICIAL RECORDS BOOK 29699, PAGE 669; AS AFFECTED BY CORRECTED MEMORANDUM OF AGREEMENT FL1612 TRADEWINDS PARK, RECORDED IN OFFICIAL RECORDS BOOK 43412, PAGE 1296. **AFFECTS THE SUBJECT PROPERTY, EASEMENT SHOWN, LEASE AREA MAY AFFECT THE SUBJECT PROPERTY, TERMS OF LEASE AREAS MAY BE EXPIRED, LEASE AREAS SHOWN.**

(15) **INTENTIONALLY DELETED.**

(16) EASEMENT GRANTED TO FLORIDA POWER CORPORATION BY INSTRUMENT RECORDED IN OFFICIAL RECORDS BOOK 51036, PAGE 966; AS AFFECTED BY CONSENT TO EASEMENT RECORDED IN OFFICIAL RECORDS BOOK 51096, PAGE 1455; (AS TO EASEMENT PARCEL B) **AFFECTS AND BENEFITS THE SUBJECT PROPERTY, EASEMENT SHOWN.**

(17) EASEMENT GRANTED TO FLORIDA POWER & LIGHT COMPANY BY INSTRUMENT RECORDED IN OFFICIAL RECORDS BOOK 51096, PAGE 1440; **AFFECTS AND BENEFITS THE SUBJECT PROPERTY, EASEMENT SHOWN.**

(18) **INTENTIONALLY DELETED.**

(19) THE TERMS, PROVISIONS, AND CONDITIONS CONTAINED IN THAT CERTAIN NOTICE PURSUANT TO FLORIDA STATUTE SECTION 713.10, RECORDED IN INSTRUMENT NO. 117728270; **SUBJECT PROPERTY FALLS WITHIN THE LIMITS OF THE DOCUMENT.**

(20) **INTENTIONALLY DELETED.**

(21) RIPARIAN RIGHTS ARE NOT GUARANTEED OR INSURED. TITLE TO NO PORTION OF THE HEREIN DESCRIBED LAND LYING BELOW ORDINARY HIGH WATER MARK IS HEREBY INSURED.

(22) RIGHTS OF AMAZON.COM SERVICES LLC UNDER UNRECORDED PARKING LICENSE AGREEMENT(S).

(23) SURVEY PREPARED BY BOHLER DATED 3/18/2025, UNDER PROJECT NO. FLB250022.00-0A SETS FORTH THE FOLLOWING MATTERS:

a. NEXTEL TOWER AND LEASE SITE LOCATED ON PROPERTY. **SEE CURRENT SURVEY.**

UTILITIES:

THE FOLLOWING COMPANIES WERE NOTIFIED BY SUNSHINE 811 UTILITY SYSTEM (1-800-852-8057) AND REQUESTED TO MARK OUT UNDERGROUND FACILITIES AFFECTING AND SERVICING THIS SITE. THE UNDERGROUND UTILITY INFORMATION SHOWN HEREON IS BASED UPON THE UTILITY COMPANIES RESPONSE TO THIS REQUEST. SERIAL NUMBER(S): 115207823

UTILITY COMPANY	LOCATE STATUS	PHONE NUMBER
A T & T/ DISTRIBUTION	NO CONFLICT	(800) 778-9140
BROWARD COUNTY TRAFFIC ENGINEERING	MARKED	(954) 847-2642
BROWARD COUNTY WATER AND WASTEWATER SERVICES	MARKED	(954) 831-3258
CITY OF POMPANO BEACH WATER/SEWER	MARKED	(305) 412-0891 X103
COMCAST CABLE	NO CONFLICT	(800) 778-9140
CROWN CASTLE NG	CLEAR NO FACILITIES	(801) 364-1063
FLORIDA GAS TRANSMISSION	NO CONFLICT	(321) 288-8839
FLORIDA POWER & LIGHT - BROWARD FIBER	ON GOING JOB	(800) 778-9140
FLORIDA POWER & LIGHT- BROWARD	NO CONFLICT	(954) 321-2108
FLORIDA TURNPIKE ITS/ ELAND ENGINEERING INC	NO CONFLICT	(954) 678-3999
TECO PEOPLES GAS SOUTH FLORIDA	NO CONFLICT	(786) 910-9568

TO: COMMONWEALTH LAND TITLE INSURANCE COMPANY; FOUNDRY COMMERCIAL ACQUISITIONS, LLC, A FLORIDA LIMITED LIABILITY COMPANY; 33 NW 33RD ST INDUSTRIAL LLC, A FLORIDA LIMITED LIABILITY COMPANY; & CH REALTY X-FC I MIAMI FESTIVAL II, L.L.C.

THIS IS TO CERTIFY THAT THIS MAP OR PLAT AND THE SURVEY ON WHICH IT IS BASED WERE MADE IN ACCORDANCE WITH THE 2021 MINIMUM STANDARD DETAIL REQUIREMENTS FOR ALTA/NSPS LAND TITLE SURVEYS, JOINTLY ESTABLISHED AND ADOPTED BY ALTA AND NSPS, AND INCLUDES ITEMS 1, 2, 3, 4, 5, 6(A), 7(A), 7(B1), 7(C), 8, 9,10, 11(A), 13, 14, 16, 17, & 19 OF TABLE A THEREOF. THE FIELD WORK WAS COMPLETED ON FEBRUARY 25, 2025.

COLLIN WOODYARD License Number LS7423 STATE OF FLORIDA Professional Surveyor and Mapper

Digitally signed by Collin Woodyard
DN: E=cwoodyard@bohlereng.com, CN=Collin Woodyard, O="BOHLER ENGINEERING FL, LLC", L=Boca Raton, S=Florida, SERIAL.NUMBER=MAS20250909482896, C=US
Date: 2025.12.18 13:21:22-05'00'

COLLIN WOODYARD
PROFESSIONAL SURVEYOR AND MAPPER NO. LS7423
DATE

THIS CERTIFICATION IS MADE TO ONLY NAMED PARTIES FOR PURCHASE AND/OR MORTGAGE OF HEREIN DELINEATED PROPERTY BY THE NAMED PURCHASER. NO RESPONSIBILITY OR LIABILITY IS ASSUMED BY SURVEYOR FOR THE USE OF SURVEY FOR ANY OTHER PURPOSE INCLUDING, BUT NOT LIMITED TO, USE OF SURVEY AFFIDAVIT, RESALE OF PROPERTY, OR TO ANY OTHER PERSON NOT LISTED IN CERTIFICATION, EITHER DIRECTLY OR INDIRECTLY.

BOHLER
SITE CIVIL AND CONSULTING ENGINEERING
LAND SURVEYING
PROGRAM MANAGEMENT
LANDSCAPE ARCHITECTURE
ENVIRONMENTAL SERVICES
PERMITTING SERVICES
TRANSPORTATION SERVICES

THE DESIGN, IDEAS AND CONCEPTS OF THIS PLAN ARE PROPRIETARY AND SHALL NOT BE EXPOSED OR USED FOR ANY PURPOSE WITHOUT THE EXPRESS WRITTEN AUTHORIZATION FROM BOHLER. ONLY APPROVED, SEALED PLANS SHALL BE UTILIZED FOR CONSTRUCTION PURPOSES.
© 2025 BOHLER

REVISIONS

REV	DATE	COMMENT	DRAWN BY / CHECKED BY
1	04/11/2025	ADDED TREE INFORMATION	C.W.
2	04/21/2025	UPDATED TITLE INFORMATION & NOTES	S.M. / C.W.
3	05/21/2025	UPDATED TITLE COMMITMENT	C.W.
4	06/19/2025	UPDATED TITLE COMMITMENT	S.M. / C.W.

PROJECT No.:	FLB250022.00-4A
DRAWN BY:	A.S.
CHECKED BY:	P.D.
DATE:	03/18/2025
CAD I.D.:	S-ALTA-SURV
FIELD DATE:	02/25/2025
CREW CHIEF:	J.V.
APPROVED:	C.W.

KNOW WHAT'S BELOW ALWAYS CALL 811 BEFORE YOU DIG
It's fast. It's free. It's the law.
www.callsunshine.com

PROJECT:

ALTA/NSPS LAND TITLE SURVEY

FOR

FOUNDRY COMMERCIAL ACQUISITIONS, LLC

NW 33RD STREET
CITY OF POMPANO BEACH
BROWARD COUNTY, FLORIDA

BOHLER
1900 NW CORPORATE BOULEVARD
SUITE 101E
BOCA RATON, FLORIDA 33431
Phone: (561) 571-0280
Fax: (561) 571-0281
FLORIDA BUSINESS CERT. OF AUTH. No. LB#8085

200 100 50 0 200
1"= 200'

SHEET NUMBER
1
OF 5

PZB
PZ25-12000043
05/27/2026

REVISION 4 - 06/19/2025

H:\2025\FLB250022.00\SURVEY\CAD\DRAWINGS\SURVEY\S-ALTA-SURV-FLB250022.00-4A-----LAYOUT SHEET 1
BSM