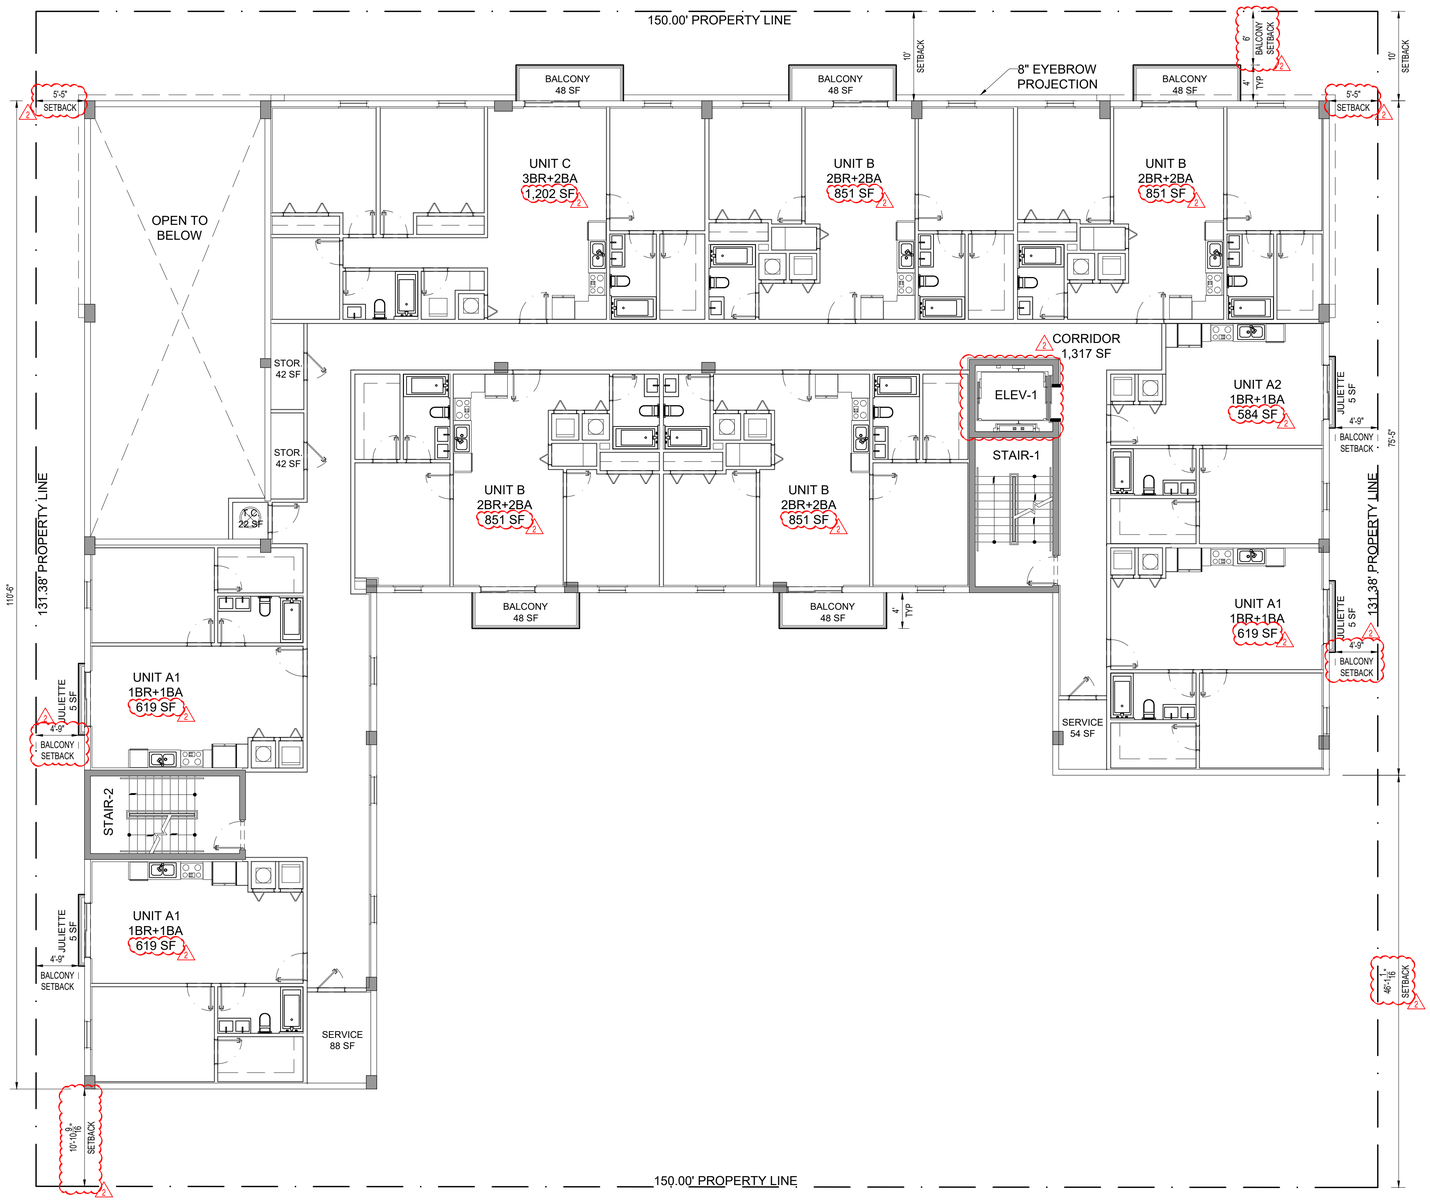

2ND FLOOR PLAN

Scale: 1/8"=1'-0"

DRC

PZ22-12000032

04/02/2025

flux architects

Design
Planning
Architecture

66 W. FLAGLER ST. #900
MIAMI, FL 33130
www.thefluxarchitects.com
P: 305.707.8288

Seal of Project Architect

Eddie A. Seymour
2025.02.22 13:29:30 -05'00'

Consultants:
CIVIL ENGINEER
CONENCO CONSULTANTS
782 NW 42ND AVE
MIAMI, FL 33126
T: (888) 536-1536

LANDSCAPE ARCHITECT
PARAMETRIKA LANDSCAPE ARCH.
T: (480) 732-5637

Project Owner:
LOGICA REAL ESTATE SERVICES
8180 NW 36th ST, STE 409
DORAL, FL 33166

Project:
324 HAUS

Project Address:
324 NW 6th ST.
POMPANO BEACH, FL 33060

Project Number:
24012

Sheet Name:
2ND FLOOR PLAN

Sheet Origin Date:
04/24/2024

Sheet Issue Date:
12/18/2024

Revisions:

No.	Description	Date
01	COMMENTS/CHANGES	09/10/2024
02	COMMENTS	12/18/2024

Submittal Type:
SITE PLAN REVIEW

Drawn By:
ES

Checked By:
ES

Scale:
AS SHOWN

Sheet Number:
A102