EXTERIOR ELEVATION NOTES

1. BUILDING IS PROPOSED TO BE A PREFABRICATED METAL BUILDING.

KEYNOTES

#	NOTE
1	POSSIBLE LOCATION FOR AIR CONDITIONER CONDENSER UNIT. SEE MECHANICAL.

EXTERIOR MATERIALS

MARK	DESCRIPTION	COMMENTS
EM-1	ROOF DECK	GALVANIZED METAL ROOF PANELS – WHITE FINISH
EM-2	STRUCTURAL WALL	STEEL WALL PANEL SYSTEM BY TUBULAR BUILDING SYSTEMS (WALL PANEL FINISHES: HAWAIAN BLUE & TRIM FINISHES: WHITE, LIGHT FIXTURES: WHITE)
EM-3	DOWNSPOUT	
EM-4	GUTTER	
EM-5	EYEBROW ABOVE DOOR	5'-4"W X 4'-0"D CUSTOM "T-TOP AWNING W/ CANVAS TOP"

COLOR SAMPLES OF BUILDING FINISHES

HAWAIIAN BLUE

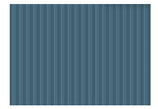

POLAR WHITE

1 EAST ELEVATION
1/4" = 1'-0"

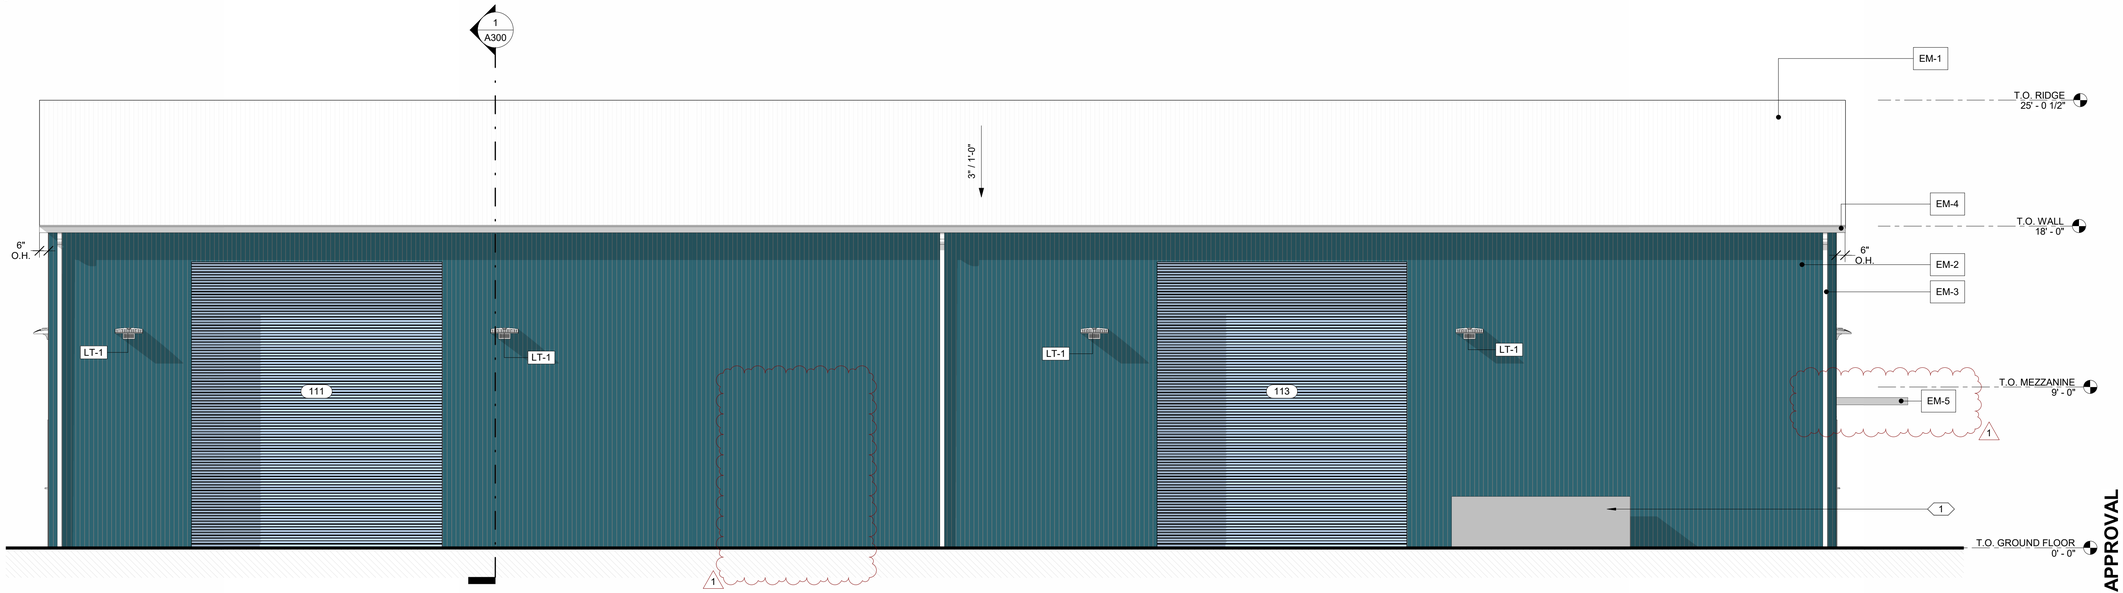

2 WEST ELEVATION
1/4" = 1'-0"

DRC

PZ25-12000024

09/17/2025

5 ARCHITECTURE

33 SE 4TH STREET, SUITE 100
BOCA RATON, FL 33432
561.835.5515

WWW.5ARCHITECTURE.COM
AA26003746

SEAL:

STATE OF FLORIDA
MATTHEW R. FORGET
AR95364
REGISTERED ARCHITECT

MATTHEW R. FORGET // REG. FL NO. AR95364

DIGITAL SIGNATURE:

Matthew Forget

Digitally signed by Matthew Forget
DN: cn=Matthew Forget, o=5 ARCHITECTURE, ou=A01410D000001B5A9374A0B900005582, email=matthew@5architecture.com, c=US
Reason: I am approving this document
Date: 2025.08.12 09:18:54-04'00'

CLIENT / PROJECT ADDRESS:

HODGE MARINE

1857 NW 21ST STREET
POMPANO BEACH, FLORIDA 33069

REVISIONS:

NO.	DATE	DESCRIPTION
1	2025-08-12	DRC PLAN REVIEW

KEY PLAN:

SITE PLAN APPROVAL

PROJECT NUMBER: 24-057

DATE ISSUED: 2025-06-30

SHEET TITLE:

EXTERIOR ELEVATIONS

SHEET NO.:

A201

...Desktop\Hodge Marine_24-057_Hodge Marine_R25.rvt
© 2025 5 ARCHITECTURE