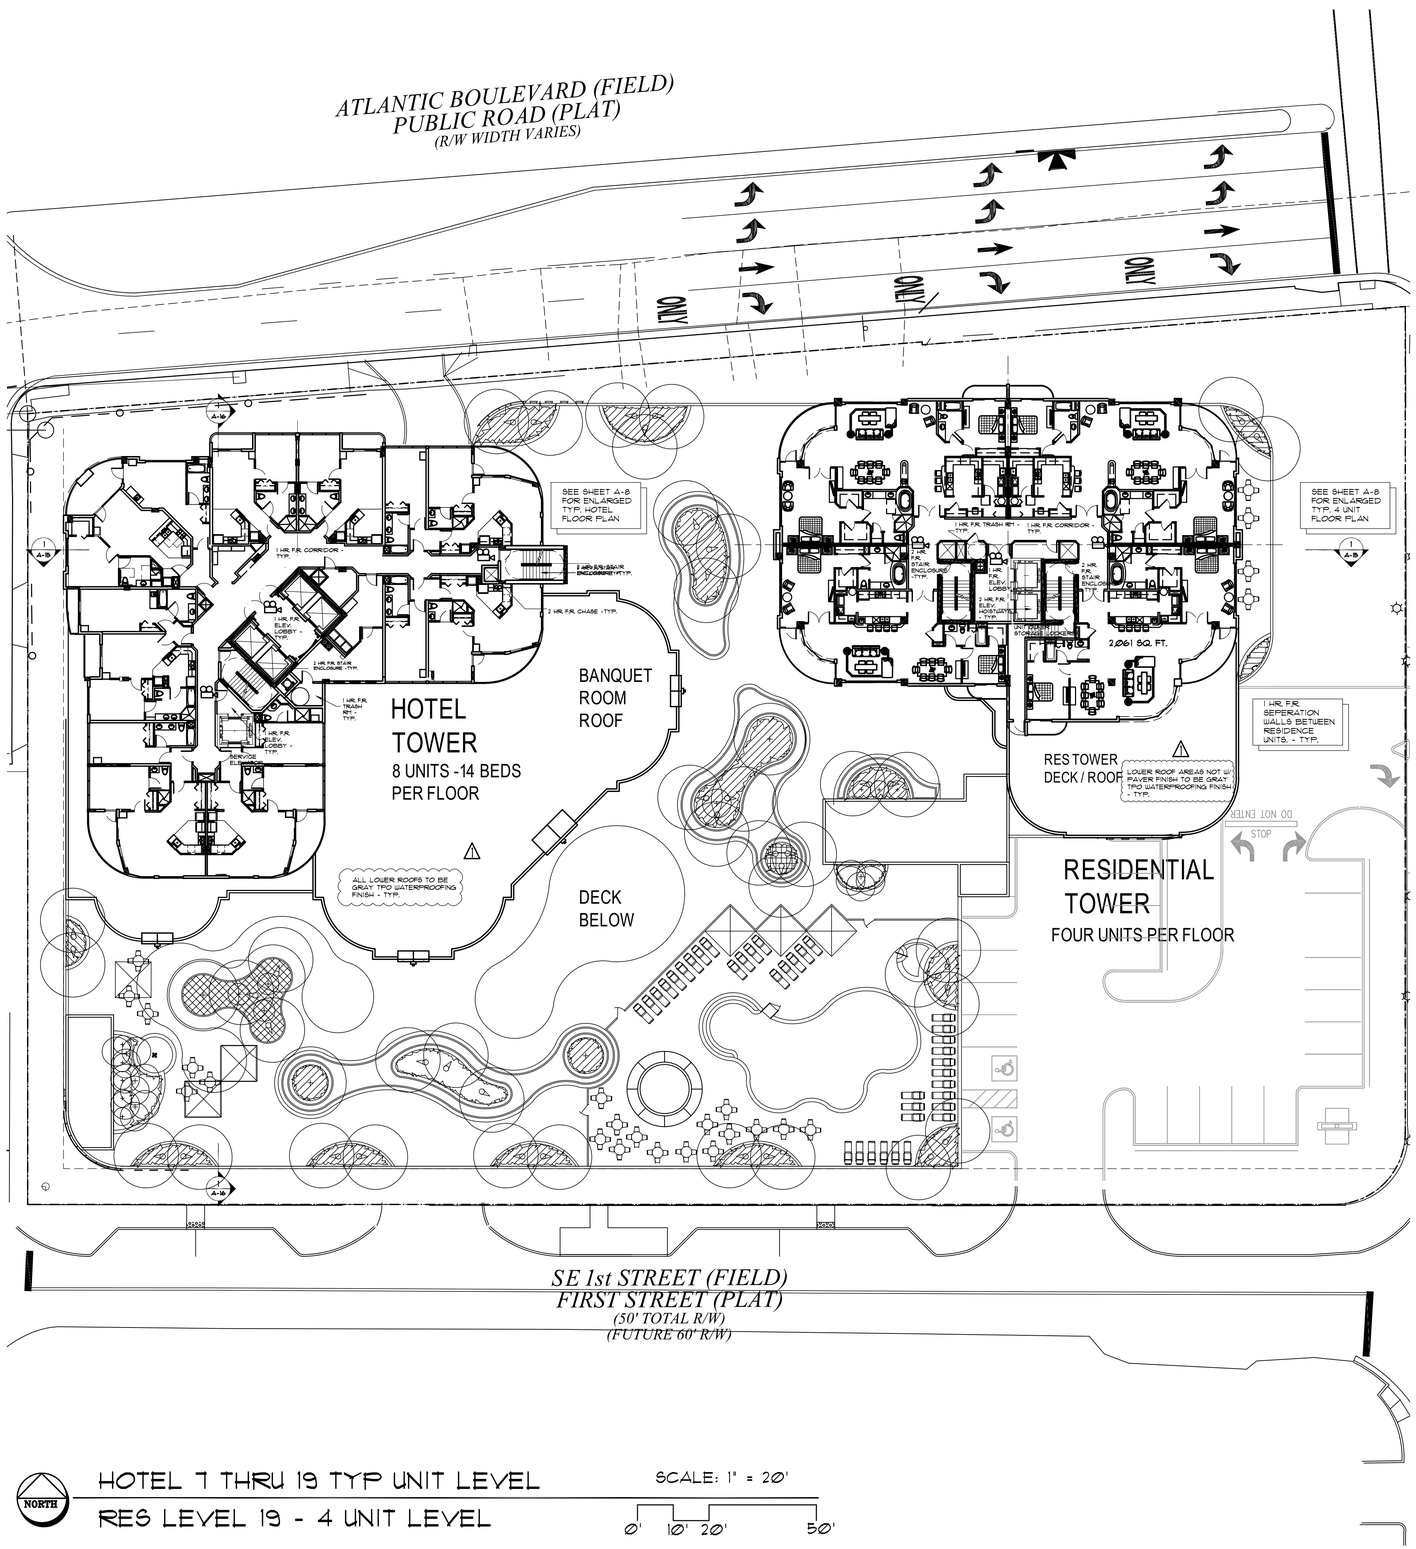

HOTEL 7 THRU 19 TYP UNIT LEVEL
RES LEVEL 19 - 4 UNIT LEVEL

SCALE: 1" = 20'

0' 10' 20' 50'

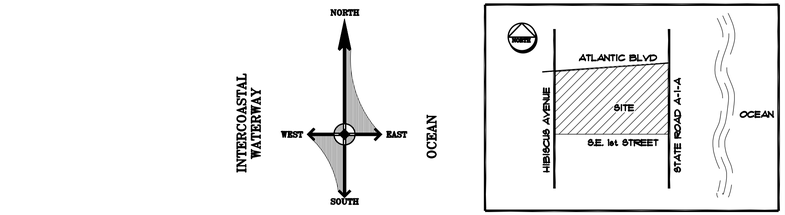

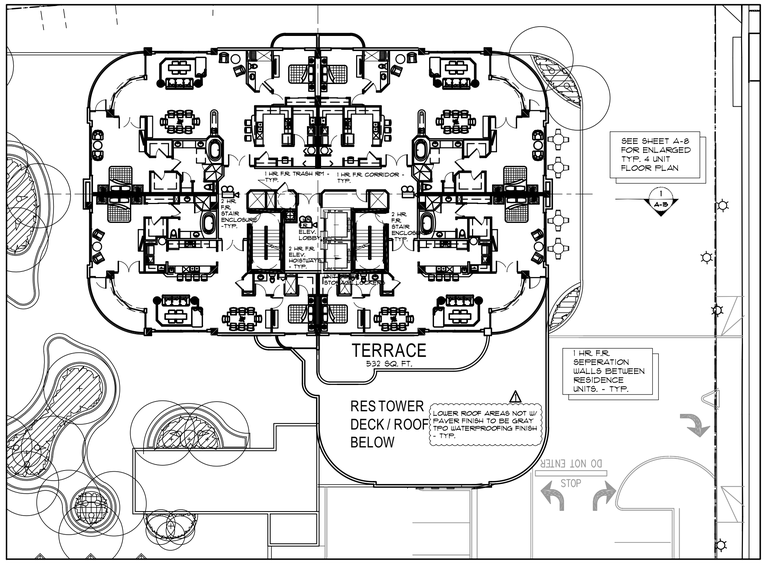

RES LEVEL 20 - 4 UNIT LEVEL

SCALE: 1" = 20'

0' 10' 20' 50'

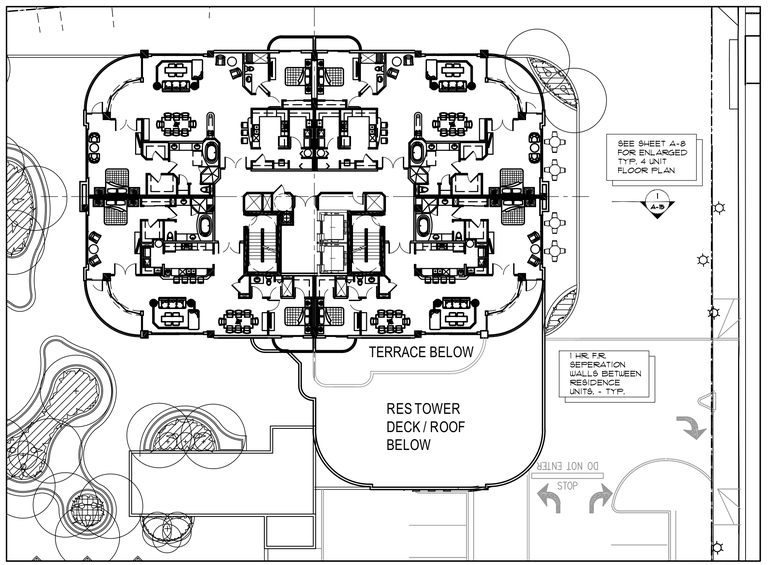

RES LEVEL 21 - 4 UNIT LEVEL

SCALE: 1" =

0' 10' 20' 50'

AS INSTRUMENTS OF SERVICE, ALL DRAWINGS, SPECIFICATIONS, AND COPIES THEREOF FURNISHED BY THE ARCHITECT ARE TO BE USED ONLY FOR THIS PROJECT AND NOT TO BE USED ON ANY OTHER PROJECTS. THESE DOCUMENTS ARE NOT VALID UNLESS SIGNED AND SEALED BY THE ARCHITECT OR ENGINEER. CHANGES TO THE DRAWINGS MAY ONLY BE MADE BY THE ARCHITECT OR ENGINEER. BY USE OF THE DRAWING FOR CONSTRUCTION OF THE PROJECT, THE OWNER REPRESENTS THAT THEY HAVE REVIEWED AND APPROVED THE DRAWINGS, AND THAT THE CONSTRUCTION DOCUMENT PHASE OF THE PROJECT IS COMPLETE. THE CONTRACTOR REPRESENTS THAT HE HAS VISITED THE SITE, FAMILIARIZED HIMSELF WITH THE LOCAL CONDITIONS, VERIFIED FIELD DIMENSIONS, AND CORRELATED HIS OBSERVATIONS WITH THE REQUIREMENTS OF THE CONTRACT DOCUMENTS. NOTIFY ARCHITECT PRIOR TO START OF THE WORK OF DISCREPANCIES FOUND AND REQUEST CLARIFICATION. DO NOT SCALE THE DRAWINGS. MINIMUM FEE OF $100 FOR UNAUTHORIZED "AS-BUILT" FIELD CHANGES.

BERRIE Architecture & Design, Inc.
2301 W SAMPLE RD., STE. 5-7C
POMPANO BEACH, FL 33073
Phone (954) 928-0635
E-MAIL berrie@berriedesign.com
FL LIC. #AA0002741

Project Name
ATLANTIC 3350
3350 E. ATLANTIC BLVD
POMPANO BEACH, FLORIDA, 33062
Sheet Title
PRELIMINARY SITE PLAN DESIGN
RES 18-21 - 4 TYP UNIT LEVEL

Prog./Rev.
SITE PLAN EXT.
of DEV. ORDER
No. 12-12000003
DATED 10/24/12
PAM COMMENTS
⚠ 4/17/20

Richard Berrie VP
Digitally signed by Richard Berrie VP
Date: 2020.04.29 09:02:53 -04'00'

Scale 1"=20'-0"
Job No.
Drawn By RB
Date 01/ /20
Sheet No. A-7
Drawing No. 002-A7.DWG
Revisions

P&Z
PZ20-12000005
2/24/2021